
B-243

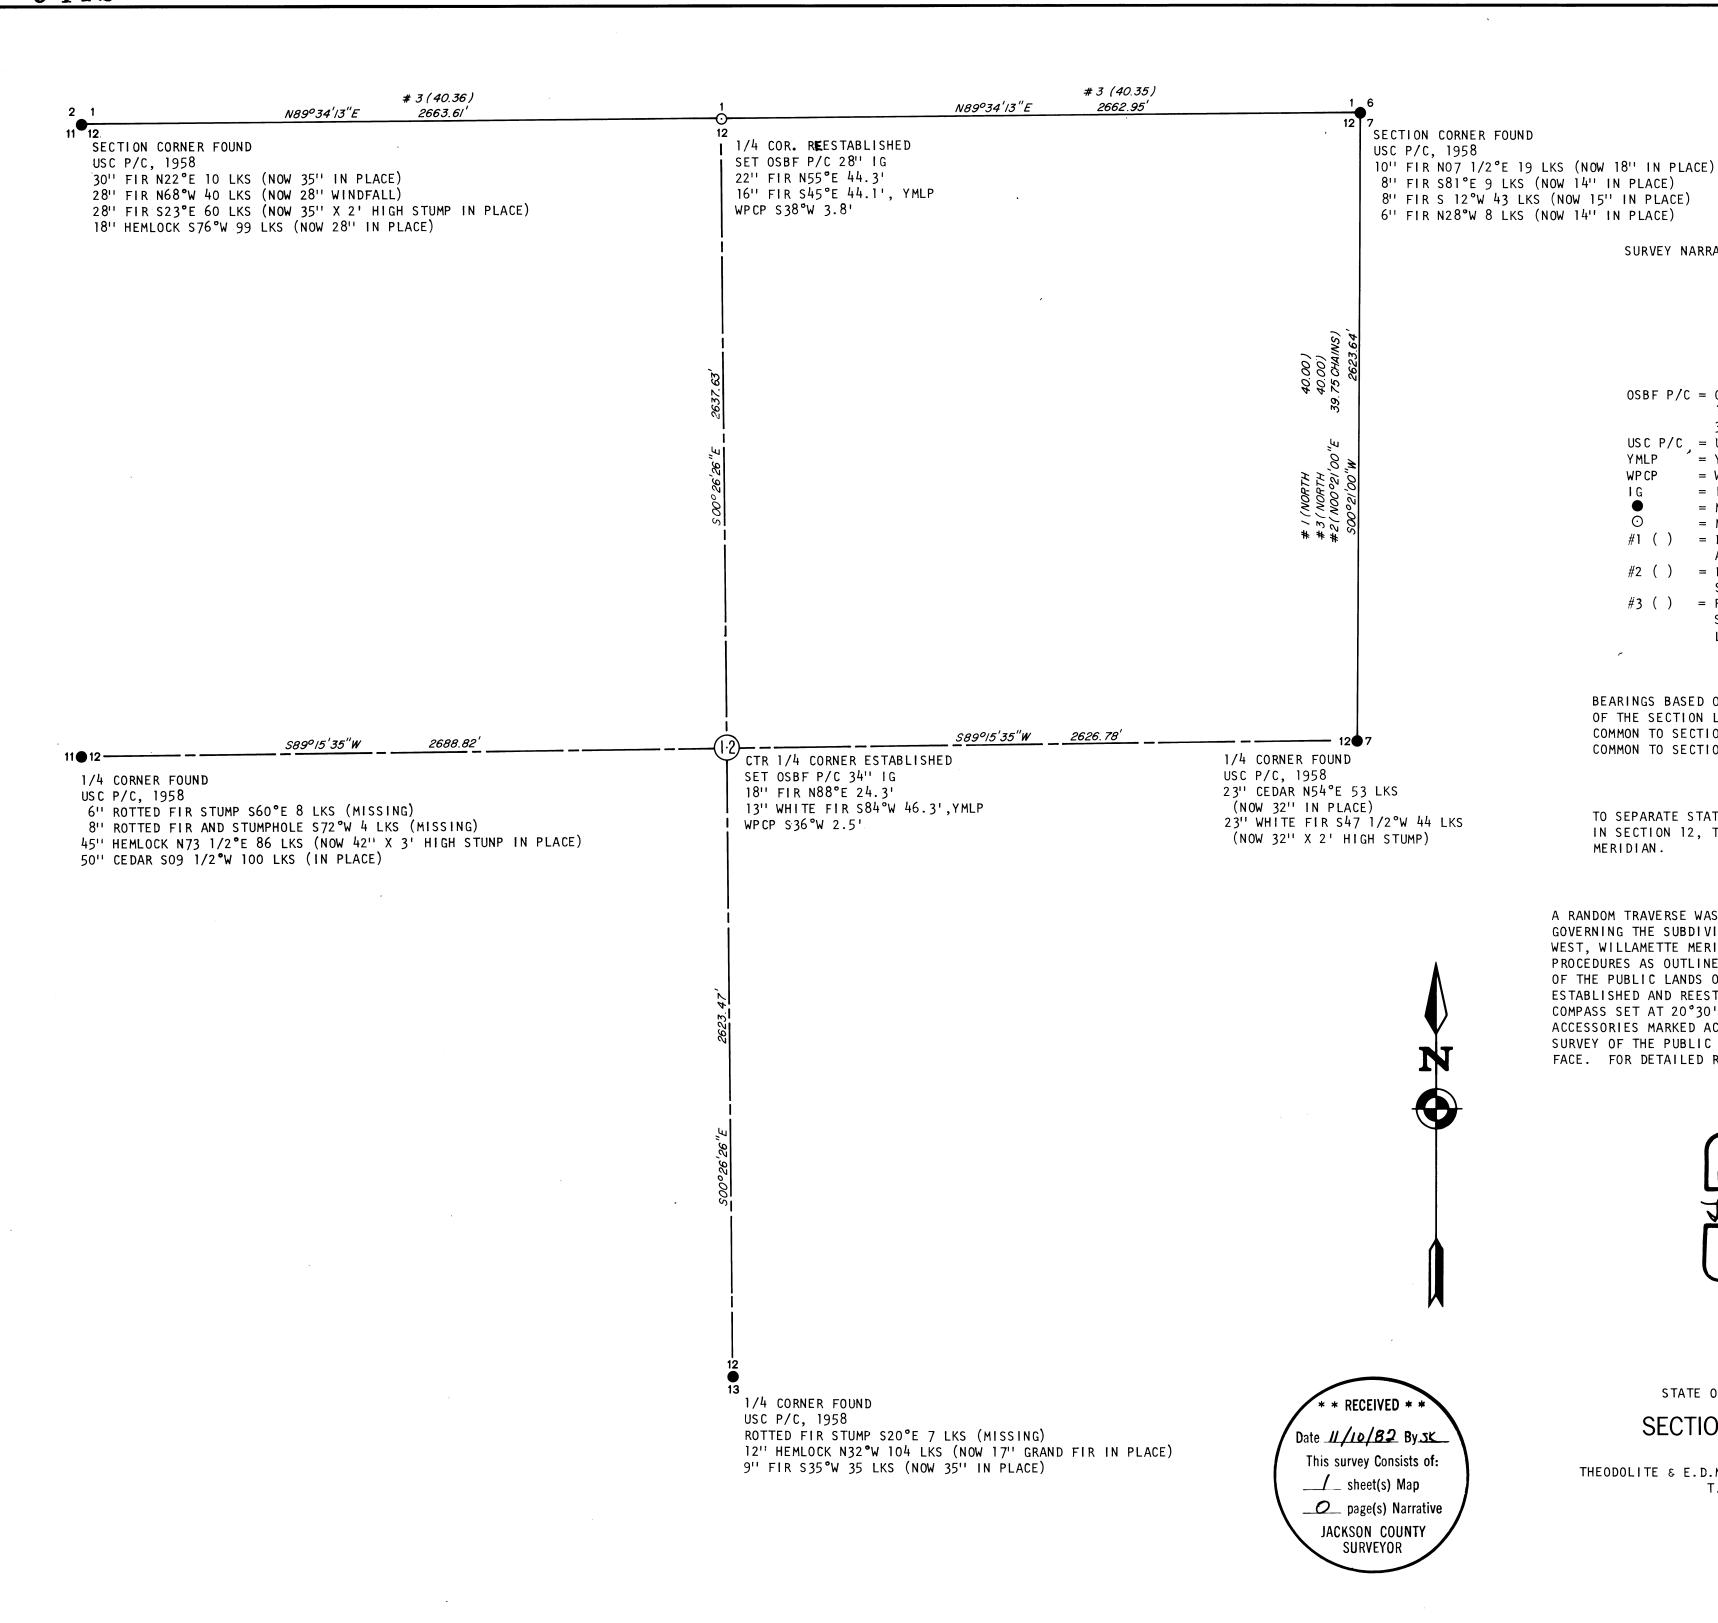

LEGEND

SURVEY NARRATIVE TO COMPLY WITH PARAGRAPH 209.250 OREGON REVISED STATUTES

OSBF P/C = OREGON STATE DEPARTMENT OF FORESTRY 1 1/2" X 36" ALUMINUM PIPE WITH

USC P/C = UNITED STATES CADASTRAL PIPE AND CAP YMLP = YELLOW METAL LOCATION POSTER

3 3/4" ALUMINUM CAP

WPCP = WHITE PAINTED CEDAR POST

■ IN GROUND
■ MONUMENTS FOUND
○ MONUMENTS SET

= MONUMENTS SET
() = RECORD BEARINGS AND DISTANCE (MC KENZEI

AND ECKELSON, 1879 CONTRACT NO. 328)
#2 () = RECORD BEARINGS AND DISTANCES (UNITED

STATES CADASTRAL) 1958

#3 () = RECORD BEARINGS AND DISTANCE (RUFUS S. MOORE, 1884 RESURVEY AND SUBDIVISIONAL LINES, CONTRACT NO. 504)

BASIS OF BEARING

BEARINGS BASED ON THE 1958 UNITED STATES CADASTRAL SURVEY OF THE SECTION LINE BETWEEN THE ONE QUARTER CORNER COMMON TO SECTIONS 7 ND 12 AND THE SECTION CORNER COMMON TO SECTIONS 1, 6, 7, AND 12.

PURPOSE

TO SEPARATE STATE FOREST LANDS AND PRIVATE LANDS LOCATED IN SECTION 12, TOWNSHIP 33 SOUTH, RANGE 3 WEST, WILLAMETTE MERIDIAN.

PROCEDURE

A RANDOM TRAVERSE WAS USED TO CONNECT THE CONTROLLING CORNERS GOVERNING THE SUBDIVISION OF SECTION 12, TOWNSHIP 33 SOUTH, RANGE 3 WEST, WILLAMETTE MERIDAN. THIS SECTION WAS SUBDIVIDED USING THE PROCEDURES AS OUTLINED IN THE "MANUAL OF INSTRUCTIONS FOR THE SURVEY OF THE PUBLIC LANDS OF THE U.S." BEARINGS TO ACCESSORIES FOR ESTABLISHED AND REESTABLISHED CORNERS WERE TAKEN WITH A STAFF COMPASS SET AT 20°30' EAST MAGNETIC DECLINATION. NEW CORNERS AND ACCESSORIES MARKED ACCORDING TO "MANUAL OF INSTRUCTIONS FOR THE SURVEY OF THE PUBLIC LANDS OF THE U.S." DISTANCE MEASURED TO BT FACE. FOR DETAILED REPORT ON FOUND CORNERS SEE COUNTY RECORDS.

SURVEYED BY:

REGISTERED
PROFESSIONAL
LAND SURVEYOR

COREGON
JULY 22, 1977
LLOYD D. SMITH
1101

LLOYD D. SMITH 300 5TH STREET, BAY PARK COOS BAY, OREGON

SURVEY FOR:

STATE OF OREGON - DEPARTMENT OF FORESTRY

SECTION 12, T.33S., R.3W., W.M.

THEODOLITE & E.D.M. SURVEY BY: LLOYD D. SMITH, J. MC INTOSH
T. VAN VLEET AND A. KOREIVA
DRAWN BY: A. KOREIVA
OCTOBER 11, 1982

SCALE: 1"=400"

B-243 FB 10/18/82