


LEGEND

- FOUND JACKSON COUNTY OR BLM BRASS CAP
- ▲ FOUND BRASS CAP RESET BY DONALD BRANCH, C. S. 9363
- ⊕ FOUND BRASS CAP SET BY DAVID PAOLI, C.S. 8997.
- PROPERTY LINE REPOSTED AND REBLAZED THIS SURVEY.
- SECTION LINE AND SECTIONAL SUBDIVISION LINE.

REFERENCES

REFER TO COUNTY SURVEYS 9363 AND 8596 BY DONALD BRANCH, AND C.S. 8997 BY MYSELF FOR A HISTORY OF SURVEYS, FOUND MONUMENT DATA, AND OTHER INFORMATION. WHAT HAPPENED WAS: EVIDENCE WAS FOUND WHICH INFLUENCED MR. BRANCH TO MOVE SEVERAL CORNERS HE HAD PREVIOUSLY SET, WHICH IN TURN CONTROLLED A LINE I HAD POSTED.

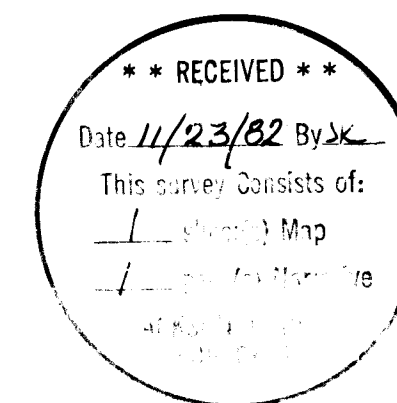

**AMENDED SURVEY
FOR
U. S. FOREST SERVICE
NE 1/4 SECTION 32
T32S, R4E, W. M.
JACKSON COUNTY, OREGON
OCTOBER, 1982**

CERTIFICATE OF SURVEY

I, DAVID E. PAOLI, A REGISTERED LAND SURVEYOR IN THE STATE OF OREGON, HEREBY CERTIFY THAT THIS PLAT AND THE NOTES HEREON OR ATTACHED, ARE A CORRECT REPRESENTATION OF A SURVEY I PERFORMED DURING OCTOBER, 1982, FOR THE U.S. FOREST SERVICE, IN ACCORDANCE WITH THE STATUTES OF THE STATE OF OREGON AND THE ARTICLES OF MY CONTRACT.

REGISTERED
PROFESSIONAL
LAND SURVEYOR

David E. Paoli

OREGON
SEPTEMBER 23, 1877
DAVID E. PAOLI
1288

EXAMINED AND ACCEPTED FOR THE U.S. FOREST SERVICE THIS 19th DAY OF NOVEMBER
Donald J. G. - C.O.R.

9456

SURVEY NARRATIVE TO COMPLY WITH PARAGRAPH 209.250

OREGON REVISED STATUTES

Survey For: Rogue River National Forest
P.O. Box 520
Medford, Oregon 97501

Location: Section 32, Township 32 South, Range 4 East, Willamette
Meridian, Jackson County, Oregon.

Contract No: 40-04N7-2-945

Purpose: To correct posting and blazing on the boundary between
National Forest and private lands in the Northeast quarter
of Section 32.



Basis of Bearing: Line between $\frac{1}{2}$ corner common to Sections 29 and
32, and E $\frac{1}{16}$ corner common to Sections 29 and 32 as
established by Donald Branch (PLS 1137) Survey No. 8596.
Although the E $\frac{1}{16}$ corner has been moved in a subsequent
survey, my 1981 traverse points were located. Their
bearings were tied to this earlier survey.

Procedure: I was able to locate traverse points used in my 1981
survey, C.S. 8997. From these points I tied to the
relocated E $\frac{1}{16}$ corner. Major equipment used was a Topcon
20" theodolite and 200 foot steel tape.

Based on my 1981 work, I was able to calculate the new
position of the E $\frac{1}{16}$ corner, and the true line between it
and the CE $\frac{1}{16}$ corner I set in 1981.

Using my 1981 traverse points along line, I offset from the
traverse points to true line, moved the property line posts,
and corrected the blazes.

Dated: October 22, 1982
David E. Paoli, PLS 1289
P.O. Box 737
Fort Bragg, CA 95437

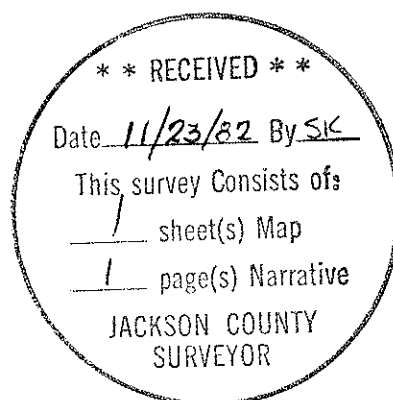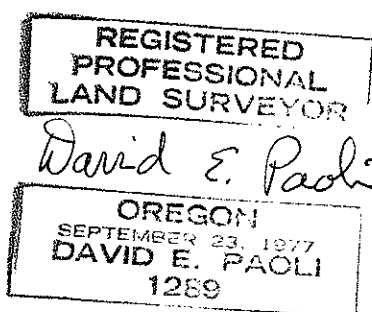

32 4E