


Boundary Line Adjustment Plat
 For Houston Bush
 S.E. 1/4 of Sec. 33, T37S., R.2W., W.M.
 Jackson County, Oregon
 September 30, 1982

REGISTERED
PROFESSIONAL
 LAND SURVEYOR

Verlyn Thomas
 OREGON
 MAY 13, 1960
 VERLYN D. THOMAS
 505

**** RECEIVED ****
 Date 1/4/83 By SK
 This survey consists of:
 / sheet(s) Map
 / page(s) Narrative
 JACKSON COUNTY
 SURVEYOR

See Survey No. 5179

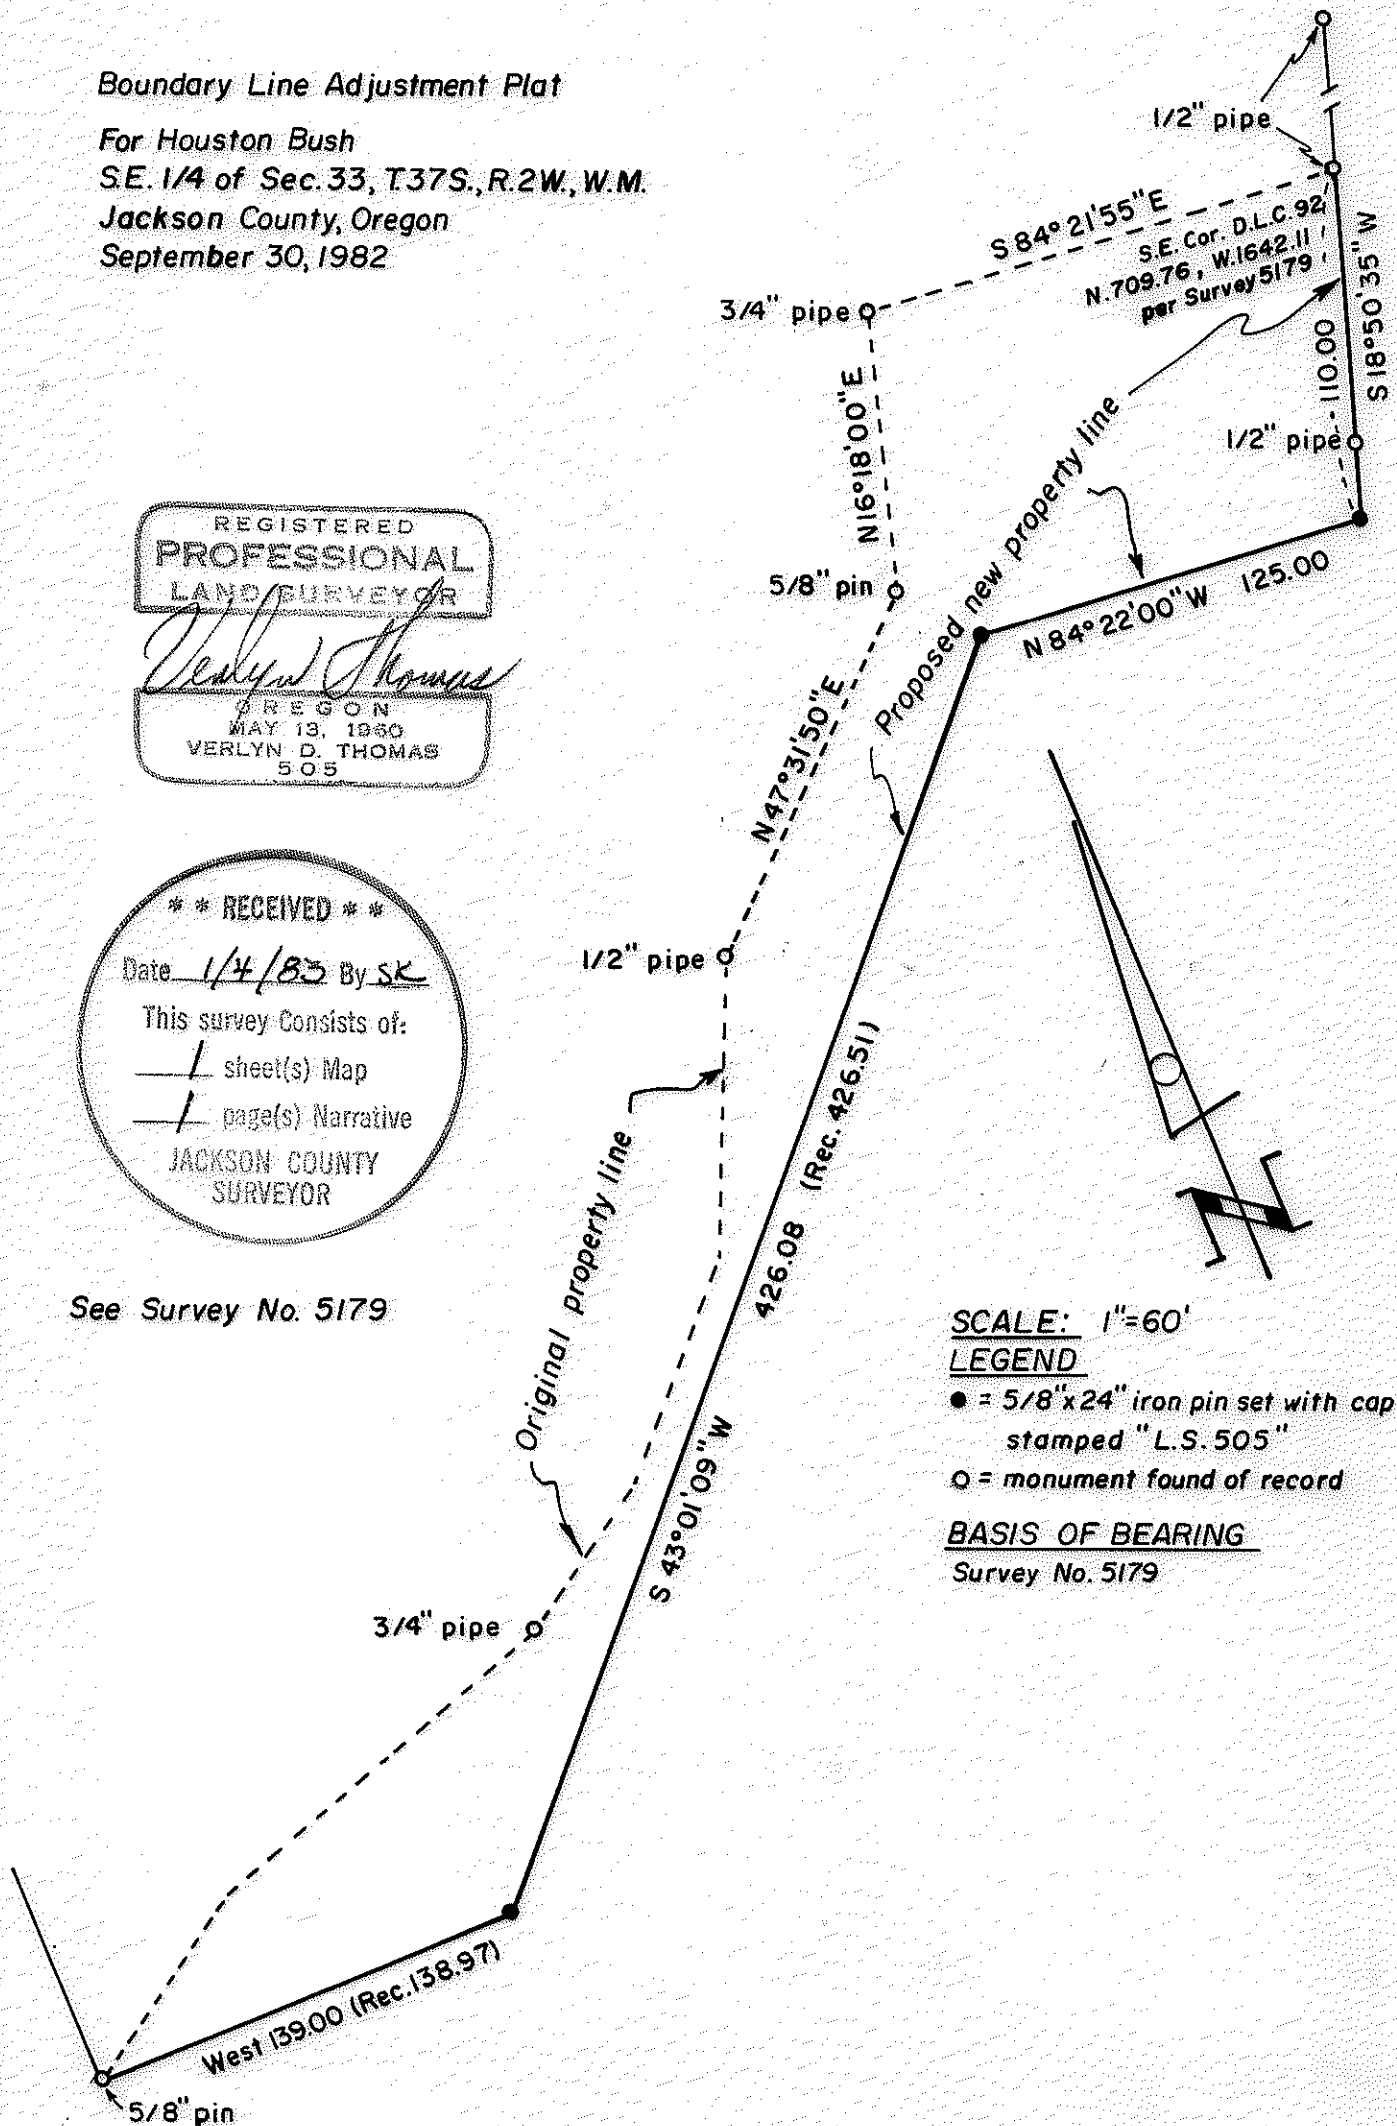

SCALE: 1" = 60'

LEGEND

- = 5/8" x 24" iron pin set with cap stamped "L.S. 505"
- = monument found of record

BASIS OF BEARING

Survey No. 5179


9492

9492

SURVEY NO. 9492

SURVEY NARRATIVE TO COMPLY WITH O.R.S. 209.250

For: Houston Bush
c/o Larry Denn Construction
1459 Highcrest Drive
Medford, OR 97501

Purpose: To survey and monument a proposed property line as directed by the client's representative.

Procedure: Retraced the easterly line of Survey No. 5179, and established proposed property line as indicated on the accompanying plat.
Prepared appropriate legal description for client.

