

NOTE: Section not subdivided in this survey.

* * RECEIVED * *

Date 1/3/83 By SK

This survey consists of:

1 sheet(s) Map

1 page(s) Narrative

JACKSON COUNTY
SURVEYOR

<p>REGISTERED PROFESSIONAL LAND SURVEYOR</p> <p><i>Darrel W. Edwards</i></p> <p>OREGON JULY 6, 1969 DARREL W. EDWARDS 741</p>	SURVEY FOR: DODSON & McCARTNEY	
	LOCATION: NE 1/4 Section 24, T. 35 S., R. 4 W. W. M., Jackson County, Ore.	
	Date: 9-30-82	Scale: 1" = 200'
	<input checked="" type="radio"/> Monuments Found	
	<input type="radio"/> 5/8" x 30" Steel Pin	
<input type="checkbox"/> Record Measurement		
Basis of bearing: Unrecorded B.L.M. Survey		

35 4W 24

SURVEY NO. 9493

SURVEY NARRATIVE TO COMPLY WITH PARAGRAPH 209.250, OREGON REVISED STATUTES.

SURVEY FOR: Dodson and McCartney
2949 W. Main Street
Medford, Ore. 97501

LOCATION: Northeast 1/4 of Section 24, T. 35 S., R. 4 W. W. M.,
Jackson County, Oregon.

PURPOSE: Establish East 1/16 corner of Section 24 and run a line South
for a boundary line agreement. Section not subdivided at this
time. Set 5/8" by 30" steel pins with plastic caps stamped "DW
EDWARDS LS 741" as shown on the accompanying plat.



PROCEDURE: Found BLM Brass Caps set in 2" iron pipes. Set 5/8" by 30"
steel pins with plastic caps stamped DW EDWARDS LS 741" as
shown on accompanying plat.

EQUIPMENT: Lietz TM 20-C and Lietz Red-1 EDM.

BASIS OF BEARINGS: Unrecorded BLM survey.

DATE COMPLETED: 9-30-82

Darrel W. Edwards
P. O. Box 801
Rogue River, Ore. 97537
Phone 582-3110

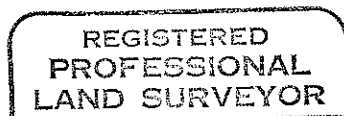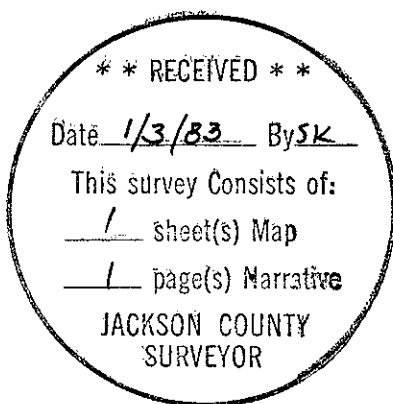

Darrel W. Edwards

