



FD. G.L.O. BRASS CAP
MARKING THE N.1/4
CORNER SECTION 2.

FD. G.L.O. BRASS CAP
MARKING THE N.E.
CORNER SECTION 2.

N 89° 59' 51" E
2610.62'

N 03° 31' 57" E
2559.76'

N 03° 06' 00" E
2602.56' REC.=2602.8'

S 89° 59' 41" E
2512.72'

S 89° 59' 41" E
2672.58'

FD. ORIGINAL STONE
MARKING THE W.1/4
CORNER SECTION 2.

FD. PIPE MARKING
THE E.1/4 CORNER
SECTION 2 AS PER
SURVEY NO. 4180.

C.1/4 SEC. 2

B.C.C.

N 03° 31' 57" E
2591.02'

FD. B.L.M. BRASS CAP
MARKING THE S.1/4
CORNER SECTION 2.

REGISTERED
PROFESSIONAL
LAND SURVEYOR

Lloyd R. Moffitt

OREGON
JULY 17, 1970
LOYD R. MOFFITT
944

** RECEIVED **
Date 2/1/83 By SK
This survey Consists of:
1 sheet(s) Map
2 page(s) Narrative
JACKSON COUNTY
SURVEYOR

LEGEND:

- = FOUND MONUMENT AS SHOWN.
- = SET 5/8" IRON PIN WITH PLASTIC CAP STAMPED, MOFFIT PLS 944.
- = BLAZED TREES AND TAGGED PROPERTY LINE.

BASIS OF BEARINGS:
SURVEY NO. 4180.

PLAT OF SURVEY
FOR
BOISE CASCADE CORPORATION

BEING A PORTION OF SECTION 2,
TOWNSHIP 32 SOUTH, RANGE 1 EAST, W.M.
JACKSON CO. SCALE: 1"=1000'
OREGON DATE: JAN., 1983
PREPARED BY: FRIAR-MOFFIT AND ASSOC.
MEDFORD, OREGON



SURVEY NO. 9514

SURVEY NARRATIVE TO COMPLY WITH O.R.S. 209.250 (CONT)

Distances to the bearing trees were measured to the center of the tree at the BT scribe.

DATE: January, 1983

FRIAR-MOFFIT & ASSOCIATES
717 West 10th, Suite 1
Medford, OR 97501
Phone: 503-772-2782

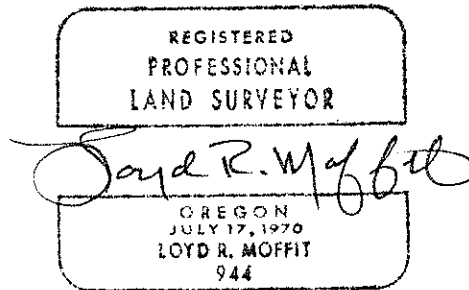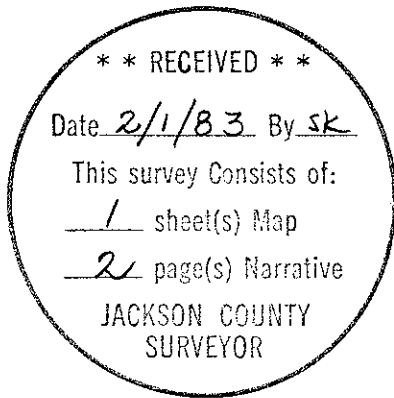

SURVEY NARRATIVE TO COMPLY WITH O.R.S. 209.250

SURVEY FOR: Boise Cascade Corporation
Southern Oregon Region
P.O. Box 100
Medford, OR 97501

LOCATION: A portion of Section 2, Township 32 South,
Range 1 East, Willamette Meridian, Jackson
County, Oregon.

PURPOSE: To survey, establish and mark the Boise
Cascade Corporation's property lines as
shown on the attached map.

PROCEDURE: Traverses were run to the four one-quarter
(1/4) section corners and the Northeast
corner of said Section 2. Next a mathe-
matical position was computed for the
position of the center one-quarter (1/4)
of Section 2. Then a traverse was run
from the East one-quarter (1/4) corner
to the center one-quarter (1/4) corner
to the South one-quarter (1/4) corner.
The Boise Cascade Corporation's property
lines were marked with a combination of
blazed and painted trees, and tags
stamped PL BCC.

A 5/8" x 30" pin with a plastic cap was
set at the center one-quarter (1/4)
corner of Section 2 from which:

A 10" Fir bears S 23° W 16.6 feet,
scribed C 1/4 S2, BT
A 6" Fir bears S 89° W 11.2 feet,
scribed C 1/4 S2, BT

The Northeast corner, the East one-quarter
corner and the South one-quarter corner of
Section 2 are on file in the County
Surveyor's office.

At the West one-quarter (1/4) corner of
Section 2 I found a 6" x 10" x ?" basalt
stone with "1/4" scribed on the North-
westerly side and an "x" on the top of
the stone, from which:

A 20" Fir bears N 71° E 20.6 feet,
scribe visible.
The Pine in the Southwest quadrant
is blown down.
Top of East-West ridge is North
approximately 30 feet.

At the North one-quarter (1/4) corner of
Section 2 I found a 2 1/2" brass cap set
on a 1" pipe, set in 1936 by the G.L.O.
from which:

A 20" Oak bears S 57° E 34.2 feet,
scar visible.
A 36" Fir bears S 19° W 31.2 feet,
scribe visible.
A 2 1/2" brass cap (S 1/4 Cor. Sec. 35)
bears S 85° 05' 30" W 25.82 feet