

MAP

SHOWING A SURVEY TO AMEND TWO PREVIOUS SURVEYS, NAMELY

- SURVEY NO. 8747, FEBRUARY 3, 1981 LOCATED IN THE E 1/2 AND THE NE 1/4, SW 1/4 OF SEC. 33, T. 33 S., R. 2 W., W. M., JACKSON CO., OREGON

AND

- SURVEY NO. 8810, APRIL 20, 1981 LOCATED IN THE SW 1/4 OF SEC. 33, T. 33 S., R. 2 W., W. M., JACKSON CO., OREGON


SURVEYED FOR AND BY:

MAX H. HULL, SURVEYING
231 NW "B" STREET
GRANTS PASS, OREGON

FEBRUARY 28, 1983

SCALE: 1" = 200'

- SET 5/8" X 30" IRON ROD
- FD. IRON MONUMENT AS NOTED

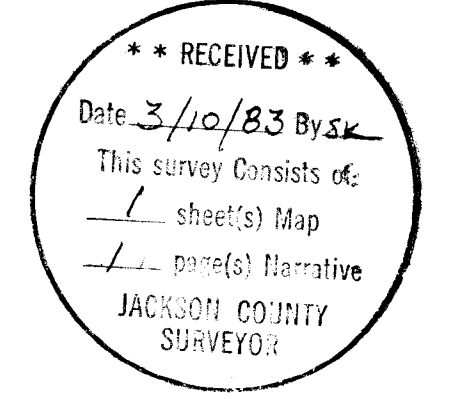

9551

Office 476-2425



MAX H. HULL Land Surveying

231 N. W. 'B' Street Grants Pass, Oregon 97526

SURVEY NARRATIVE to comply with Paragraph 209.250, O.R.S.

DATE: March 3, 1983

FOR: Max H. Hull, Surveying
231 Northwest "B" Street
Grants Pass, OR

PURPOSE: To amend Surveys No. 8747 and 8810 located in Section 33, Township 33 South, Range 2 West, Willamette Meridian, Jackson County, Oregon.

PROCEDURE: During Survey No. 8747, while attempting to re-establish the West 1/4 corner, the bearing from the original 20" diameter Yellow Pine bearing tree of North 70° East was read and used as North 20° East, resulting in the mislocation of said West 1/4 corner. Since that survey, the County Surveyor has set the corner in it's proper location and monumented said with a 1½" iron pipe and brass cap. I then tied my surveys to the County Surveyor brass cap; thence I computed and changed my surveys to conform to said true corner location as shown on the map.

Meridian is based on the West 1/2 of the North line of said Section 33, per the record G.L.O. field notes.

