

**** RECEIVED ****
 Date 5/9/83 By SK
 This survey consists of:
1 sheet(s) Map
2 page(s) Narrative
JACKSON COUNTY SURVEYOR

REGISTERED PROFESSIONAL LAND SURVEYOR
Lloyd R. Moffit
 OREGON
 JULY 17, 1970
 LOYD R. MOFFIT
 944

LEGEND:
 ● = FOUND MONUMENT AS SHOWN.
 ○ = SET 5/8" IRON PIN WITH PLASTIC CAP STAMPED, MOFFIT PLS 944.
 — = BLAZED TREES AND TAGGED PROPERTY LINE.

BASIS OF BEARINGS:
 GOVERNMENT RECORD ON SOUTH LINE OF SECTION 16.

PLAT OF SURVEY FOR
BOISE CASCADE CORPORATION
 BEING A PORTION OF SECTIONS 9 AND 16 OF TOWNSHIP 38 SOUTH, RANGE 3 EAST, W.M. JACKSON CO. OREGON
 SCALE: 1"=1000'
 DATE: APRIL, 1983
 PREPARED BY: FRIAR - MOFFIT AND ASSOCIATES MEDFORD, OREGON

SURVEY NARRATIVE TO COMPLY WITH O.R.S. 209.250 (CONT)




PROCEDURE (CONT): At the center South one-sixteenth (1/16) corner of Section 9, I set a 5/8 inch iron pin from which;

- A 26 inch Fir bears S37°W 57.4 feet, scribed CS1/16 S9 BT
- A 28 inch Fir bears S55°E 83.8 feet, scribed CS1/16 S9 BT

Distances to bearing trees were measured to the center of the tree at the B.T. scribe.

DATE: April, 1983

FRIAR-MOFFIT & ASSOCIATES
717 West 10th, Suite 1
Medford, OR 97501
Phone: 503-772-2782

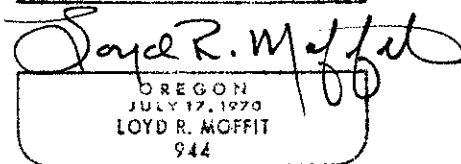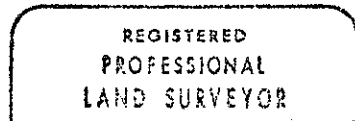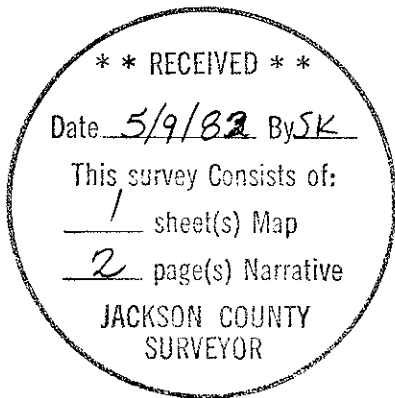

SURVEY NARRATIVE TO COMPLY WITH O.R.S. 209.250

SURVEY FOR: Boise Cascade Corporation
P.O. Box 100
Medford, Oregon 97501

LOCATION: A portion of Sections 9 and 16, Township 38
South, Range 3 East, Willamette Meridian,
Jackson County, Oregon.

PURPOSE: To survey, locate and mark the Boise Cascade
Corporation's property lines as shown on the
attached map.

PROCEDURE: Random traverses were run to the required
section corners as shown on the attached
map. While running said traverse, I discovered
that B.L.M. had performed an Administrative
Survey along the South line of Section 16.
No map was filed by B.L.M. I contacted
Mr. Jim Dow who did said surveying and he
informed me that the corners he set were not
official corners. Therefore, I set a 5/8
inch iron pin at the South one-quarter (1/4)
corner by proportion, from which;

A 8 inch Cedar bears S59⁰E 11.7 feet,
scribed N $\frac{1}{4}$ S21 BT
A 16 inch Fir bears N55⁰E 22.8 feet,
scribed S $\frac{1}{4}$ S16 BT

At the one-two hundred fifty sixth (1/256)
corner near the Southeast corner of Section
16, I set a 5/8 inch iron pin from which;

A 12 inch Fir bears S44⁰W 102.1 feet,
scribed 1/256 S21 BT
A 28 inch Pine bears N31⁰W 39.2 feet,
scribed 1/256 S16 BT

At the one-two hundred fifty sixth (1/256)
corner near the East one-quarter (1/4) corner
of Section 16, I set a 5/8 inch iron pin
from which;

A 14 inch Fir bears N68⁰E 8.5 feet,
scribed 1/256 S16 BT
A 12 inch Fir bears N60⁰W 7.6 feet,
scribed 1/256 S16 BT

At the South one-sixteenth (1/16) corner on
the East line of Section 9, I set a 5/8 inch
iron pin from which;

A 12 inch Fir bears N24⁰E 10.9 feet,
scribed S1/16 S9 BT
A 16 inch Fir bears S52⁰E 17.1 feet,
scribed S1/16 S10 BT