

MAP OF SURVEY
 LOCATED IN
 S.E. 1/4 of SEC. 28, T.37S, R.1 W., W.M.
 JACKSON COUNTY, OREGON
 FOR

MARJORIE CLARK

HOFFBUHR/BATH & ASSOCIATES, INC.
 219 N. OAKDALE MEDFORD, OREGON
 BY: RICHARD L. BATH R.P.L.S. NO. 1069
 SCALE: 1"=50' FEBRUARY 3, 1983
 BASIS OF BEARING CENTURY VILLAGE
 SUBD. UNIT NO. 1

- = Fd. 5/8" Iron Pin
per Century Village Subd. Unit No. 1
- ⊙ = Set 5/8" x 24" Iron Pin
w/yellow cap tagged
"R. BATH L.S. 1069"

REGISTERED
PROFESSIONAL
 LAND SURVEYOR

Richard L. Bath

OREGON
 20030 975
 RICHARD L. BATH
 No. 1069

**** RECEIVED ****
 Date 5/16/83 By SK
 This survey consists of
1 sheet(s) Map
1 page(s) Narrative
JACKSON COUNTY
SURVEYOR

S.E. CORNER D.L.C. No. 59
 (per Survey No. 6929)

SURVEY NO. 9603

SURVEY NARRATIVE TO COMPLY WITH PARAGRAPH 209.250
OREGON REVISED STATUTES

SURVEY FOR: Marjorie Clark
3085 Barnett Road
Medford, Oregon 97501



LOCATION: Southeast one-quarter (1/4) of Section 28,
Township 37 South, Range 1 West, Willamette
Meridian, Jackson County, Oregon

PURPOSE: To survey, monument, and describe a line as
shown on the attached map for the purpose of
recording a boundary line agreement

PROCEDURE: Using control established by this office for
Century Village Subdivision Unit No. 1, the line in question
was located, monumented, and described according to our client's
request.

Basis of bearing - Century Village Subdivision Unit No. 1

February 3, 1983

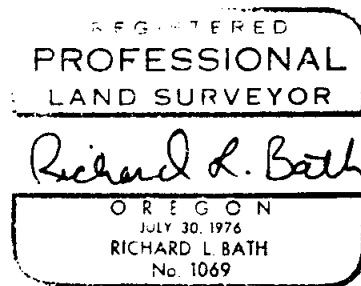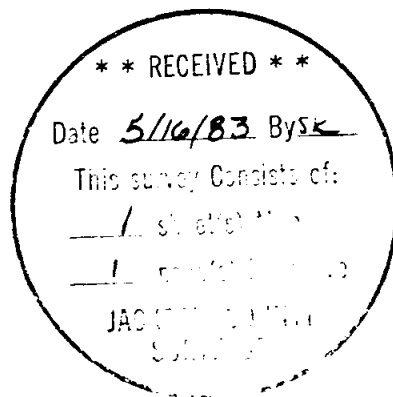

Richard L. Bath
Hoffbuhr/Bath & Associates, Inc.
219 North Oakdale
Medford, Oregon 97501