

SURVEY NARRATIVE TO COMPLY WITH
PARAGRAPH 209.250 OREGON REVISED STATUTES

SURVEY FOR: Rogue River National Forest
P. O. Box 520
Medford, OR 97501

LOCATION: Certain corner points within Section 34, Township 32 South, Range 1 West, and Sections 3, 15 and 24, Township 33 South, Range 1 West, Willamette Meridian, Jackson County, Oregon.

BASIS OF BEARING: Solar observation

PURPOSE: To preserve and protect evidence found at certain corner points within said Sections 34, 3, 15 and 24.

PROCEDURE:

South one-quarter corner of Section 34, Township 32 South, Range 1 West.

At the corner point I found a mound of stones. In the center of said mound of stones, I recovered a hole approximately 1-inch diameter, with remnants of rust on the sides of the hole, marking the corner point. At the exact center of the 1-inch diameter hole, I set a 2 1/2-inch diameter rock cap in bedrock, 12-inches below ground; brass cap marked:

T32S	R1W
1/4	S34

T33S	R1W
	1983
	LS 1071

From which the following references:

A 7-inch diameter oak bears N14°59'W, 46.60 feet distance (Record: N15°15'W, 44.88 feet).

A 10-inch diameter oak bears N62°16'E, 90.10 feet distance (Record: N66°E, 89.76 feet).

No new references.

North one-quarter corner of Section 3, Township 33 South, Range 1 West.

At the corner point I found a scattered mound of stones from which a 5-inch diameter mountain mahogany bears S70°00'E, 36.96 feet distance (original southeast bearing tree). No evidence of the southwest bearing tree was recovered. The condition of the recovered mound of stones was deteriorated to the point that I was unable to determine the exact corner point. I, therefore, reestablished the corner at record bearing and distance from the recovered mountain mahogany bearing tree.

At the exact corner point I set a 2 1/2-inch diameter rock cap in bedrock, 6-inches below ground; brass cap marked:

T32S	R1W

1/4	S3
T33S	R1W
	1983
	LS 1071

From which the following references:

A 5-inch diameter mountain mahogany bears S70°00'E, 36.96 feet distance (original BT).

A 21-inch diameter oak snag bears N73°34'E, 53.00 feet distance with a healed blaze.


I mark new references:

A 15-inch diameter cedar bears S85°20'E, 17.50 feet distance, scribed "T33S R1W S24 LS 1071 BT."

A 17-inch diameter pine bears S18°55'W, 44.45 feet distance, scribed "T33S R1W S23 LS 1071 BT."

May 15, 1983

HAROLD L. CENTER
Registered Professional Land Surveyor
Oregon Certificate No. 1071

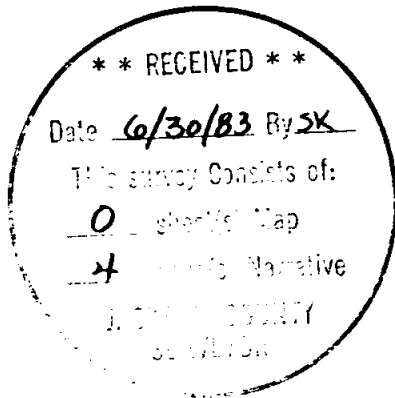

From which the following references:

A 10-inch diameter oak bears N08°26'E, 64.60 feet distance with a healed blaze.

The stump hole of an oak, diameter indeterminate, bears N29°21'E, 90.60 feet distance.

I mark a new reference:

A 14-inch diameter fir bears N27°44'E, 97.30 feet distance, scribed "1/4 S15 LS 1071 BT."

North one-quarter corner of Section 24, Township 33 South, Range 1 West.

At the corner point I found a basalt stone, firmly set, with "1/4" clearly visible on the north face. I remove said stone and at the exact corner point I set a 2 1/2-inch diameter x 30-inch long iron post, with a 2 1/2-inch diameter brass cap marked:

T33S R1W
1/4 ———
 S24

1983
LS 1071

I bury the original stone alongside the iron pipe monument.

From which the following references:

The stump hole of a fir stub, diameter indeterminate, bears S36°14'E, 59.50 feet distance, with scribe marks "1/4 S24 BT" visible on the fir stub.

A 7-inch diameter oak bears S33°08'W, 45.50 feet distance.

A 15-inch diameter pine bears S56°56'E, 115.70 feet distance, scribed "1/4 S24 LS 1071 BT."

A 9-inch diameter pine bears S14°29'W, 71.90 feet distance, scribed "1/4 S24 LS 1071 BT."

Section corner of Sections 14, 23 and 24, Township 33 South, Range 1 West.

At the corner point I found a basalt stone 6-inches x 5-inches x 5-inches, firmly set, with 1 notch on the east edge and 5 notches on the west edge. I remove said stone and at the exact corner point I set a 2 1/2-inch diameter x 30-inch long iron post, with a 2 1/2-inch diameter brass cap marked:

T33S R1W
 S14
—————
S23 | S24
 |
 1983
 LS 1071

I bury the original stone alongside the iron pipe monument.

From which the following references:

A 15-inch diameter oak bears S34°43'E, 38.20 feet distance with a partially healed blaze.

A 33-inch diameter oak bears S37°30'W, 7.50 feet distance with scribe marks "T33S" visible.

A 24-inch diameter fir bears S25°15'E, 55.22 feet distance, scribed "1/4 S3 LS 1071 BT."

One-quarter corner common to Sections 2 and 3, Township 33 South, Range 1 West.

At the corner point I found a scattered mound of stones from which a 27-inch diameter fir bears N67°30'E, 40.92 feet distance (original northeast bearing tree). The stump of the southwest bearing tree was recovered, but it had been disturbed by logging activity and could not be used to accurately position the corner point. The condition of the recovered mound of stones was deteriorated to the point that I was unable to determine the exact corner point. I, therefore, reestablished the corner at record bearing and distance from the recovered northeast bearing tree.

At the exact corner point I set a 2 1/2-inch diameter x 30-inch long iron post with a 2 1/2-inch diameter brass cap marked:

T33S RLW
 1/4
 |
 •
 |
 1983
 LS 1071

From which the following references:

A 27-inch diameter fir bears N67°30'E, 40.92 feet distance (original BT).

A 6-inch diameter pine bears N87°57'W, 226.21 feet distance, scribed "1/4 S3 LS 1071 BT."

West one-quarter corner of Section 15, Township 33 South, Range 1 West.

At the corner point I found a standard General Land Office iron post monument with a brass cap marked:

U.S. General Land Office Survey
Penalty \$250 For Removal
 |
 1/4
 |
 S15
 |
 1918

From which the following references:

A 7-inch diameter oak stump bears N84°26'E, 14.20 feet distance with illegible scribe marks visible on an open face.

A 14-inch diameter cedar bears S59°47'E, 28.40 feet distance with a healed blaze.

I mark a new reference:

A 6-inch diameter fir bears S84°57'E, 69.30 feet distance, scribed "1/4 S15 LS 1071 BT."

South one-quarter corner of Section 15, Township 33 South, Range 1 West.

At the corner point I found a standard General Land Office iron post monument with a brass cap marked:

U.S. General Land Office Survey
Penalty \$250 For Removal
 1/4 S15
 1917