

MAP OF SURVEY
 SITUATED IN
 NE 1/4 SECTION 33 & NW 1/4 SECTION 34, T40S, R2EWM.
 JACKSON COUNTY, OREGON
 SITE: SISKIYOU SUMMIT RADIO RELAY STATION

REGISTERED
 PROFESSIONAL
 LAND SURVEYOR
Erwin R. Ritter
 OREGON
 JULY 10, 1984
 ERWIN R. RITTER
 0.5"

- LEGEND**
- - SET 5/8" x 30' REBAR W/PLASTIC CAP
 - - FOUND 3/4" PIPE
 - (XXX) - RECORD BEARING & DISTANCE BY R.O.S. 691 & D.V. 410 P. 445-446
 - (XXXX) - RECORD BEARING & DISTANCE BY R.O.S. 4768
 - (XXX) - RECORD BEARING & DISTANCE BY 1968 BLM SURVEY
- BASIS OF BEARINGS - SOLAR OBSERVATION
 NOTE: SEE NARRATIVE



** RECEIVED **
 Date 8/1/83 By sc
 This survey consists of:
 1 sheet(s) Map
 1 page(s) Narrative
 JACKSON COUNTY
 SURVEY

WESTVOLD & ASSOCIATES			
ENGINEERING & SURVEYING 2333 SUMMERS LANE KLAMATH FALLS, OREGON			
SURVEYED FOR	PACIFIC NORTHWEST BELL		
SURVEYED BY	E.R.R.	6-83	
MAPPED BY	D.M.R.	6-83	
CHECKED BY	E.R.R.	6-83	
SCALE 1" = 50'			

Survey No. 9687

SURVEY NARRATIVE TO COMPLY WITH O.R.S. 209.250


SURVEYED FOR: Pacific Northwest Bell - Siskiyou Summit Radio Relay Station.
LOCATION: Situated in the NE $\frac{1}{4}$ of Section 33 & the NW $\frac{1}{4}$ of Section 34, T4oS, R2EWM, Jackson County, Oregon.
DATE: June & July, 1983
SURVEYED BY: Erwin R. Ritter, WESTVOLD & ASSOCIATES, 2333 Summers Lane, Klamath Falls, Oregon 97603.
PURPOSE: To locate and partition the tract of land known as Siskiyou Summit Radio Relay Station.

PROCEDURE: The first on site investigation with Pacific Northwest Bell representatives was on June 14, 1983. Preliminary search for survey monuments at that time revealed the B.L.M. brass cap marking the corner common to Sections 27, 28, 33, and 34, T4OS, R2EWM. On June 17, 1983 I visited the Jackson County Surveyor's office to research the records only to find the Surveyor's office to be closed. I therefore returned to the site with the map I had (1954 map by L.P. Lovejoy) and took a solar observation, ran control survey within the tract, found and tied in two tract corners.

The notes were reduced and calculations were made. I then discovered a large discrepancy in the location of the found monuments and the location of the B.L.M. brass cap.

I again visited the Jackson County Surveyor's office and upon searching the records I found that the B.L.M. monument was not in the same position as the section corner monument used by Lovejoy. The monument used by Lovejoy was established and recorded by Norman D. Price in 1953. The B.L.M. corner monument was established in 1968 and verified by Robert M. Thompson, December 1971. REFERENCED: B.L.M. Dependent Resurvey of the Ninth Standard Parallel South, Approved May 15, 1968; Robert M. Thompson R.O.S. 4768; L.P. Lovejoy R.O.S. 691.

I then returned to the site and found the Price section corner monument and other monuments as shown on the accompanying map. I found sufficient monuments to relocate the site as surveyed by L.P. Lovejoy and show the tie to the B.L.M. section corner monument.

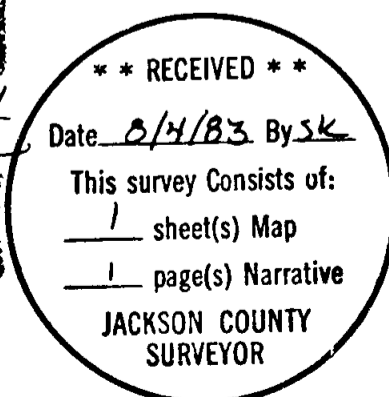

Erwin R. Ritter

Erwin R. Ritter,
Professional Land Surveyor
Oregon No. 658