
139 ON NO. 1000H CLEARPRINT

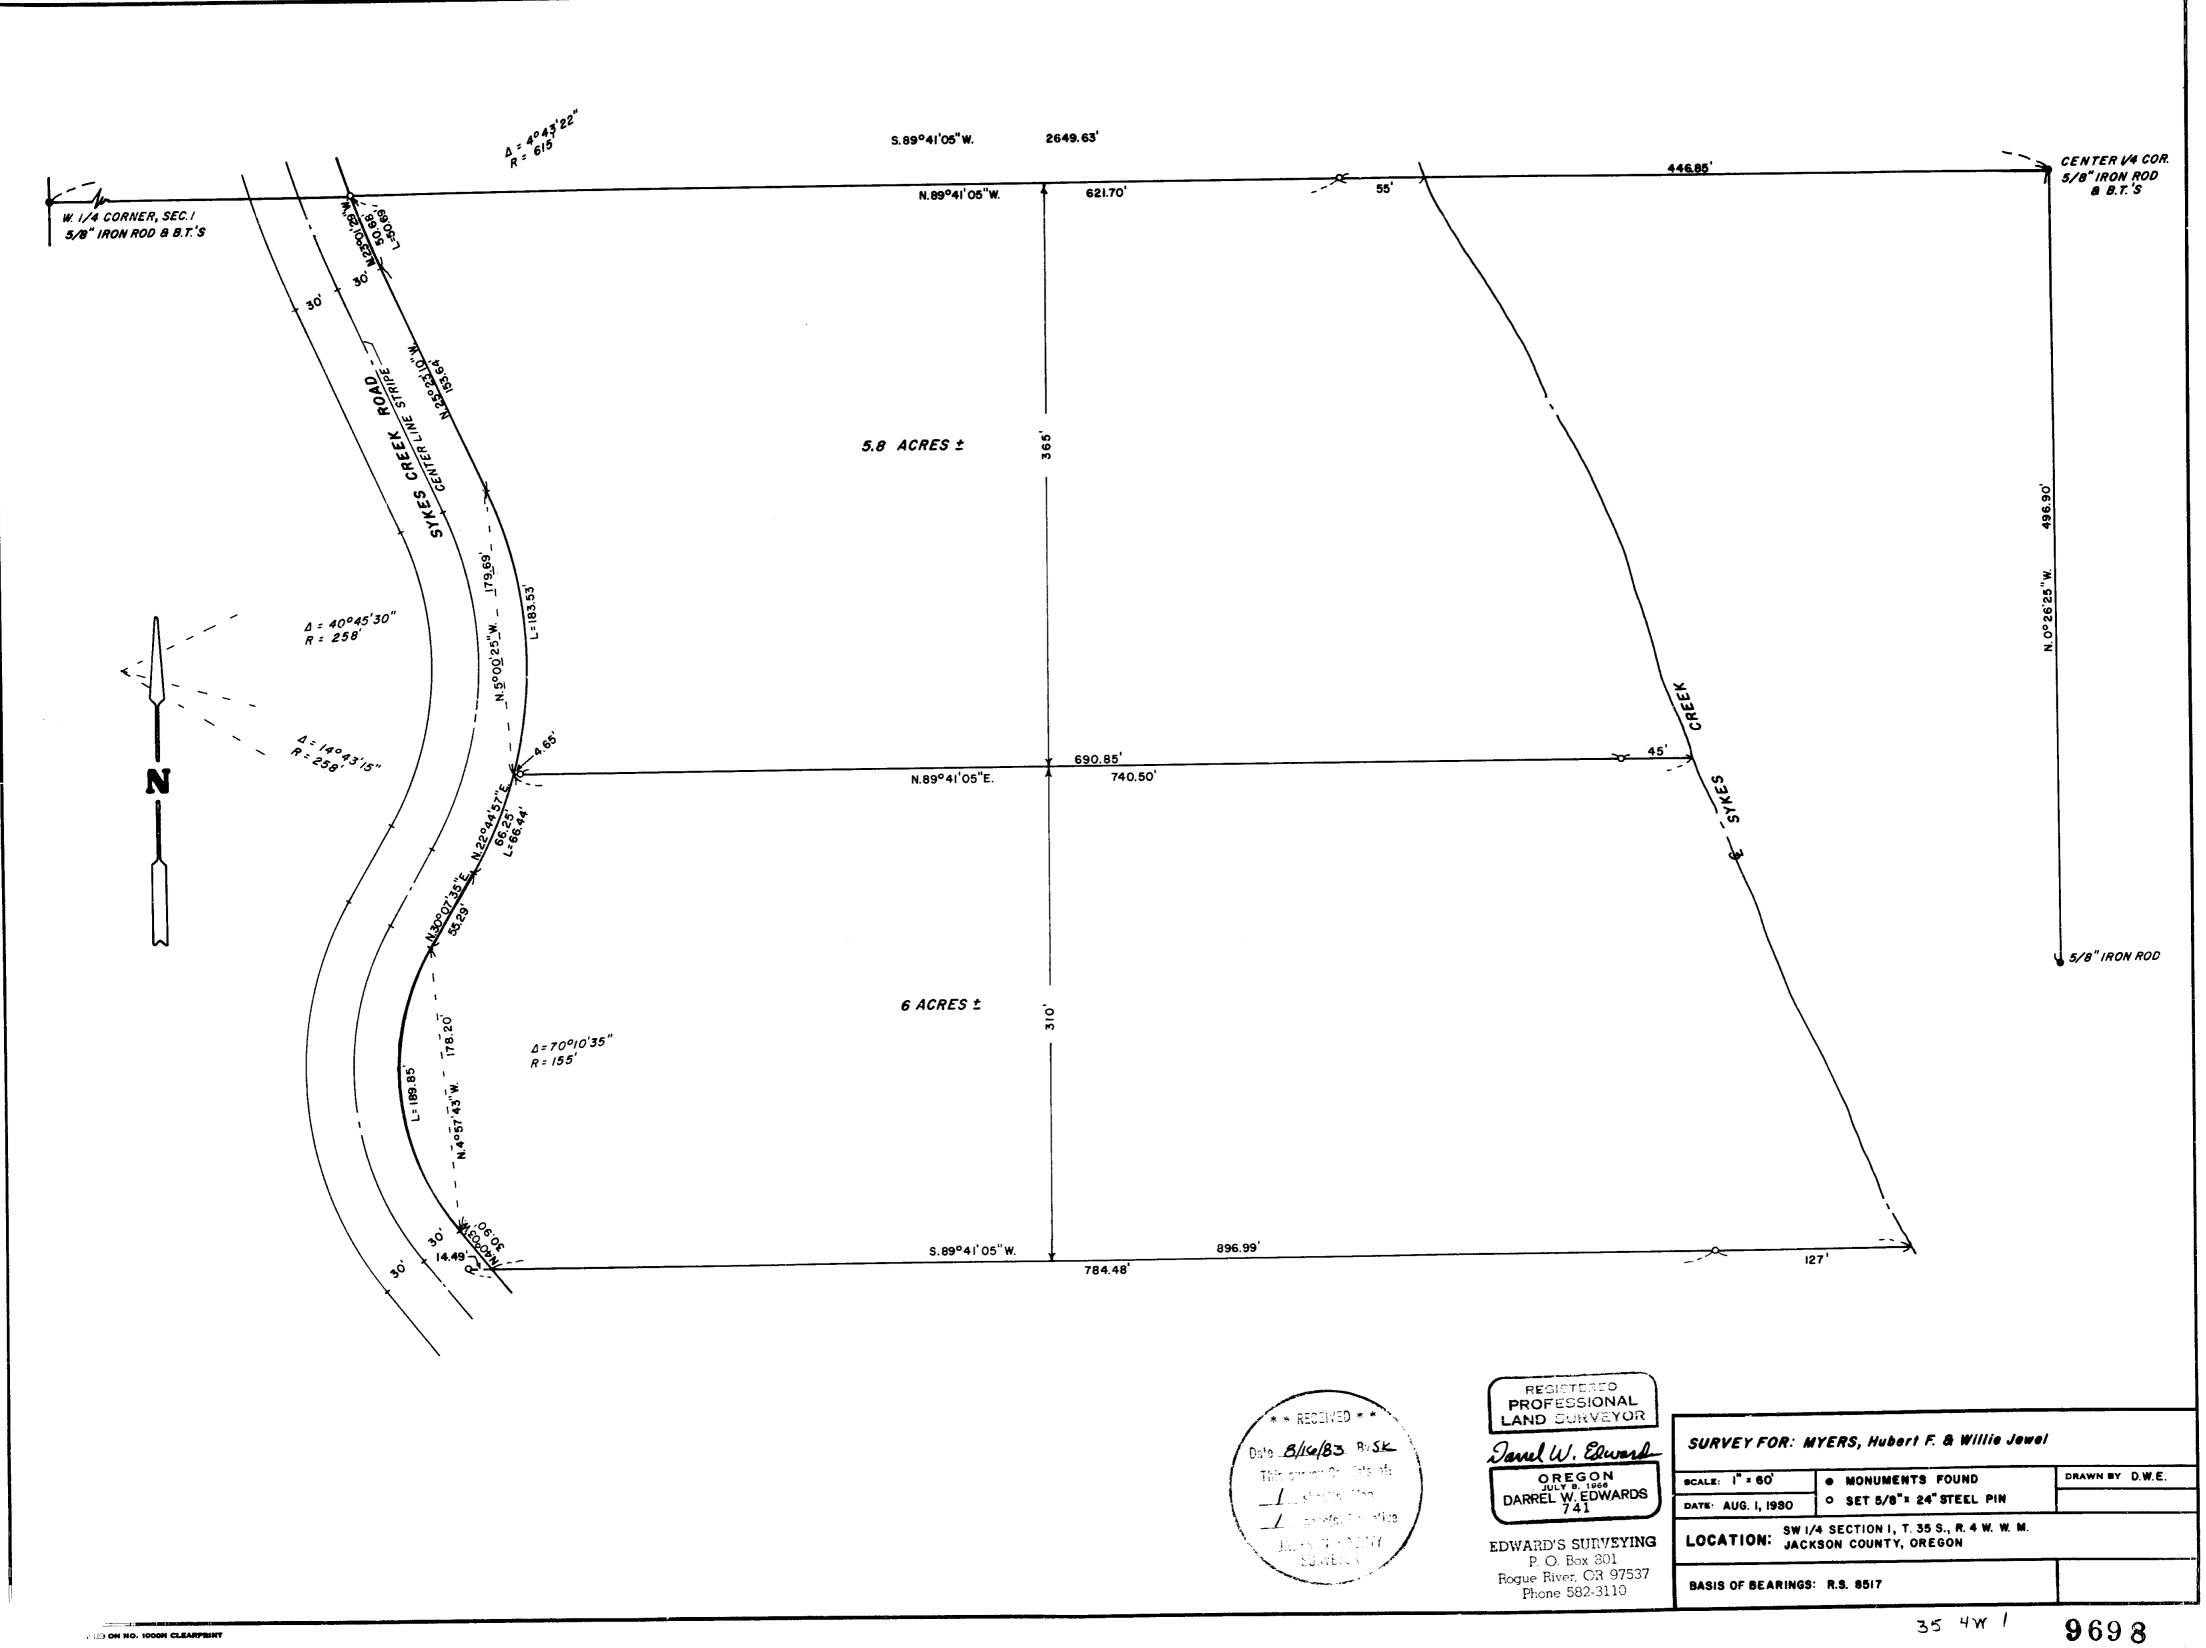

SURVEY NARRATIVE TO COMPLY WITH PARAGRAPH 209.250, ORECON REVISED STATUTES.

SURVEY FOR: MYERS, Hubert F. & Willie Jewel

1314 Hillside Place Yuma Az. 85364

SURVEY BY: Darrel W. Edwards

P. O. Box 801

Rogue River, Ore. 97537

Incation: Southwest 1/4 of Section 1, Township 35 South, Range 4 West of the Willamette Meridian, Jackson County, Oregon.

PURPOSE: To survey and monument two tax lots as described in Jackson County Deed Records; Document No. 71-09615 and No. 71-09616.

PROCEDURE: Found 5/8 inch iron rod marking the West 1/4 corner and 5/8 inch iron rod set in RS 8517 marking the center 1/4 corner of section 1. Occupied the center 1/4 corner and observed the West 1/4 corner. Surveyed in a direct line S. 89° 41' 05" W. to intersect the center of Sykes Creek and the physical center line of Sykes Creek Road. Traversed the center line of Sykes Creek Road. Set monuments as shown on the accompanying plat. Monuments set are 5/8" x 24" steel pins with plastic caps stamped "DW EDWARDS -IS 741".

EQUIPMENT: Lietz TM 20C theodolite, Lietz Red-1 EDM and 200 foot steel tape.

BASIS OF BEARINGS: RS 8517

DATE: Aug. 1, 1983

** RECEIVED **

Date 8/16/83 By5

This curvey Consists of:

______ sheet's Map
_____ page(s) Marchive

JACKSON COUNTY
SURVEYOR

REGISTERED
PROFESSIONAL
LAND SURVEYOR

OREGON JULY 8, 1968 DARREL W. EDWARDS 741

and W.