
À

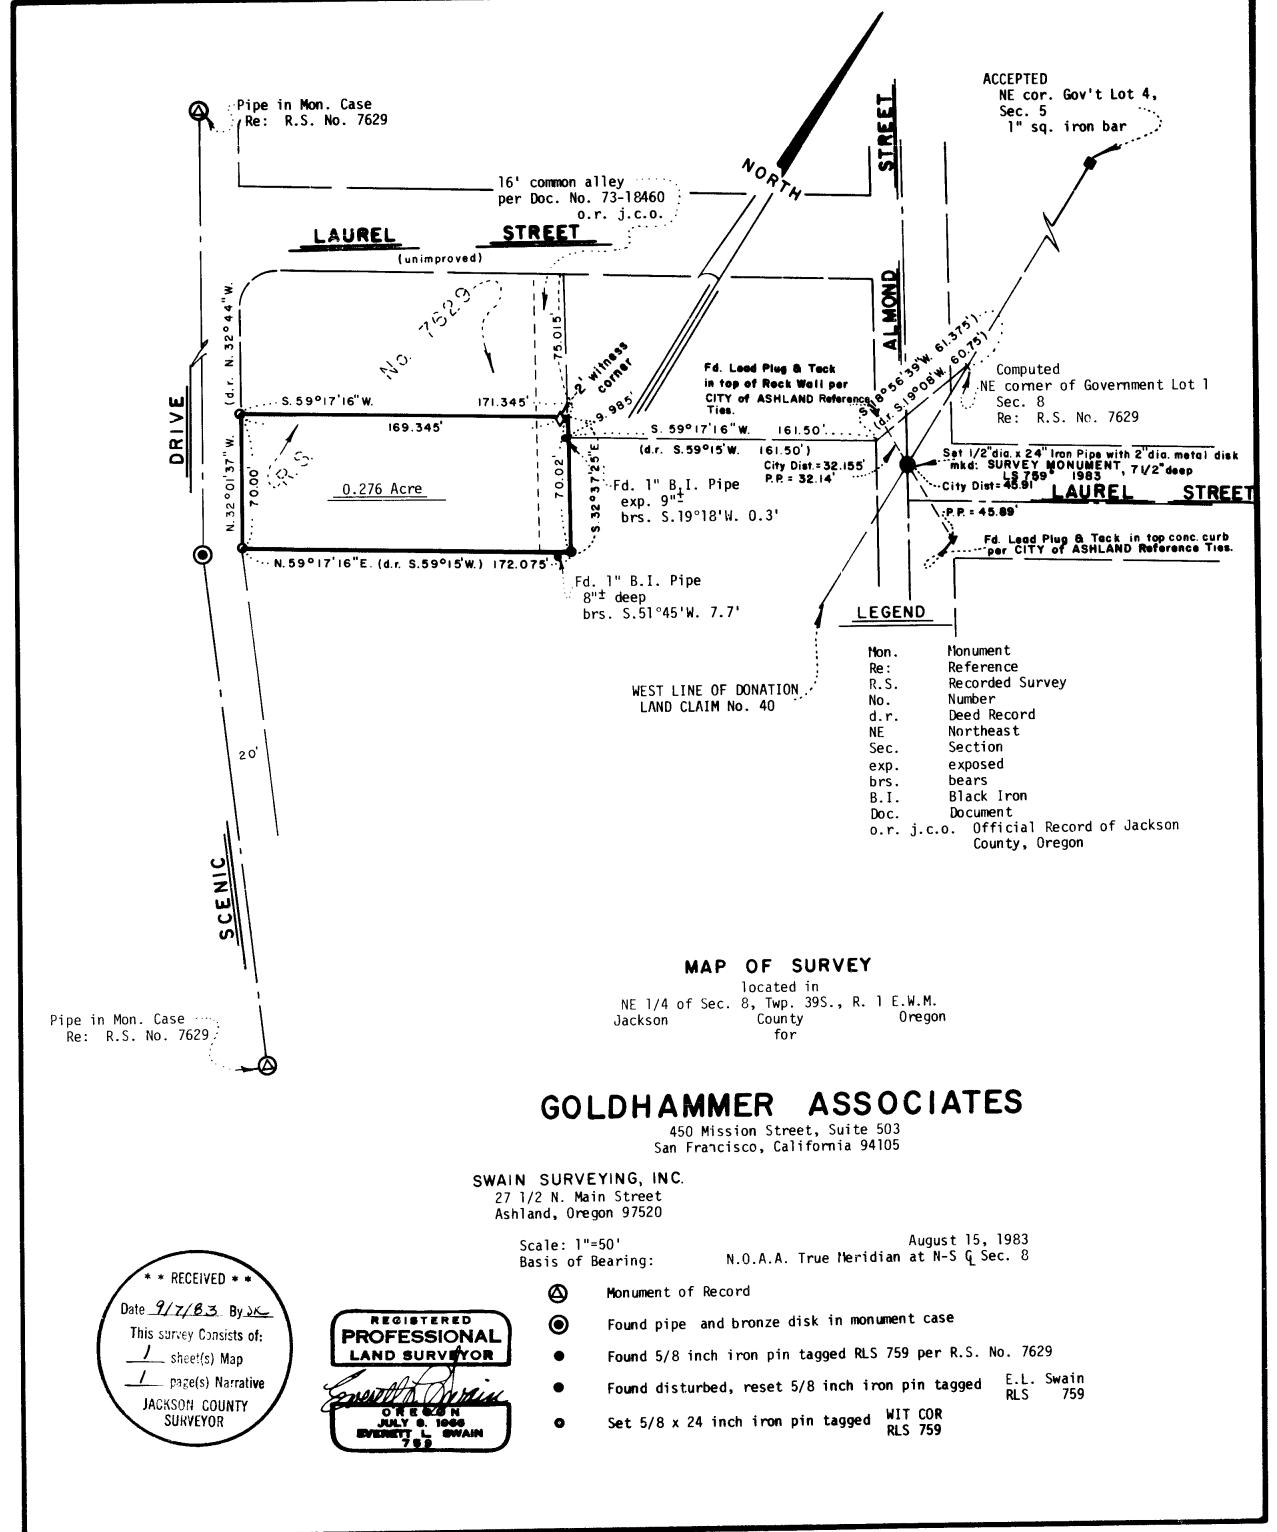

SURVEY NARRATIVE TO COMPLY WITH PARAGRAPH 209.250 OREGON REVISED STATUTES

SURVEY FOR: Goldhammer Associates

450 Mission Street, Suite 503 San Francisco, California 94105

LOCATION: Situated in the Northeast quarter of Section 8, Township 39 South,

Range 1 East of the Willamette Base and Meridian, Jackson County,

Oregon.

PURPOSE: To check and re-set, if necessary, those monuments defining Parcel

No. 2 of that "Minor Land Partition" filed for record the 8th day of February, 1979 and recorded in Volume 2, page 74 of "Minor Land Partitions" in Jackson County, Oregon per client's instructions.

PROCEDURE: From control previously established in the course of Recorded

Survey No. 7629 and City of Ashland reference ties for that monument at the intersection of the West line of Donation Land Claim No. 40 with the centerline of Almond Street, proceeded to check and re-set

those monuments as shown on the accompanying map.

BASIS OF BEARING:

True Meridian at the N-S centerline of Section 8 as derived from the National Oceanic and Atmospheric Administration (formerly Coast and Geodetic Survey) survey net established in 1968 and filed in the office of the Jackson County Surveyor.

August 26, 1983

Swain Surveying, Inc. 27 1/2 N. Main Street Ashland, Oregon 97520

PROFESSIONAL LAND SURVEYOR

> OREGÓN JULY 8, 1965 VERETT L. SWAIN

]

* * RECEIVED * *

JACKSON COUNTY SUMBAGE