

9767

27
34
1/4 SECTION CORNER
Fd. brass cap
1976 Cnty. re-estab.

--- S 89°44'20" E 2640.92' ---
(Basis of Bearing)

SECTION CORNER
Fd. 8" x 8" granite stone w/lead
center punched (Cnty. re-estab. 1977)

27 | 26
34 | 35

S/N 9449

MAP OF SURVEY
LOCATED IN
N.E. 1/4 of SEC. 34, T.37S., R.1W., W.M.
JACKSON COUNTY, OREGON
FOR

LANSE PITTS

HOFFBUHR/BATH & ASSOCIATES, INC.
219 N. OAKDALE MEDFORD, OREGON

BY: RICHARD L. BATH R.P.L.S. NO. 1069
SCALE: 1" = 200' OCTOBER 18, 1983
BASIS OF BEARING S/N 9449

● = Fd. 5/8" iron pin
⊘ = Set 5/8" x 24" iron pin w/plastic
cap stamped "R. BATH L.S. 1069"
S/N = Survey No.

REGISTERED
PROFESSIONAL
LAND SURVEYOR

Richard L. Bath
OREGON
JULY 30, 1976
RICHARD L. BATH
No. 1069

** RECEIVED **
Date 10/27/83 By SK
This survey consists of:
1 sheet(s) Map
1 page(s) Narrative
JACKSON COUNTY
SURVEYOR

Re: Document No.
73-10239

E.N.E. COR. D.L.C. NO. 57
Fd. 1 1/2" iron pipe
per 1960 Cnty. re-estab.

Rec. 508.20'

(Rec. N04°56'00"E) (Rec. N08°04'00"W)
N04°57'34"E 293.79'

S 89°42'46" E 865.57'
(Rec. S89°44'20" 865.88')

Deed Rec. 90°10'20"

meas. S00°06'54"W (Rec. S00°09'20"W)
(Deed Rec. S00°05'20"W)

858.72' (Rec. 859.03')
467.99' (Rec. 468.49')

S/N 4635

--- S 89°42'47" E 1366.92' ---

898.46'
577.48'

3368.48' ---

(TL 2801) 37 1W 34 9767

SURVEY NO. 9767

SURVEY NARRATIVE TO COMPLY WITH PARAGRAPH 209.250
OREGON REVISED STATUTES

SURVEY FOR: Lanse Pitts
4300 Barnett Road
Medford, Oregon 97504


LOCATION: Northeast one-quarter (1/4) of Section
34, Township 37 South, Range 1 West,
Willamette Meridian, Jackson County,
Oregon

PURPOSE: To survey and monument a 10 acre parcel
per legal description as prepared by this
office in June 1977


PROCEDURE: Using control established for Survey No. 9449,
located and tied in monumentation as shown on the map. The South
and East lines of the subject parcel are controlled by monuments
as shown. The West line is controlled by the tract of land as
described in Document No. 73-10239 O.R. Set monuments as shown.

Basis of Bearing - Survey No. 9449

October 18, 1983

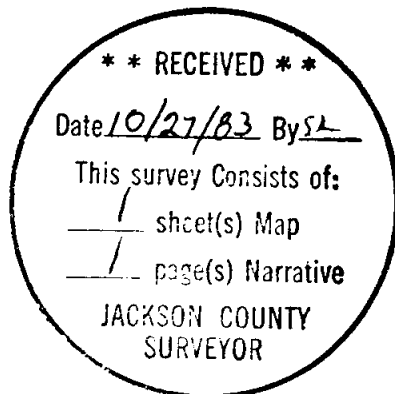

Richard L. Bath

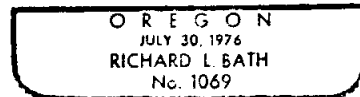

Richard L. Bath
Hoffbuhr/Bath & Associates, Inc.
219 North Oakdale
Medford, Oregon 97501