



- ① = REC. $N 10^{\circ} 46' 47'' W$ 43.97'
 - ② = REC. $N 89^{\circ} 58' 13'' E$ 200.66'
 - ③ = REC. $N 24^{\circ} 58' 08'' E$ 22.16'
 - ④ = REC. $\Delta=14^{\circ} 50' 56''$, $R=273.73'$, $L=70.94'$
 - ⑤ = REC. $N 39^{\circ} 49' 02'' E$ 22.91'
 - ⑥ = REC. $\Delta=80^{\circ} 26' 16''$, $R=105.00'$, $L=147.41'$
 - ⑦ = REC. $S 59^{\circ} 44' 48'' E$ 100.81'
 - ⑧ = REC. $S 69^{\circ} 51' 28'' E$ 53.01'
 - ⑨ = REC. $S 28^{\circ} 52' 32'' E$ 25.30'
 - ⑩ = REC. $N 69^{\circ} 51' 28'' W$ 69.04'
 - ⑪ = REC. $N 59^{\circ} 44' 48'' W$ 103.02'
 - ⑫ = REC. $\Delta=80^{\circ} 26' 16''$, $R=80.00'$, $L=112.31'$
 - ⑬ = REC. $S 39^{\circ} 49' 02'' W$ 22.91'
 - ⑭ = REC. $\Delta=14^{\circ} 50' 56''$, $R=248.73'$, $L=64.46'$
 - ⑮ = REC. $S 24^{\circ} 58' 08'' W$ 57.79'
 - ⑯ = REC. $S 89^{\circ} 52' 27'' W$ 37.00'
- MEANDER LINE COURSES OF CREEK
- ⑰ = REC. $S 05^{\circ} 20' 05'' W$ 22.36'
 - ⑱ = REC. $S 09^{\circ} 07' 45'' W$ 174.25'
 - ⑲ = REC. $S 24^{\circ} 46' 24'' W$ 207.80'
 - ⑳ = REC. $S 13^{\circ} 45' 36'' W$ 139.70'
 - ㉑ = REC. $S 38^{\circ} 19' 18'' W$ 119.24'
 - ㉒ = REC. $S 33^{\circ} 52' 04'' W$ 89.06'
 - ㉓ = REC. $S 37^{\circ} 50' 12'' W$ 79.51'

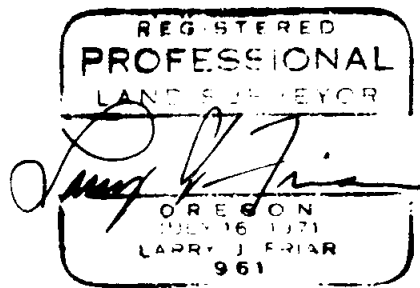

LEGEND:
 ● = FOUND 5/8" IRON PIN WITH PLASTIC CAP.
 Ⓜ = FOUND 3/4" IRON PIPE.
 ■ = FOUND MONUMENT AS SHOWN.
 ○ = SET 5/8" IRON PIN WITH PLASTIC CAP.
 STAMPED, FRIAR PLS 961.
 REC.=RECORD
 BASIS OF BEARINGS:
 SURVEY NO. 8872.

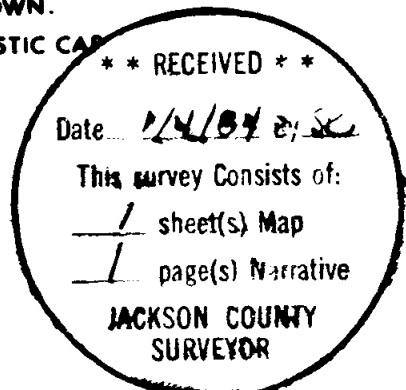

PLAT OF SURVEY
 FOR
BRUCE ERICKSON
 BEING A PORTION OF THE N.1/2
 OF SECTION 5, T. 40 S., R. 2 E., W.M.
 JACKSON CO. SCALE: 1"=200'
 OREGON DATE: NOV, 1983
 PREPARED BY: FRIAR-MOFFIT AND ASSOCIATES
 MEDFORD, OREGON

SURVEY NO. 9825

SURVEY NARRATIVE TO COMPLY WITH O.R.S. 209.250.

SURVEY FOR: BRUCE ERICKSON
6100 HIGHWAY 66
ASHLAND, OR. 97520

LOCATION: NORTH ONE-HALF (1/2) OF SECTION 5,
TOWNSHIP 40 SOUTH, RANGE 2 EAST, WILLAMETTE
MERIDIAN, JACKSON COUNTY, OREGON.

PURPOSE: TO SURVEY AND MONUMENT A BOUNDARY LINE
ADJUSTMENT AS SHOWN ON THE ATTACHED MAP.

PROCEDURE: A RANDOM TRAVERSE WAS RUN ALONG THE
APPROXIMATE BOUNDARY LINE TIEING TO
MONUMENTS ESTABLISHED BY SURVEY NO.
8872, AND LOCATING THE CENTERLINE
OF THE CREEK. THE EXACT LOCATION OF
THE BOUNDARY LINE WAS THEN DETERMINED
AND MONUMENTS ESTABLISHED ALONG THE
LINE FROM THE RANDOM TRAVERSE, AS
SHOWN ON THE ANNEXED MAP.

ALL OF THE COURSES SHOWN ON THE ANNEXED
MAP EXCEPT FOR THE BOUNDARY LINE AND
CREEK CENTERLINE ARE DEPENDANT ON SURVEY
NO. 8872.

DATE: DECEMBER 27, 1983

FRIAR-MOFFIT & ASSOCIATES

83-151

