

MAP OF SURVEY
 Located in the northwest quarter of Section 4,
 Township 39 South, Range 2 West of the Willamette
 Meridian, Jackson County, Oregon.

for
JOHN & LIZ HENDERSON

BASIS OF BEARING: Filed Survey No. 9746
 ☉ Monuments found as indicated.
 ● Set 5/8" x 24" iron pin w/ yellow plastic cap
 marked WEAVER L.S. 1679.
 SCALE: 1" = 300'
 DATE: January 20, 1984

Surveyed by: **FLATEBO, WEAVER & ASSOCIATES, INC.**
 P.O. Box 900
 Jacksonville, Oregon 97530

Fd. 1" iron pipe exp. 1" from which:
 W. Oak 9" dia. bears S76°03'W 51.6 ft.
 (rec. S77 1/4°W 51.41 ft.)
 P. Pine 17" dia. bears S75°10'E 103.7 ft.
 (rec. S73 1/2°E 103.65 ft.)

Fd. G.L.O. 1" pipe and brass cap exp. 17" in M.O.S.
 from which:
 D. Fir 31" dia. bears N38°06'E 29.2 ft.
 (rec. N36°E 29.17 ft.)
 D. Fir 26" dia. bears rec. S26°W 3.6 ft.
 D. Fir 29" dia. bears S72°13'W 18.9 ft.
 (rec. S69 3/4°W 18.85 ft.)



REGISTERED
**PROFESSIONAL
 LAND SURVEYOR**
Robert C. Weaver
 OREGON
 JUL 14, 1979
 ROBERT C. WEAVER
 1679

**** RECEIVED ****
 Date 2/2/84 By SL
 This survey consists of:
 1 sheet(s) Map
 1 page(s) Narrative
**JACKSON COUNTY
 SURVEYOR**

Fd. 1" G.I.P. w/a 3" dia. brass cap
 and accessories per filed survey no. 9746

Survey No. 9853

SURVEY NARRATIVE TO COMPLY WITH O.R.S. 209.250.

Survey for: John and Liz Henderson
6975 Sterling Creek Road
Jacksonville, Oregon 97530


Location: Located in the northwest quarter of Section 4, Township 39 South, Range 2 West of the Willamette Meridian, Jackson County, Oregon.

Purpose: To monument the east half of the northeast quarter of the northwest quarter of said Section 4.

Procedure: The controlling corners were incorporated in a series of closed traverses. The section was subdivided as shown on the accompanying plat. The bearing for this survey was based on filed survey number 9746.

Surveyed by: Flatebo, Weaver and Assoc., Inc.
P.O. Box 900
Jacksonville, Oregon 97530

Date: January 20, 1984

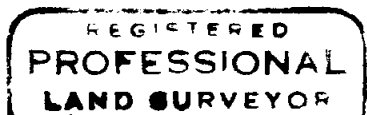

Rurt C. Weaver
OREGON
JULY 14, 1978
RURT C. WEAVER
1072

