


Plat of survey for

Louisiana-Pacific Corporation P.O. box 711, Lakeview, Oregon. Located in the Nortwest 1/4 of

Sec. 28, T.39 S., R.3E., Willamette Meridan.

by: Olson & Associates Engineering Inc.

Yreka, California 12 March 1984

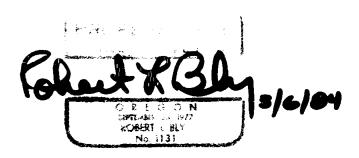

This survey Consists of:

- ______ shoet's\ Map

- 2 _ pash(s _ Marrative

JACLSON_COUNTY
SURVEYOR

I, ROBERT L. BLY, REGISTERED PROFESSIONAL LAND SURVEYOR NO. 1131 STATE OF OREGON, HEREBY CERTIFY THAT THIS MAP CORRECTLY REPRESENTS A SURVEY MADE BY ME OR UNDER MY DIRECTION IN CONFORMANCE WITH THE LAWS OF THE STATE OF OREGON AT THE REQUEST OF LOUISIANA- PACIFIC CORPORATION

Corners Established this Survey:

All corners established are in Township 39 South, Range 3 East, Willamette Meridian.

C 1/4 Section 28:

Set 2" galvanized iron pipe marked:

"T39S R3E C1/4 S28 1983 PLS 1131"

From which the following references:
14" white fir, scribed "C1/4 S28 BT" bears S40°W, 83.6'.
10" white fir, scribed "C1/4 S28 BT", bears S74°E, 96'.

One 1/4 corner common to Sections 21 and 28.

Set 2" galvanized iron pipe marked:

"T39S R3E 1 S21 4 S28 1983 PLS 1131"

From which the following references:

6" white fir, scribed "1/4 S28 BT", bears S68°E, 11.9'. 10" douglas fir, scribed "1/4 S21 BT", bears N69°30'E, 47.6'.

West 1/16 corner common to Sections 21 and 28:

Set 1 1/2" galvanized iron pipe marked:

W 1 S21 16 S28 1983 PLS 1131"

From which the following references:

6" white fir, scribed "Wl/16 S28 BT", bears S84°30'W, 7.6'. 6" white fir, scribed "Wl/16 S21 BT", bears N82°E, 18.4'.

March 5, 1984

ROBERT L. BLY Registered Professional Land Surveyor Oregon Certificate No.1131

NARRATIVE

SURVEY FOR:

Louisiana Pacific Corp.

P.O.Box 711

Lake View, Oregon

LOCATION:

In the Northwest 1/4 of Section 28, Township 39 South, Range 3 East, Willamette Meridian.

BASIS OF BEARINGS:

Found monuments at West 1/16 Section 28 and East 1/4 Section 28 as per recorded Survey

No.5829-A.

PURPOSE:

To monument the unmonumented corners of the East Half of the North Quarter of Section 28.

PROCEDURE:

A closed random traverse, using a Hewlett Packard 3820, was begun at the found monument at the West 1/16 corner of Section 28, and continued thru the common corner of Sections 20, 21, 28, 29, the common corner of Sections 21, 22, 27, 28, the common 1/4 corner of Sections 27 and 28, the South 1/16 corner of Section 28 and closing on the West 1/16 corner of Section 28. The traverse was balanced and the West 1/16 corner of Sections 21/28, the North 1/4 and the Center 1/4 of Section 28 were set from two random traverse points near their positions. All three set corners were double referenced.

Field survey was completed on 3 October 1983.

Corners Accepted for Control:

The following corners all in Township 39 South, Range 3 East, Willamette Meridian were described on Record Survey Number 5829-A and will not be redescribed herein.

Section corner 20, 21, 28, 29. Section corner 21, 22, 27, 28. 1/4 corner common to Sections 27 and 28. West 1/16 corner Section 28. South 1/16 corner Section 28.

March 5, 1984

ROBERT L. BLY Registered Professional Land Surveyor Oregon Certificate No.1131

PROFESSIONAL
LAND SURVEYOR

OREGON
SEPTEMBER 23, 1977
ROBERT L. BLY
No. 1131