

SURVEY NARRATIVE TO COMPLY WITH
PARAGRAPH 209.250 OREGON REVISED STATUTES

SURVEY FOR: Rogue River National Forest
P. O. Box 520
Medford, Oregon 97501



LOCATION: One-quarter corner common to Sections 26 and 35,
Township 36 South, Range 3 East, Willamette
Meridian, Jackson County, Oregon.

BASIS OF BEARING: Staff Compass
Mag. Var. = 20° East

PURPOSE: To establish a new reference at the one-quarter
corner common to Sections 26 and 35.

February 24, 1984

HAROLD L. CENTER
Registered Professional Land Surveyor
Oregon Certificate No. 1071

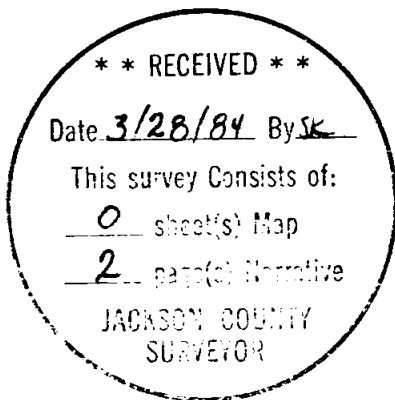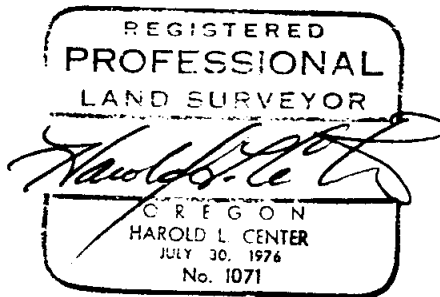

CERTIFIED RECORD OF LAND CORNER MONUMENTATION

History of original corner establishment:

This corner was originally established by U.S. Deputy Surveyor Rufus S. Moore under contract No. 475, Dated July 3, 1883. This corner was subsequently remonumented from original evidence by the Bureau of Land Management, Division of Cadastral Surveys, in 1966.

Diagram
T36S R3E
1/4 S26
S35
1966

Description of corner evidence found:

At the corner point I found a standard Bureau of Land Management brass cap monument marked as shown in the corner diagram.
From which the following references:

1. A 12-inch diameter cedar bears N45°00'E, 7.15 feet distance, with a healed blaze.
2. A 15-inch diameter fir snag bears S04°30'E, 45.60 feet distance, with a healed blaze.
3. A 13-inch diameter dead and down fir, the root hole of which bears N44°30'W, 60.00 feet distance.

Description of monument and accessories I established to perpetuate the original location of this corner:

I establish the following new reference:

An 11-inch diameter fir bears S68°30'W, 50.00 feet distance, and scribed "1/4 S35 LS 1071 BT" on a double blaze.

February 24, 1984

Witnesses: Clyde Davidson
Richard Mora

Mag. Var. 20° East

