

9982

MAP of SURVEY

Located in the SW 1/4 of Section 17 and the NW 1/4 of Section 20, Township 36 South, Range 1 West of the Willamette Meridian, Jackson County, Oregon.

for

DOUBLE DEE LUMBER CO.

Top 8" of pin bent n'ly



Surveyed by: Kurt C. Weaver
616 China Gulch Road
Jacksonville, Oregon 97530

BASIS OF BEARING: Filed Survey No. 9185

- Found 3/4" iron pin
- Set 5/8" x 24" iron pin w/ yellow plastic cap marked WEAVER L.S. 1679.

SCALE: 1" = 200'

DATE: June 11, 1984

Section cor. not visited.
record S 87° 59' 57" E 1931.57

PARCEL NO. 2

record N 19° 56' 00" E 1592.64

PARCEL NO. 1

917.64

18 | 17
19 | 20

record S 69° 53' 20" E 390.53

** RECEIVED **

Date 6/18/84 By KC

This survey Consists of:

- 1 sheet(s) Map
- 1 page(s) Narrative

JACKSON COUNTY SURVEYOR

REGISTERED
PROFESSIONAL
LAND SURVEYOR

Kurt C. Weaver
KURT C. WEAVER
1679

9982

36 SW 7

SURVEY NARRATIVE TO COMPLY WITH O.R.S. 209.250.

Survey For: Double Dee Lumber Co.
P.O. Box 3517
Central Point, Oregon 97502

Location: Located in the southwest quarter of Section 17 and the northwest quarter of Section 20, Township 36 South, Range 1 West of the Willamette Meridian, Jackson County, Oregon.

Purpose: To replace a monument located at the northeast corner of Parcel No. 2 of that minor Partition recorded in Volume 5 at page 14 of "Minor Land Partitions" in Jackson County, Oregon. The original monument had been destroyed during some grading work.


Purpose: In accordance with found monumentation from the above referenced minor partition, I set the monument as shown on the accompanying map.

The pin found at the northwest corner of parcel no. 1 lies in the bottom of a drainage ditch, and has been disturbed. The pin is bent northerly, however after close scrutiny the original position was determinable.

Bearing was based on said Minor Land Partition, which is also filed survey no. 9185.

Surveyed By: Kurt G. Weaver, P.L.S.
816 China Gulch Road
Jacksonville, Oregon 97530

Date: June 11, 1984

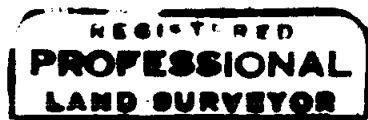

Kurt G. Weaver

