

1.  
OK

# PLAT OF MATHIS AND BAGLEY ADDITION


TO CITY OF WOODVILLE.

IN SECTIONS 15 & 22 T.36 S.-R.4 W.

OCT. 1911.

SCALE 1"=30'.

W.W. DANN, C.E.

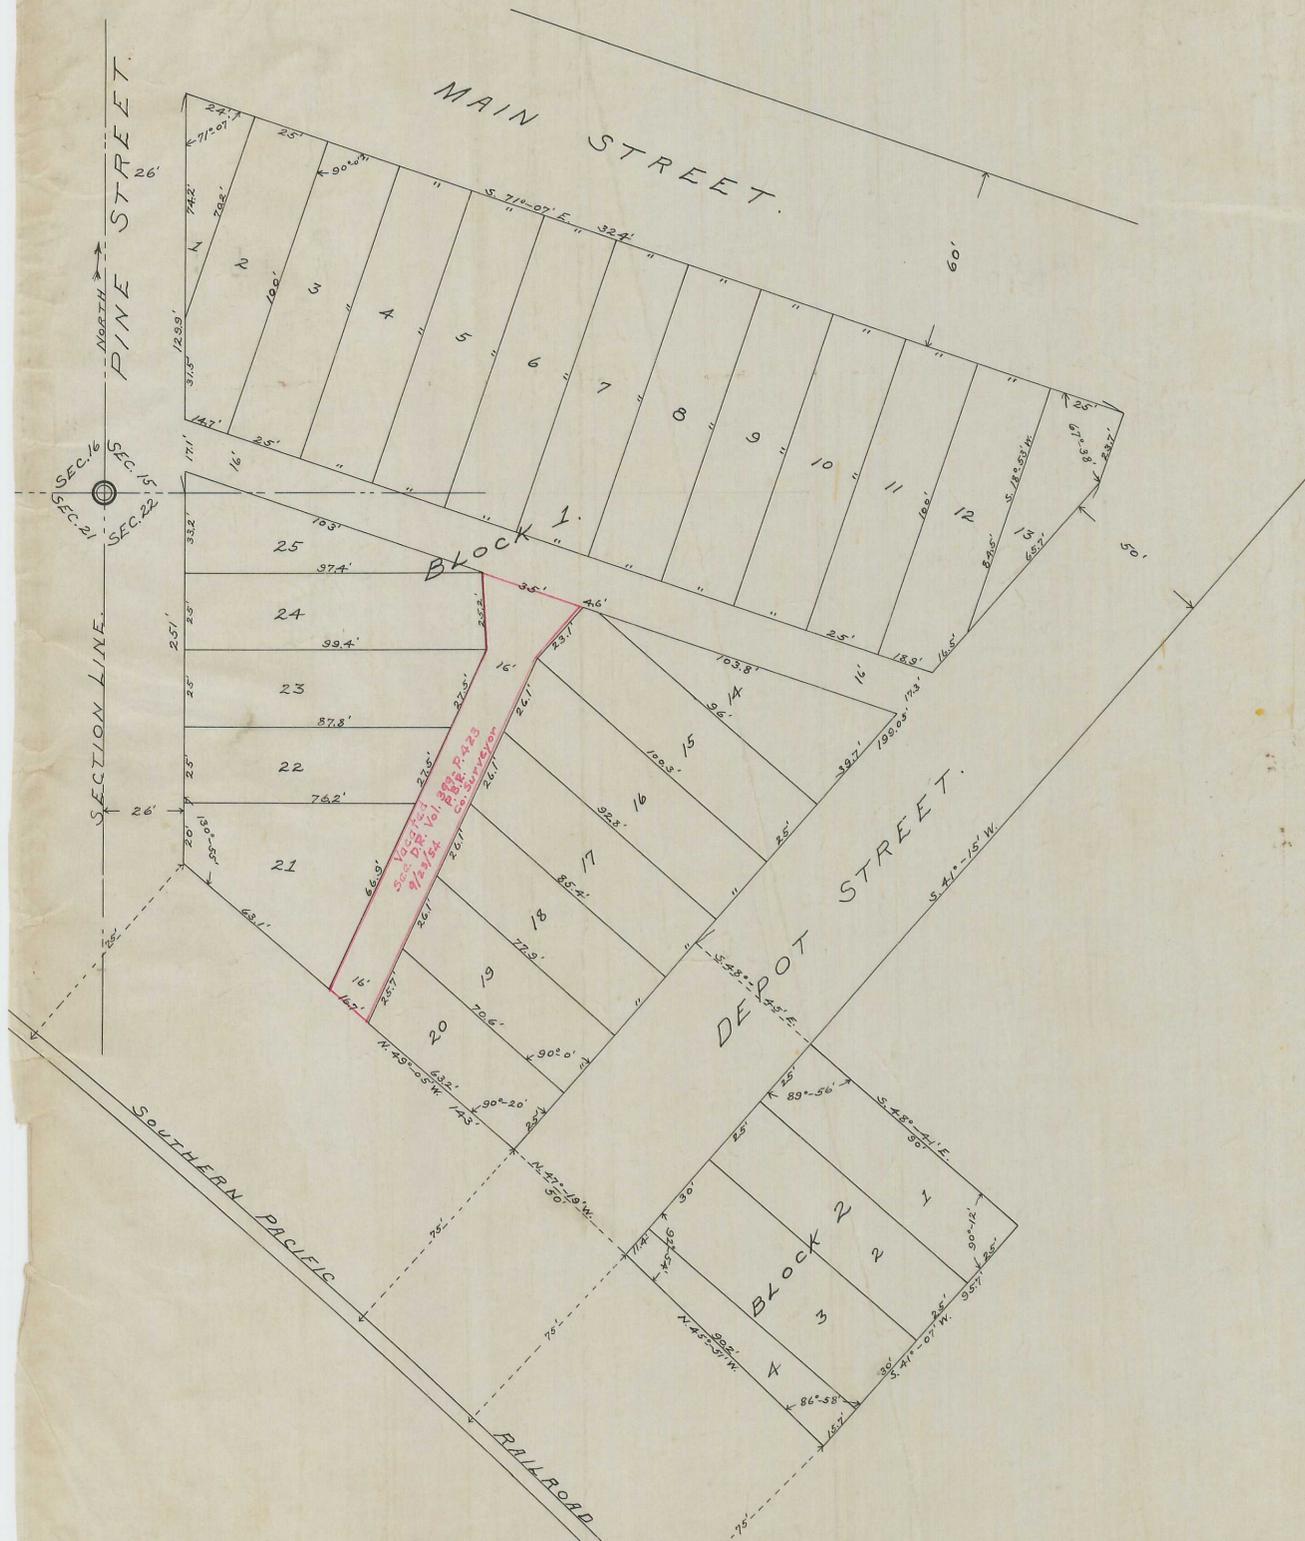

### SURVEYOR'S AFFIDAVIT AND DESCRIPTION OF BOUNDARY.

THIS IS TO CERTIFY that I W.W. DANN did on Oct. 18-1911 correctly survey and mark with proper monuments the land as shown by map hereon, that said map is a correct representation of said survey as made by me on the ground, and that I planted an Iron monument at a point in the south line of Main Street City of Woodville, Jackson County, State of Oregon 26 ft. East of, and 129.9 ft. North from Section Corner common to Sections 15, 16, 21 and 22, Township 36 South, Range 4 West, for place of beginning; thence for outside boundary of said land S. 71°-07' E. 324 ft., thence S. 18°-53' W. 23.7 ft., thence S. 41°-15' W. 199.05 ft., thence S. 48°-45' E. 50 ft., thence S. 48°-41' E. 90 ft., thence S. 41°-07' W. 95.7 ft., thence N. 45°-51' W. 90 ft., thence N. 47°-19' W. 50 ft., thence N. 49°-05' W. 143 ft., thence North 251 ft. to place of beginning.

In witness whereof I have hereunto set my hand and seal this 20th day of Nov. A.D. 1911.

W.W. Dann (Seal)

Subscribed and sworn to before me this 20th day of Nov. A.D. 1911.

H. Wallis  
Notary Public for State of Oregon.

### DEDICATION.

State of Oregon } ss.  
County of Jackson }

Know all men by these presents that we Samuel Mathis, E.E. Bagley and Augusta F. Bagley all of Jackson County, State of Oregon, are the owners in fee simple of the above described Tracts of land and that we have caused the same to be surveyed and subdivided into lots as shown by plat hereon, that said plat is a correct representation of said survey, the length and courses of the lines on said plat are indicated by signs, letters and figures, and we do hereby deed, dedicate and donate to the City of Woodville Jackson County Oregon and to the use of the public all streets and alleys as shown on said plat included in the boundary lines of said land known as "MATHIS AND BAGLEY ADDITION".

In witness whereof we have set our hands and seals this 22nd day of Nov. A.D. 1911.

Samuel Mathis (Seal)  
E.E. Bagley (Seal)  
Augusta F. Bagley (Seal)

State of Oregon } ss.  
County of Jackson }

This is to certify that on this 23 day of Nov. A.D. 1911 before me a Notary Public personally appeared the within named Samuel Mathis, E.E. Bagley and Augusta F. Bagley personally known to me to be the persons described in and who executed the foregoing dedication and acknowledged to me that they executed the same freely and voluntarily and without fear or Compulsion from anyone.

In testimony whereof I have hereunto set my hand and seal this 23 day of Nov. A.D. 1911.

E.R. Rowan  
Notary Public for State of Oregon.

Approved by the City Recorder this 24th day of Nov. A.D. 1911.

Chas. M. Harman  
City Recorder.

Approved by the Common Council of Woodville Oregon at its regular meeting held on the 24th day of Nov. A.D. 1911.

Chas. M. Harman  
City Recorder.

Approved by the County Assessor the 27th day of Dec. A.D. 1911.

A.T. Driehl  
County Assessor.

Approved by the County Court of Jackson County Oregon at its regular term on the 5th day of Jan. A.D. 1912. Vol. 14 Comm. Jnl. page 223

H. R. Coleman  
County Clerk.

Filed with the County Clerk this 27th day of Dec. A.D. 1911.

Royalora Thompson, Deputy