


WILDWOOD ADDITION TO THE CITY OF MEDFORD OREGON

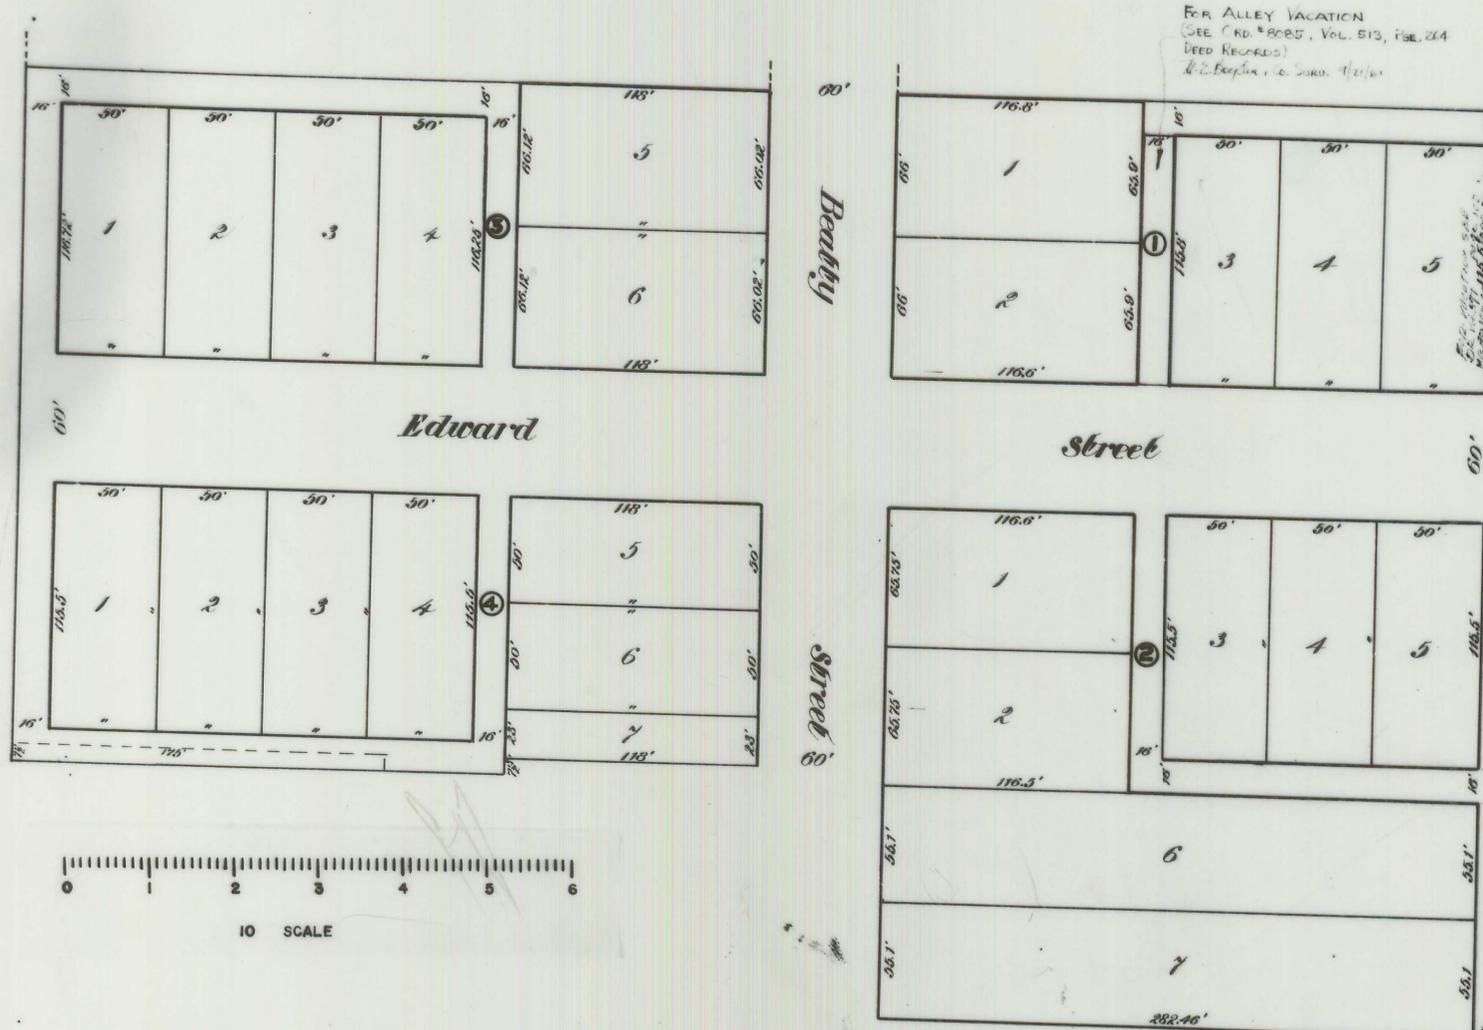

FOR ALLEY VACATION
(SEE ORD. 8025, VOL. 513, PGE. 264
DEED RECORDS)
W.C. Phelps, C. Survey, 1/21/09

Dedication

Know all men by these presents that I, E.F. Winkler am the owner in fee simple of all the above described land, save and except the south half of the alley as located on the south side of Block No 4, same being 1/2 ft by 175 ft as shown hereon, that I have laid out the same into lots, blocks, streets, and alleys as shown by the map hereon, and that said map is a correct representation of said survey and subdivision, and I do hereby dedicate to the public for public use as highways all of the streets and alleys as shown on the Plat of said tract and I do hereby designate and name the said tract as shown hereon as "Wildwood Addition"

In witness whereof I have hereunto set my hand and seal this day of November 1909

E.F. Winkler Seal

Done in presence of
M. Purdin, Rena B. Purdin, and I Rena B. Purdin, are the owners of that portion of tract as lying south of Block No 4 same being 1/2 ft by 175 ft as shown hereon in dotted lines, that we have laid out the same into an alley as shown by the map hereon, and that said map is a correct representation of said survey and subdivision and we do hereby dedicate to the public for public use as highways all of alley so described and shown on the plat of said tract and we do hereby designate and name the said tract as shown hereon as "Wildwood Addition" to the City of Medford Oregon.

In witness whereof we have hereunto set our hands and seals this day of November 1909

M. Purdin Seal
Rena B. Purdin Seal

Done in presence of
State of Oregon } ss:
County of Jackson } ss:
Personally appeared before me a Notary Public for and in said County and State the within named Mahlan Purdin and Rena B. Purdin (his wife) of Jackson County State of Oregon to me personally known to be the above named and who executed the above instrument and severally acknowledged to me that they executed the same freely and voluntarily for the purposes herein mentioned

Done this 26th day of November 1909.

J. H. Miles
Notary Public

State of Oregon } ss:
County of Jackson } ss:
Personally appeared before me a Notary Public for and in said County and State the within named E.F. Winkler, and also acting under a power of attorney for his wife, of Jackson County State of Oregon to me personally known to be the above named and who executed the above instrument and acknowledged to me that they executed the same freely and voluntarily for the purposes herein mentioned

Done this 1st day of November 1909

M. Purdin
Notary Public

Description

Commencing at the South east Corner of Lot No 7 of Block No 2, from which the inside corner of D.L.C No 89 bears South 85° 50' East 470.5 ft: thence running West 262.46 ft to the Southwest Corner of said Lot No 7: thence North along the East side of Beauty Street 118.7 ft: thence West 178 ft: thence South 7 1/2 ft: thence West 232 ft: thence North 324.22 ft: thence East 692.81 ft: thence South 433.2 ft to the place of beginning:

State of Oregon } ss:
County of Jackson } ss:
I, O. Arnspiger, being first duly sworn, do hereby certify that I have duly surveyed and marked with proper monuments the above described tract of land as shown by the plat hereon, and that said plat is a correct representation of said survey as made by me on the ground during the month of November 1909.

Suscribed and sworn to before me this 31st day of Nov. 1909.

W.C. Phelps
Notary Public

O. Arnspiger

Examined and recommended for approval this day of 1909.

I hereby certify to having examined and approved this plat

County Surveyor
J. E. Austin
City Engineer

For order of County Commissioners approving this plat see Vol 13 page 427 of Commissioners Journal of Proceedings

W. R. Coleman
County Clerk

Examined and approved this 1 day of Dec. 1909

W. D. Smith
Assessor

Examined and approved by the City Council of Medford Oregon and recorded in Vol 3 page 322 by

J. H. Miles
City Recorder

Filed for record this 4 day of Dec 1909 at 2 o'clock and recorded in Vol 2 of Plats page 7 Records of Jackson County Oregon.

W. R. Coleman
County Recorder

Filed Dec 1 1909
W. R. Coleman, Clerk
137 AM B. Town
Notary