1-26

SHIDELER'S ADDITION TO TALENT

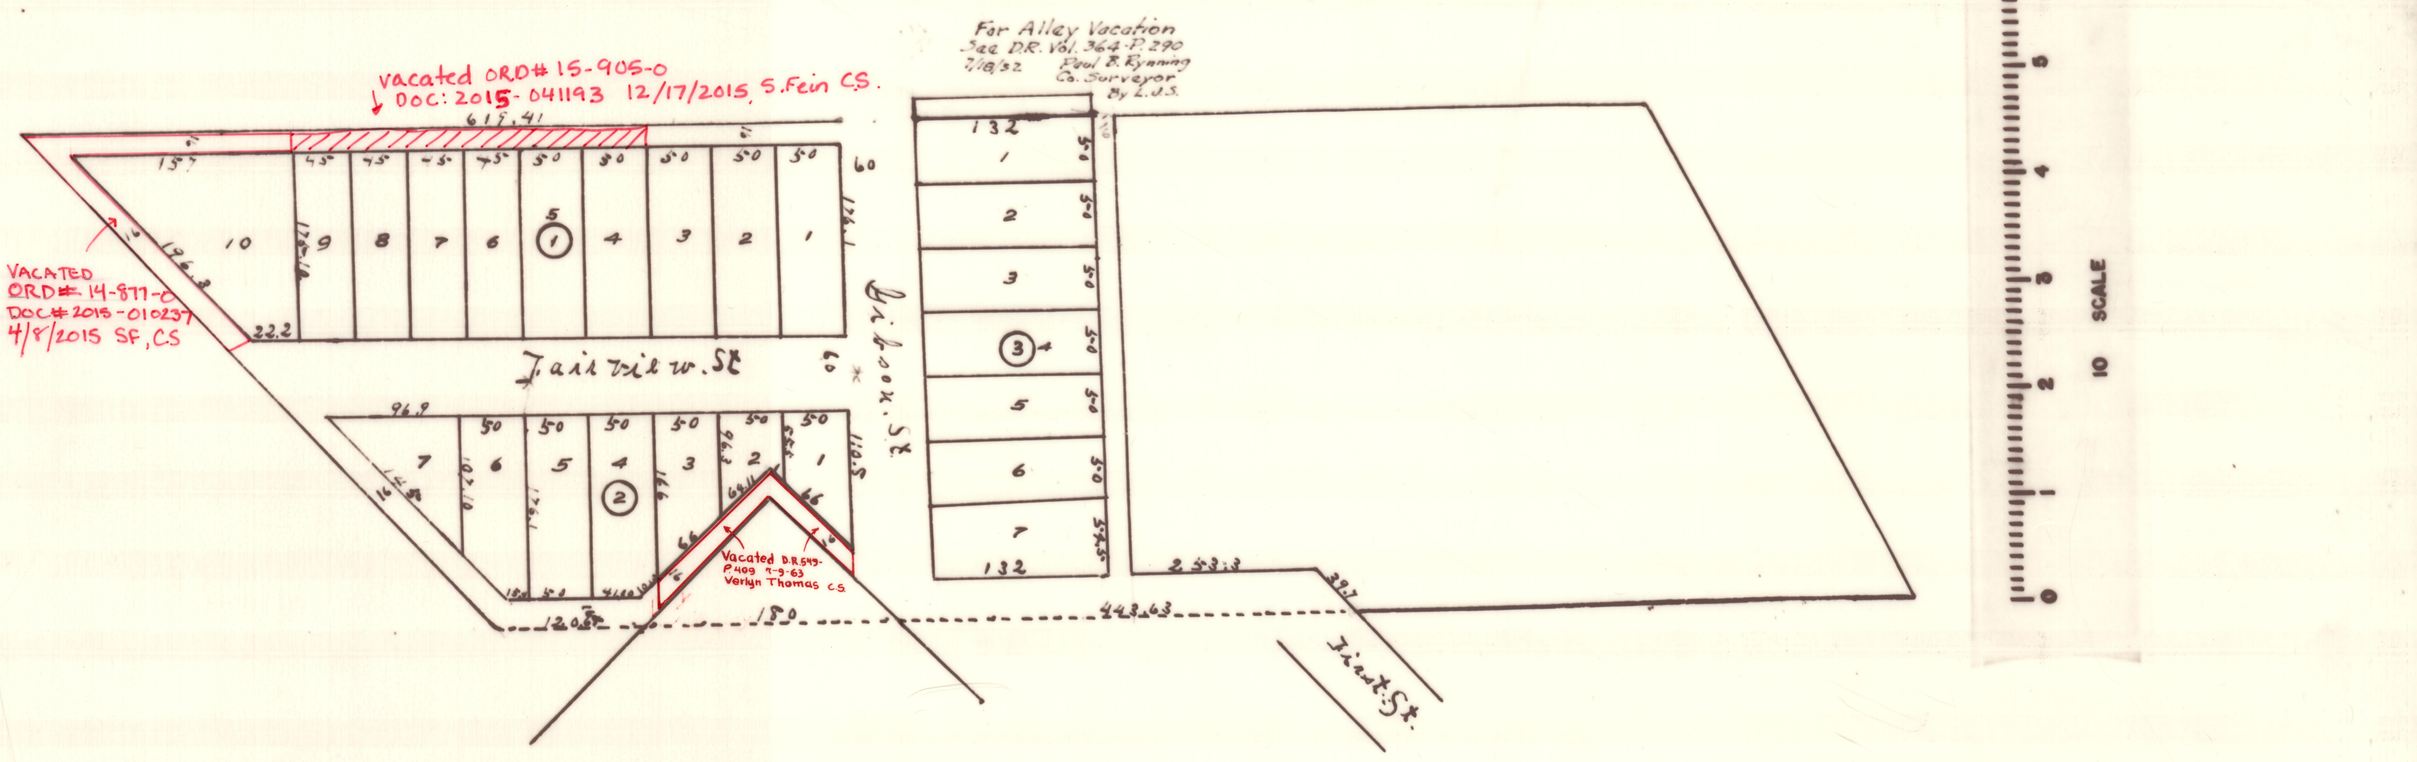

Description

Commencing at a point where the east line of First Street of the Town of Talent intersects the north line of D.L.C. No 64 of T. 38. S. R. 1. W. of Willamette Meridian in Jackson County State of Oregon said point being 17.615 chains west of the southeast corner of D.L.C. No. 60 of said town and range. Thence west along the north line of said D.L.C No 64 330.63 feet to east line of R.R Yards. Thence N. 42°. 30'. W. 125.8 feet. Thence S. 47°. 30'. W. 130 feet to north line of said D.L.C. 64. Thence west along the said north line of D.L.C No. 64. 120.68 feet to east line of right of way of R.R. Thence N. 42°. 30'. W. along said east line of right of way of R.R. 578.16 feet. Thence east 827.41 feet. Thence South 384.65 feet. Thence east 253.3 feet. Thence South 42°. 30'. E. 39.70 feet to point of beginning.

Certified correct. A. Andrews. Surveyor.

Dedication

Know all men by these presents that we John Shideler and Clara M. Shideler (husband and wife) are the owners in fee simple of the above described tract of land and we have laid out the same into Blocks, Lots, Streets and Alleys as shown herein and that said map is a correct representation of said survey and subdivision and we do hereby dedicate to the public for public highways all of the streets and Alleys shown on said map and we hereby designate and name said streets as shown hereon as the Shideler's Addition to the Town of Talent aforesaid. In witness thereof we have hereunto set our hands and seals this day of A.D. 1910.

Done in the presence of
W. R. Coleman

John M. Shideler (Seal)

Clara M. Shideler (Seal)

State of Oregon } ss
County of Jackson }

Personally came before me a Notary Public in for said County and state the with in named John Shideler and Clara M Shideler (husband and wife) all of Jackson County State of Oregon. to me personally known to be the above named. and who executed the above instrument and severally acknowledge to me that they executed the same freely and voluntarily for the purposes there in mentioned. Dated this 2nd day May 1910.

Notary Public

Examined and approved by County Surveyor this 2nd day of May A.D. 1910.

Surveyor for Jackson County Oregon

Examined and approved by County assessor this 2 day of May A.D. 1910.

assessor for Jackson County Oregon

Examined and approved by County Clerk this day of A.D. 1910.

Clerk of Jackson County Oregon

For order of County commissioners court approving this plat see Volume 13 Page 496 of Commissioners Journal of proceedings.

W.R. Coleman Clerk
By W.B. Tame Deputy

13706

1 May 1910
2
Plat
R.C. Barnett
COUNTY RECORDER

May 4th 10
W. R. Coleman

1-26