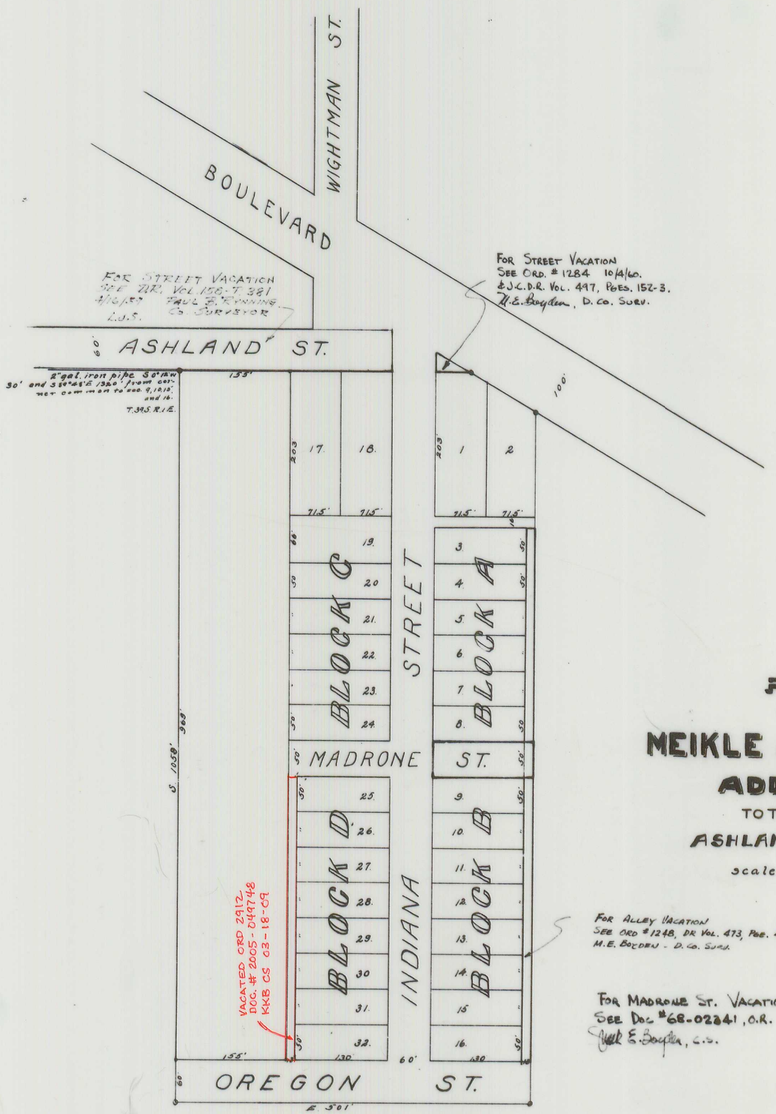

PLAT
OF THE
MEIKLE AND PAYNE ADDITION
TO THE CITY OF
ASHLAND OREGON

Scale 1in.=100ft May '10

For Alley Vacation
See Ord # 1248, DR Vol. 473, Pge. 444
M.E. Boyden - D. Co. Surv.

For Madrone St. Vacation
See Doc. #68-02241, O.R.
Jack E. Boyden, C.S.

0 1 2 3 4 5 6
10 SCALE

SURVEYOR'S AFFIDAVIT.

This is to certify that I, F. A. Grisez did on a day of May 1909 correctly survey and mark with proper monuments the lands as shown by map hereon & that said map is a correct representation of said survey as made by me on the ground.

Subscribed and sworn to before me this 6th day of July A.D. 1910.

Frank A. Grisez
Notary Public for Oregon

This is to certify that I, H. Q. Butterfield did on May 27 1910 plant a 2 in. galvanized iron pipe 3 feet long 6 inches below the surface of the ground at a point 3.0' N.W. 30 ft. and S 89°48' E 1320 ft. from sec. cor. common to sections 9, 10, 15, and 16, T. 39 S. of and R. 1. E. of Willamette Meridian Oregon. said point being on S. line of Ashland St. and set for cor. er of the Fair-View Addition

H. Q. Butterfield.

Subscribed and sworn to before me this 6th day of July A.D. 1910

Notary Public for Oregon

~DEDICATION~

THE MEIKLE and PAYNE Addition to the City of Ashland, Jackson County, State of Oregon, is a part of the Northeast quarter of the Northeast quarter of Section 15 T 39 S - R 1 E of the W.M. Oregon, and is bounded and particularly described as follows to wit- Beginning at a point which is S 89°48' E. from the point common to Sections 9-10-15-16, a distance of 1320 ft. and South at Right angles therefrom 30 feet to a point on the South line of Ashland St., thence S 89°48' E 155' to place of beginning of described land. Thence South at right angles to Ashland St. 960 ft. thence W. at right angles 155 ft. Thence S. at right angles 60 ft. thence E. at right angles 50 ft. thence N. at right angles 970 feet more or less to an intersection with the south line of Boulevard, Thence westerly along the South line of Boulevard 110 ft. more or less to an intersection with the South line of Ashland St. thence Westerly along the South line of Ashland Street 255 feet more or less to the place of beginning.

Indiana St. runs N 0°12' E. and is 60 feet wide
Oregon St. " S 89°48' E " " " "
Madrone " " " " " " 50 " "

The numbering of the Blocks and Lots, and dimensions of same are as shown on the accompanying plat.

STATE OF OREGON
COUNTY OF JACKSON } ss.

This is to certify that I, Clyde A. Payne and Judith I. Payne, of the City of Ashland, Jackson County, Oregon are the owners in fee simple of the lands as shown by the accompanying Plat, that we caused the same to be surveyed and subdivided into Blocks, Lots, Streets, and Alleys, as shown on said Plat;
The length, width and courses of the lines on said plat are indicated by signs, letters and figures, and we do hereby deed, dedicate and donate to the City of Ashland, Jackson County, Oregon, and to the use of the public all streets and alleys as shown on said plat included within the boundary lines of the said Meikle and Payne Addition.
IN WITNESS WHEREOF we have set our hand and seal this 6th day of July A.D. 1910

Done in presence of E. C. Morse (Seal) Clyde A. Payne (Seal) Judith I. Payne (Seal)

STATE OF OREGON
COUNTY OF JACKSON } ss.

This is to certify that on this 6th day of July A.D. 1910 before me a notary public, personally appeared the within named Clyde A. Payne and Judith I. Payne, personally known to me to be the persons described in and who executed the foregoing dedication and acknowledged to me that they executed the same freely and voluntarily and without fear or compulsion from anyone
In testimony where of I have hereunto set my hand and seal this 6th day of July A.D. 1910

Notary Public for Oregon

Approved by the City Recorder the 8th day of July A.D. 1910

M. E. Boyden
City Recorder

Approved by the Common Council of Ashland Oregon at its regular meeting on the 8th day of July A.D. 1910

M. E. Boyden
City Recorder

Approved by the City Engineer the 8th day of July A.D. 1910

W. W. Lane
City Engineer

Approved by the County Assessor the 15 day of July A.D. 1910

W. T. Grieve.
County Assessor.
By K. M. Grieve.

Approved by the County Court of Jackson County, Oregon, at its regular term on the 8 day of Aug A.D. 1910 Page 55 Vol 13 Commissioners Jnl

W. R. Coleman
County Clerk.
By M. B. Jerne Deputy

Filed with the County Clerk July 15 A.D. 1910

2465

W. R. Coleman
County Clerk
By M. B. Jerne Deputy

Filed with the County Recorder on the 6 day of Aug A.D. 1910 and duly recorded in volume 2 page 44 of Plats.

R. F. Smith
County Recorder

1-44