13

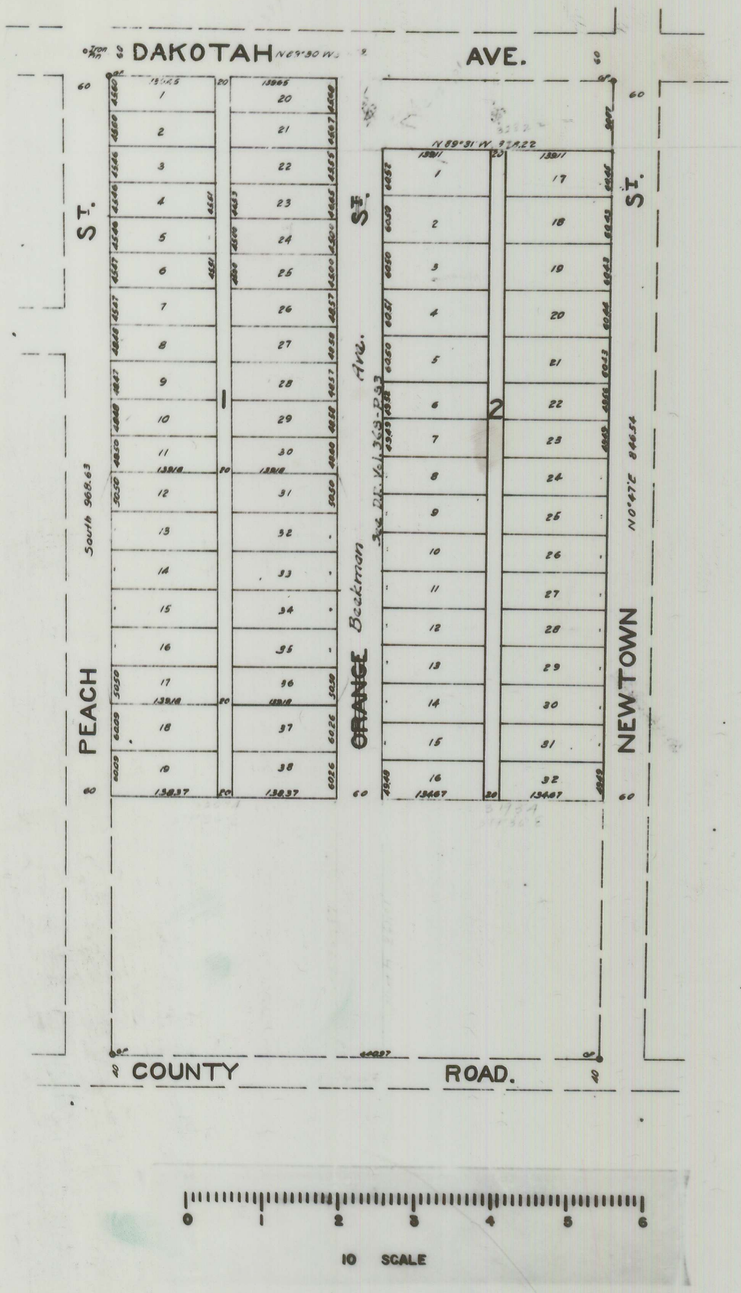

TUTTLE'S SECOND ADD

TO

MEDFORD OREGON

Scale 1" = 100' May 1910

Osgood & Cummings
Civil Engineers
Medford Oregon

Description:- Beginning at an Iron Pin at the intersection of the center lines of Peach St and Dakotah Ave, run South on the center line of Peach St. S. 968.63 feet, thence S89°36'E 706.88 feet to the center of Newtown St; thence N0°47'E 846.54 feet; thence N89°31'W 358.22 feet; thence N0°06'E 121.01 feet; thence N89°30'W 359.30 feet to the point of beginning.

Dedication: Know all men by these presents that we C H Murrey and Rose E Murrey (his wife), A L Cusick and Catherine E Cusick (his wife), Harry Tuttle and Jennie M Tuttle (his wife), Joe Sample and Jennetta Sample (his wife), C A Rinaberger and Loretta C Rinaberger (his wife) Paul Wright and Mary Wight (his wife), F W Mears and Sara B Mears (his wife), N Welter and Lillian M Welter his wife, E I Harrington and Ollie Harrington (his wife) are the owners in fee simple of the above described tract of land and that we have laid out the same into Lots, Blocks Streets and Alleys as shown hereon, and that we do hereby dedicate to the Public for use as Highways all the streets and Alleys shown hereon; and that the plat hereon is a correct representation of said survey and we do hereby name and designate the same as TUTTLES SECOND ADD. TO THE CITY OF MEDFORD.

In witness whereof we have hereunto set our hands and seals this 8th day of June 1910.

Done in the presence of
Ben J. Trowbridge Witness.
Ed. H. Smelly Witness.

Harry Tuttle Seal
Jennie M Tuttle Seal
C. H. Murrey Seal
Rose E Murrey Seal
A. L. Cusick Seal
Catherine E Cusick Seal
E I Harrington Seal
Ollie Harrington Seal
N. Welter Seal
By E I Harrington Atty in fact

F W Mears Seal
Sara B. Mears Seal
Paul Wright Seal
Mary Wight Seal
C A Rinaberger Seal
Joe Sample Seal
Jennetta Sample Seal
Lillian M Welter Seal
By E I Harrington Atty in fact

State of Oregon } S.S.
County of Jackson } Personally came before me, a Notary Public in and for the State of Oregon, County of Jackson the above named persons, personally known to me to be the above named who executed the above instrument and who acknowledged to me that they did the same freely and voluntarily.

Ben J. Trowbridge
Notary Public for Oregon

We Osgood & Cummings hereby certify that this map was made from notes taken during an actual survey in the field and that said map is a correct representation of said survey

Osgood & Cummings
by T. W. Osgood

Examined and approved this 9 day of Dec. 1910
H. T. Grieve
Assessor.

For order of County Commissioners Court approving this plat see Page 16 Vol 14 of Commissioners Journal of Proceedings.
W. R. Coleman
Clerk of Jackson County.

Filed for record this 27 day of Dec 1910 at 4 o'clock P.M. and recorded in Vol 3 Page 13 Book of Plats
R. T. Burnett
Recorder of Jackson Co

The above surveyors certificate sworn to before me this 7th day of June 1910
T. H. Miles.
Notary Public

Examined and approved this 7th day of June 1910
Harry E. Foster
City Engineer

For order of City Council of Medford approving this plat see Page 28 Vol 4 Book of Plats
Robt. H. Telfer
City Recorder.

Filed Dec 9-1910
W. R. Coleman, Clerk
By M B Towne Dpy

1-63