9

HOWARD'S ADDITION

MEDFORD OREGON

May, 1911. Scale 1"=50'

C. Frank Rhodes
Civil Engineer

Formerly 3 street vacations
V-1 = 4 V.R. Vol. 14 Pg. 199
#11,537
#11,538
#11,539
Consolidated

SOUTH PARK ADDITION

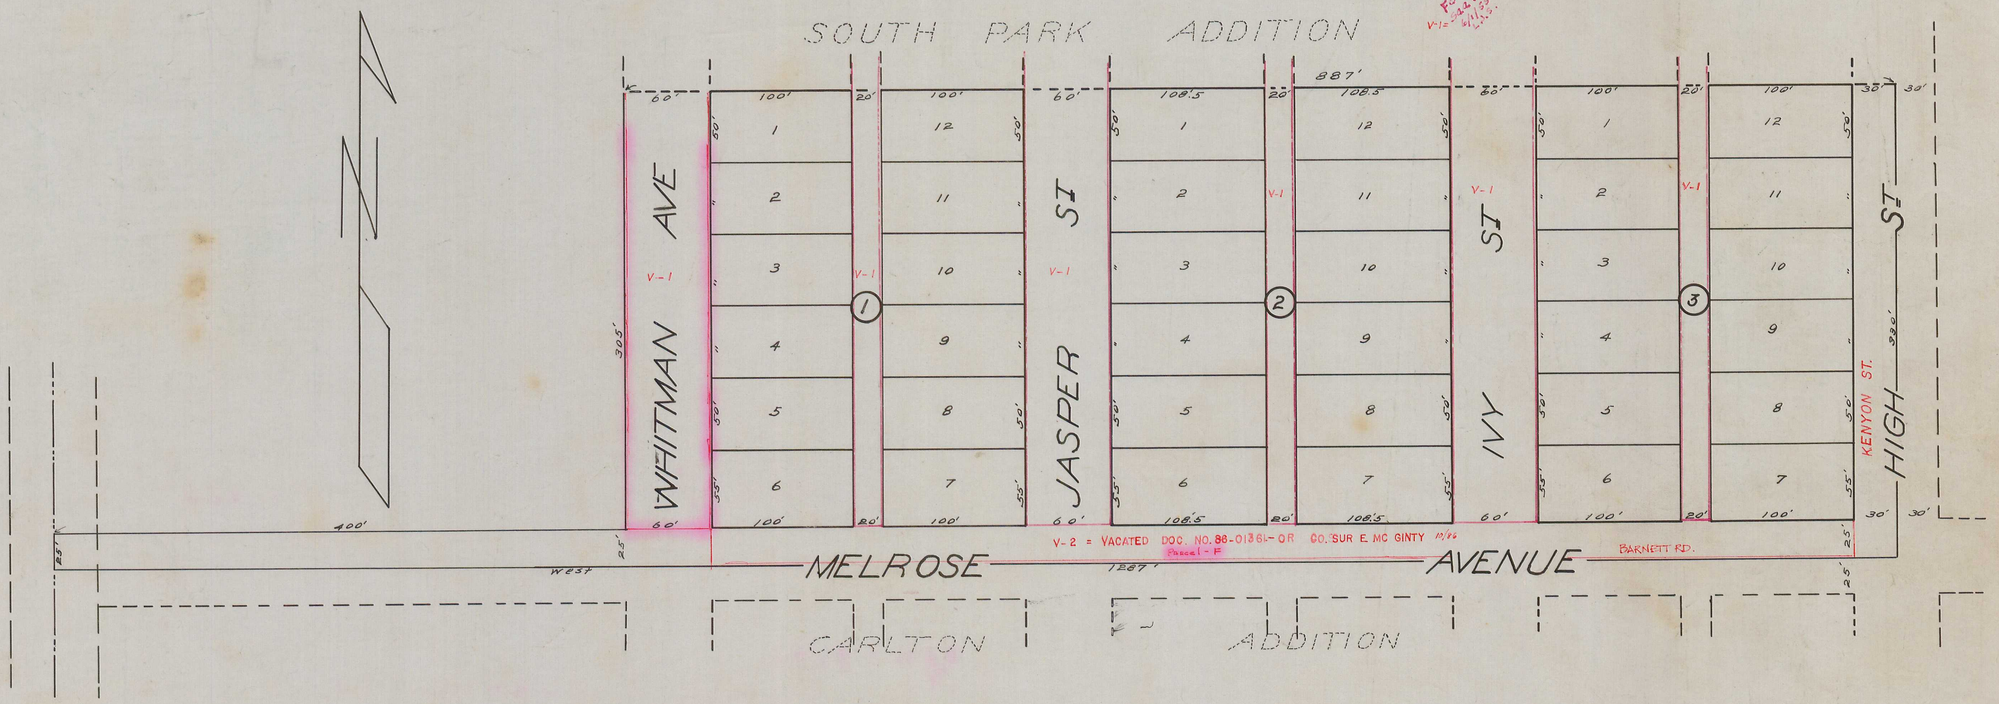

Description

Commencing at a point on the west line of D.L.C. #44, Township 37 South Range 1 West W.M. which is 1030.7 feet North of the South West Corner of said Claim, and running thence North 0°12' East on said line 25 feet, thence East, parallel with South line of said Claim, 400 feet to West line of Whitman Avenue thence North 0°12' E parallel with West line of said Claim 365 feet, thence East 887 feet, thence South 0°12' W 330 feet, thence West 1287 feet to place of beginning. Above description includes the South half of Blocks 2, 4 and 6 of South Park Addition.

Dedication

Know all men by these presents that I, Mrs. C.I. Howard a widow, an owner in fee simple of the above described tract and that I have laid out the same into lots, blocks, streets, and alleys as shown by the map hereon, and that said map is a correct representation of said subdivision, and that I do hereby dedicate to the public for public use all streets and alleys shown hereon, and that I do hereby designate said plat as the Howard's Addition to Medford, Oregon.
In witness where of I have hereunto set my hand and seal this 7 day of March 1911.

Done in presence of
F.J. Howard Jr.
Wm. Purdin

C.I. Howard

State of Oregon } ss.
County of Jackson }

Personally appeared before me a Notary Public in and for said County and State, the above named Mrs. C.I. Howard to me personally known to be the above named, who executed the aforeinstrument and she severally acknowledged to me that she executed the same freely and voluntarily for the purposes therein mentioned.
Done this 7th day of March, 1911.

Wm. Purdin
Notary Public for Oregon.

State of Oregon } ss.
County of Jackson }

I, C. Frank Rhodes, being first duly sworn do hereby certify, that I surveyed the above described tract, and that I set proper stakes and monument and that the map hereon is a correct representation of the survey as made by me on the ground between the 2nd days of April 1911.

C. Frank Rhodes

Subscribed and sworn to before me this 4th day of May 1911.

Wm. J Wambst
Notary Public for Oregon.

Examined and approved this 3rd day of May 1911.

Frank A. Grieve
County Surveyor.

For order County Commissioners approving this plat see Vol. 14 page 199, Commissioners Journal of Proceedings.

H. R. Coleman
County Clerk. By Flora Thompson, Dpty.

Examined and approved this 2 day of Aug 1911.

H. J. Grieve.
County Assessor
By C. Gilmore Dpty

Filed for record this 2nd day of April 1912 at 4 o'clock P.M. and recorded in Vol. 4 of plats, page 9, Records of Jackson County, Oregon.

Fred R. Coling
County Recorder

Examined and approved this 3rd day of May 1911.

Olive Humphreys
City Engineer.

Examined and approved by the City Council of Medford, Oregon, this 25th day of July 1911, and recorded in Vol. 4 page 156.

John F. Tiffin
City Recorder.

2 9

Filed August 2nd 1911.
H. R. Coleman
County Clerk

9