


ROYAL ORCHARD TRACT NO. 2

LOCATED IN S. 24 T. 38 S. R. 2 W. & S. 19 T. 38 S. R. 1 W., W.M.

Scale 1 in = 150 ft.

December 31 1910.

C. Frank Rhodes
Civil Engineer

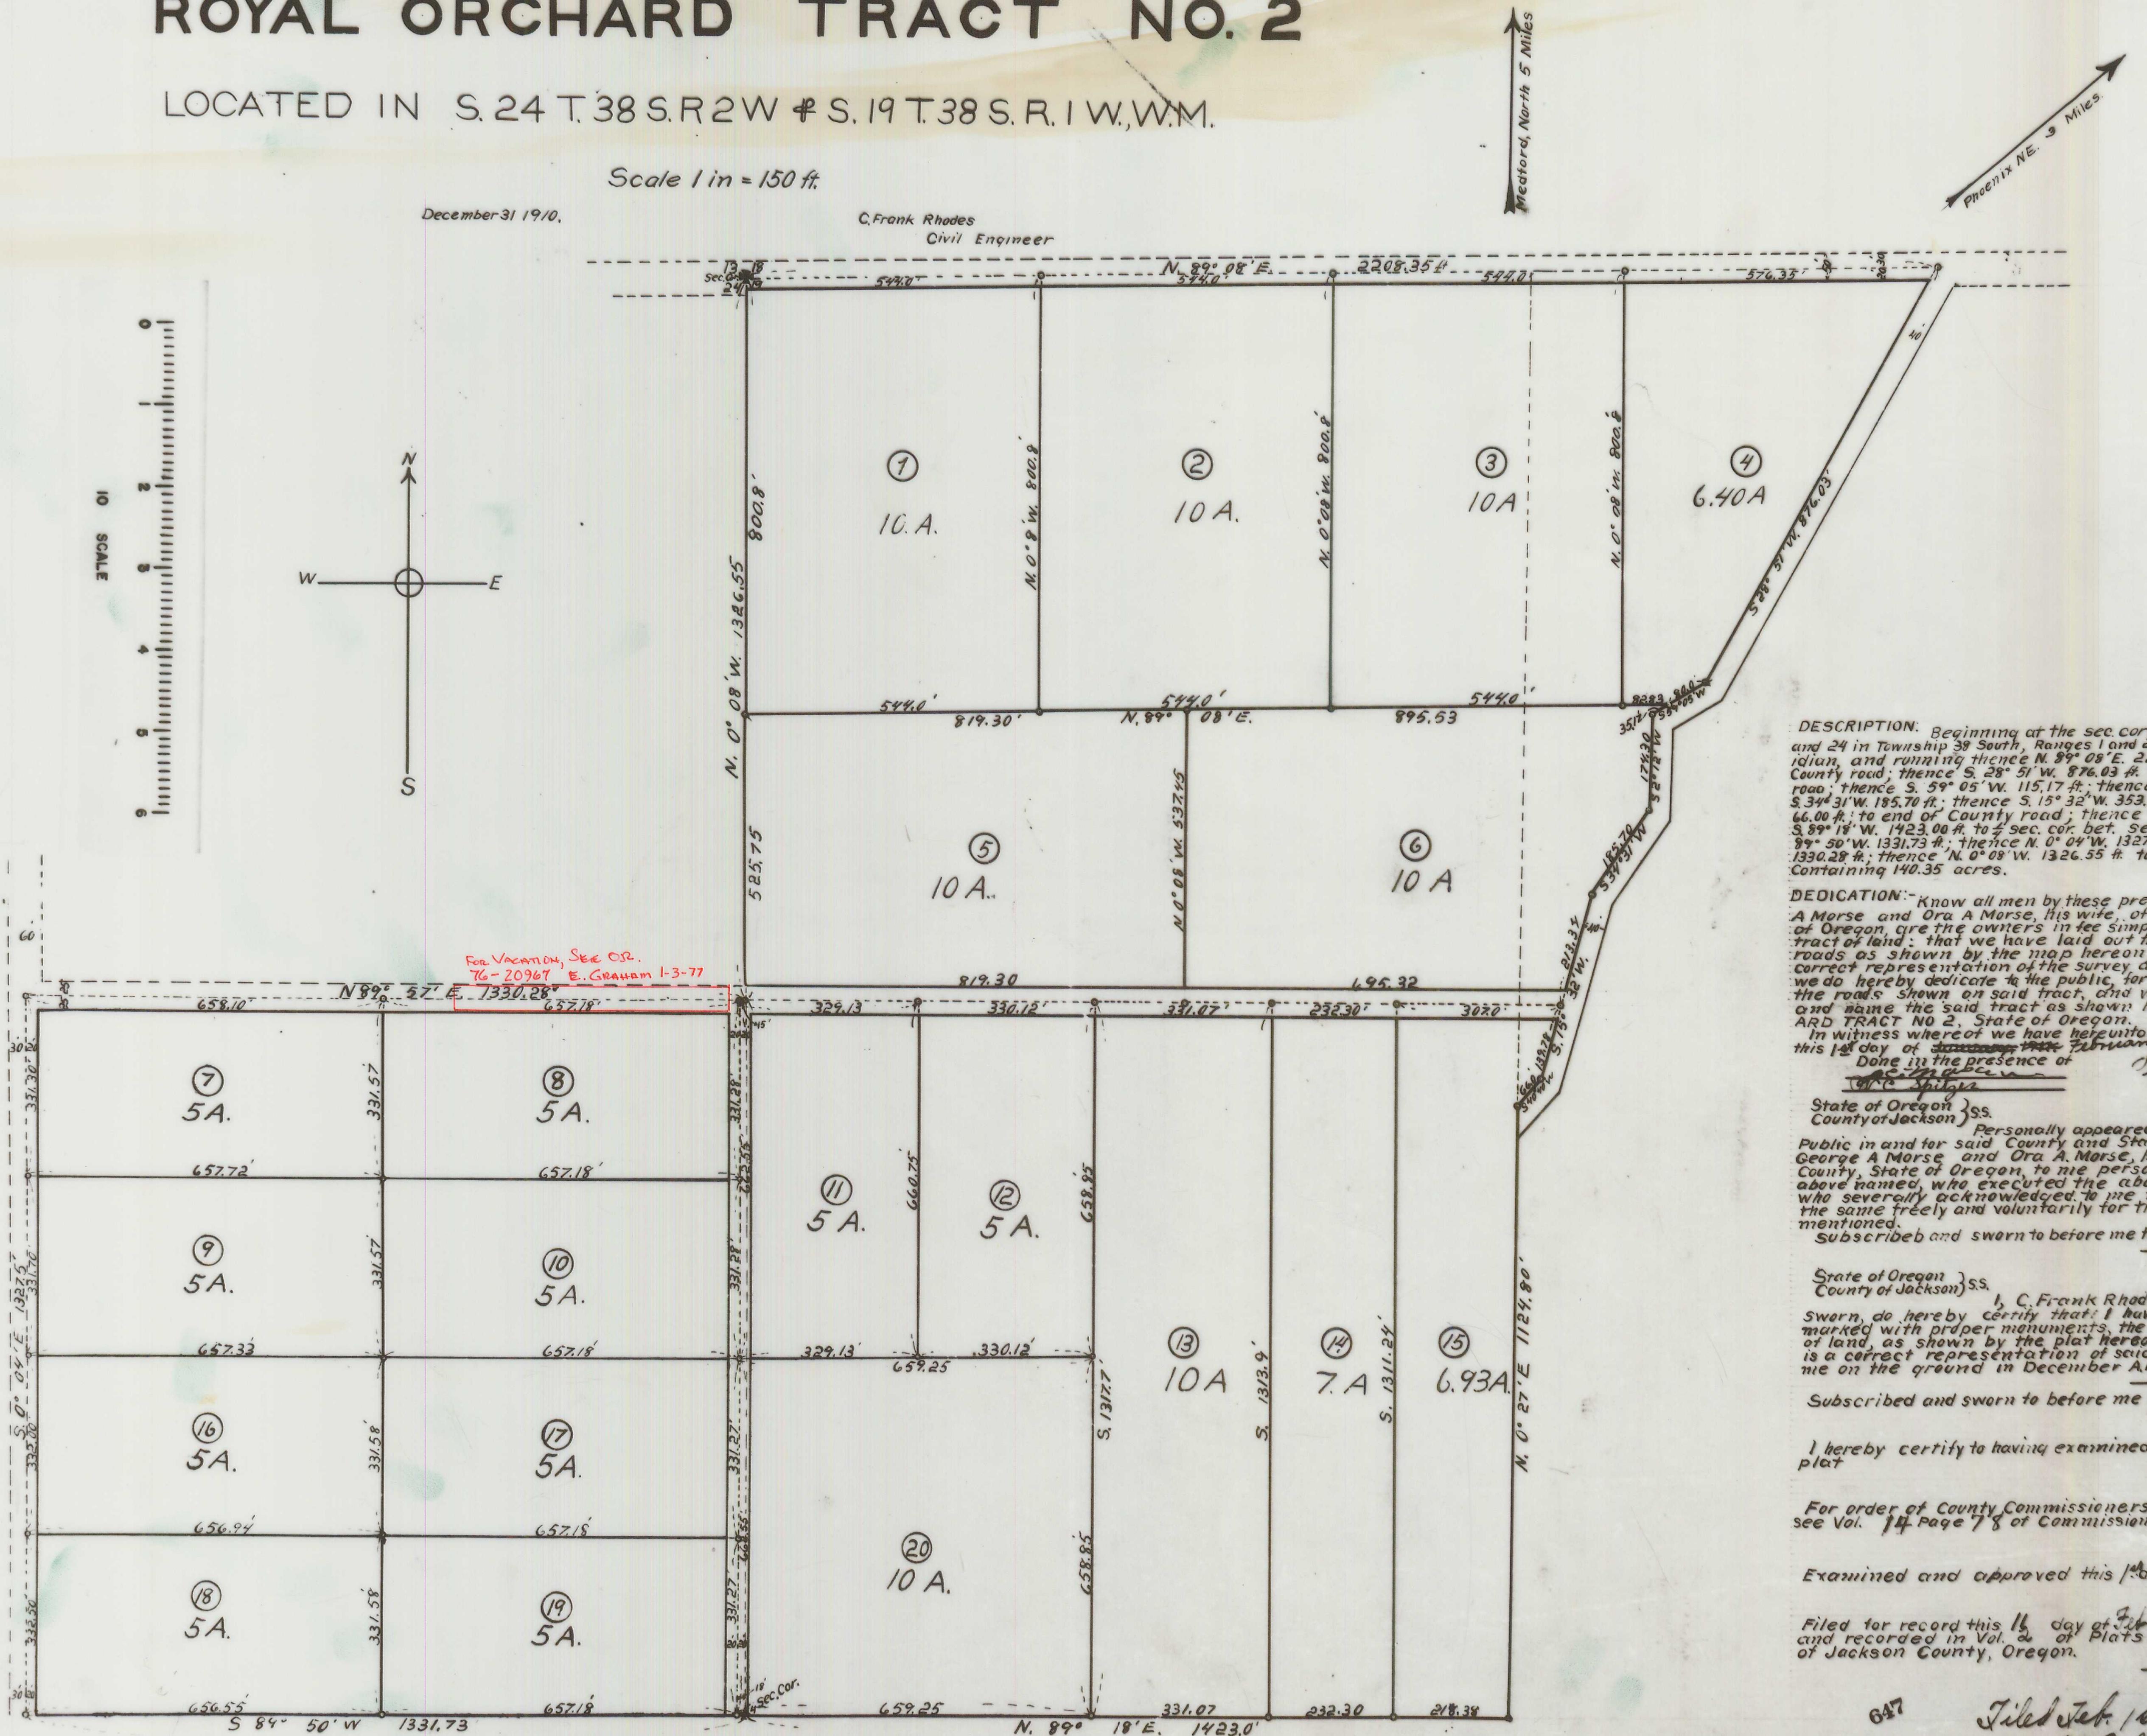

DESCRIPTION: Beginning at the sec. corner for sections 13, 18, 19 and 24 in Township 38 South, Ranges 1 and 2 West, of Willamette Meridian, and running thence N. $89^{\circ} 08' E.$ 2208.35 ft. to west side of County road; thence S. $28^{\circ} 51' W.$ 876.03 ft. along west side of said road; thence S. $59^{\circ} 05' W.$ 115.17 ft.; thence S. $2^{\circ} 12' W.$ 174.30 ft.; thence S. $34^{\circ} 31' W.$ 185.70 ft.; thence S. $15^{\circ} 32' W.$ 353.12 ft.; thence S. $40^{\circ} 40' W.$ 66.00 ft.; to end of County road; thence S. $0^{\circ} 27' W.$ 1124.80 ft.; thence S. $89^{\circ} 18' W.$ 1423.00 ft. to $\frac{1}{4}$ sec. cor. bet. Secs. 19 and 24; thence S. $89^{\circ} 50' W.$ 1331.73 ft.; thence N. $0^{\circ} 04' W.$ 1327.50 ft.; thence N. $89^{\circ} 57' E.$ 1330.28 ft.; thence N. $0^{\circ} 08' W.$ 1326.55 ft. to place of beginning, and containing 140.35 acres.

DEDICATION: - Know all men by these presents that we, George A Morse and Ora A Morse, his wife, of Jackson County, State of Oregon, are the owners in fee simple of the above described tract of land: that we have laid out the same into lots and roads as shown by the map hereon and that said map is a correct representation of the survey and subdivision, and that we do hereby dedicate to the public, for public highways, all the roads shown on said tract, and we do hereby designate and name the said tract as shown hereon as ROYAL ORCHARD TRACT NO 2, State of Oregon.

In witness whereof we have hereunto set our hands and seals this 1st day of ~~January~~ February, 1911.

W.C. Spitzer Notary Public Seal
State of Oregon } S.S.
County of Jackson }
Personally appeared before me, a Notary
Public in and for said County and State, the within named

Personally appeared before me, a Notary Public in and for said County and State, the within named George A Morse and Ora A Morse, his wife, of Jackson County, State of Oregon, to me personally known to be the above named, who executed the above instrument and who severally acknowledged to me that they executed the same freely and voluntarily for the purposes herein mentioned.

State of Oregon } ss.
County of Jackson } ss.

I, C. Frank Rhodes, being first duly sworn, do hereby certify that I have duly surveyed and marked with proper monuments, the above described tract of land, as shown by the plat hereon, and that said plat is a correct representation of said Survey as made by me on the ground in December A.D. 1910.

C. Frank Rhodes
Subscribed and sworn to before me this 4 day of Jan A.D. 1911.
M. M. Holmes

Notary Public
I hereby certify to having examined and approved this
plat
Frank J. Grise
County SURVEYOR

For order of County Commissioners approving this plat
see Vol. 14 Page 78 of Commissioners Journal of Proceedings

County Clerk.
Examined and approved this 1st day of ~~Feb~~ AD 1911.
W. G. Greene.

County Assessor
Filed for record this 16 day of Feb., 1911, at 4 o'clock P.M.
and recorded in Vol. 2 of Plats, page 23, Records
of Jackson County, Oregon.


647 Filed Feb. 1st 1911 by mail


112