


# WINCHESTER PLACE ADDITION TO THE CITY OF MEDFORD.

Scale 1" = 100' L.W. Whiting C.E.  
1911.

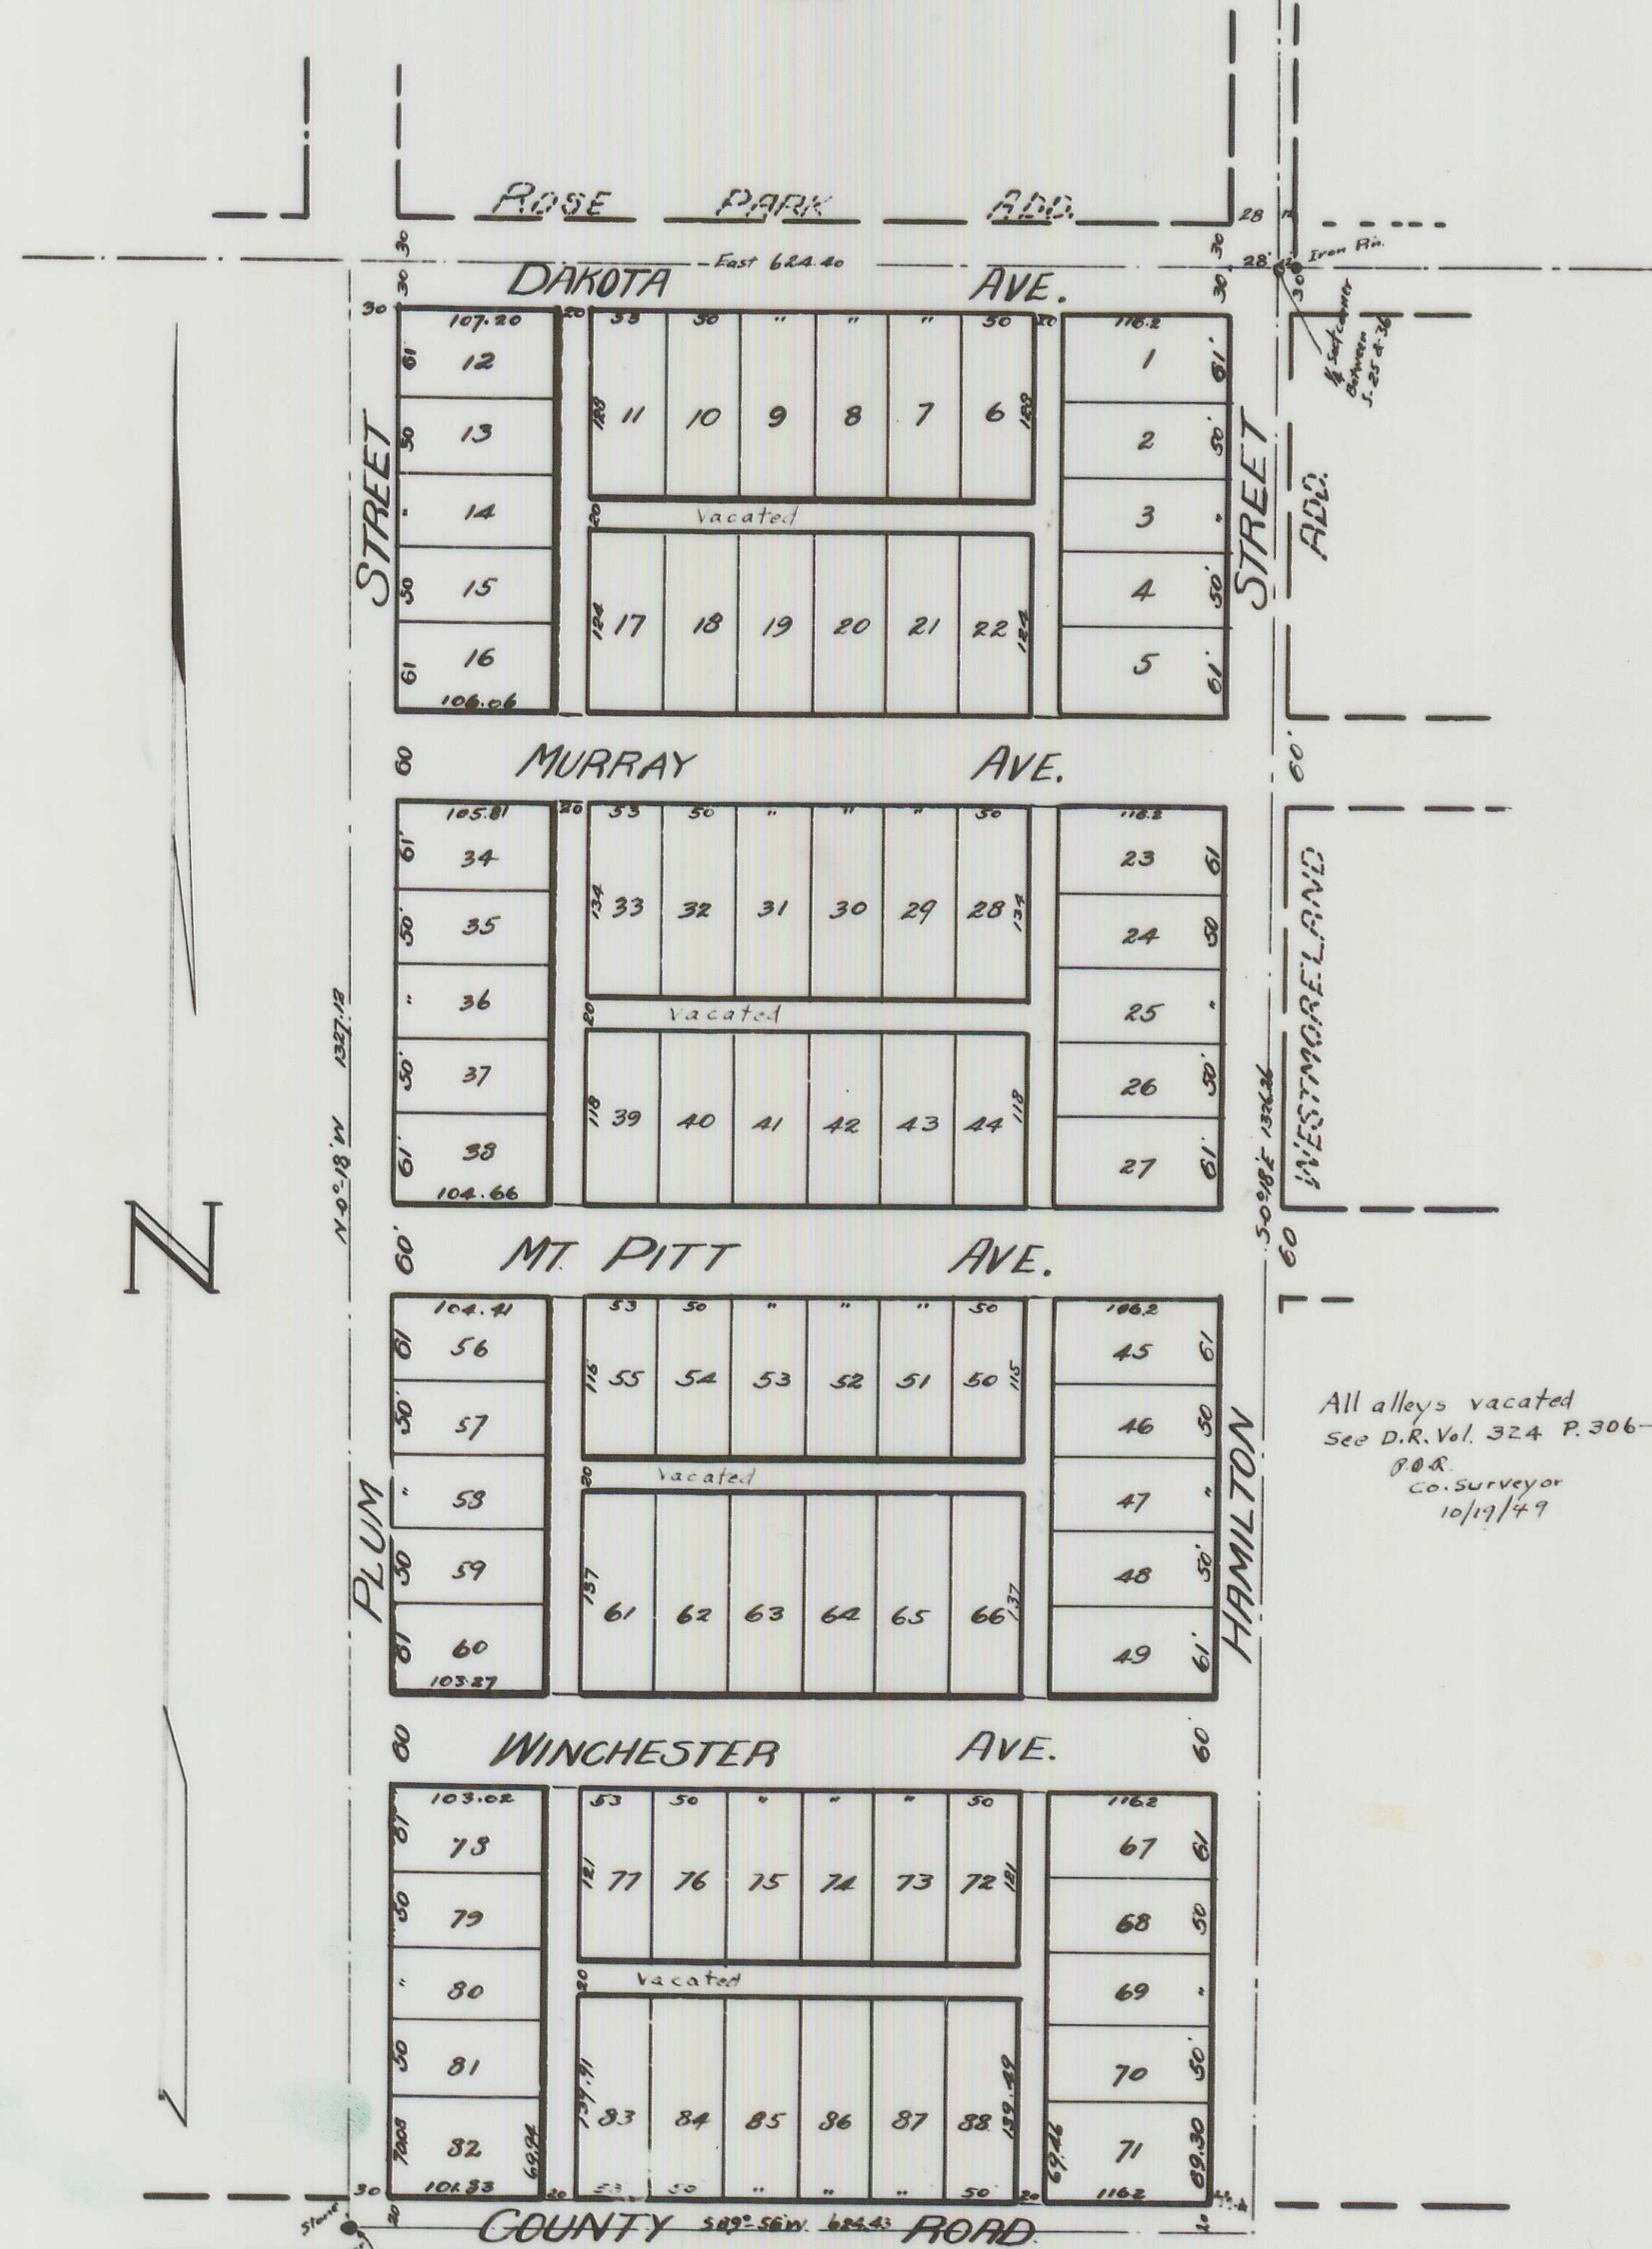

All alleys vacated  
See D.R. Vol. 324 P. 306-7  
J.B.A.  
Co. Surveyor  

### DESCRIPTION

Beginning at the NW Corner of D.R. 347, 375, R. 2 W, W.M., thence N 0° 15' W 1327.12 ft. thence East on the Section line 624.4 ft. to the 1/4 Corner between Sect 25 & 36 thence S 0° 18' E 1326.26 ft.; thence S 89° 56' W 624.43 ft. to the point of Beginning.

### DEDICATION

Know all men by these presents that I, Chris Gottlieb, a bachelor, am owner in fee simple of the above described tract of land, and that I have subdivided the same into lots, streets and alleys as shown correctly on attached Plat, and I hereby DEDICATE to the public for public purposes all streets and alleys as shown and do hereby designate said plat to be "WINCHESTER PLACE ADDITION TO MEDFORD."

Done in the presence of

Chris Gottlieb

L.P. Cameron

Notary Public

Personally appeared before me a Notary Public in and for said County and State the above named party who executed the above instrument freely and voluntarily for the purposes mentioned above.

Done before me this 8th day of July 1911.

L.P. Cameron  
Notary Public

State of Oregon }  
County of Jackson } ss.

I, L.W. Whiting being first duly sworn do hereby certify that I have surveyed the above described tract of land and mark same on the ground with the proper monuments, on the month of July 1911, also that the attached Plat is a correct representation of said Survey.

L.W. Whiting  
Civil Engineer

Sworn to before me this 8th day of July 1911.

L.P. Cameron  
Notary Public for Oregon

Examined and approved by me this 8th day of July 1911.

Oliver Loupique  
City Engineer

Examined and Approved by the City Council of Medford Oregon, July 10 1911 and recorded in Vol 4 page 153

John H. Selger  
City Recorder

Examined by me this 6 day of July 1911.

W.J. Griene  
County Assessor

For Order of County Commissioners approving this Plat see Vol. 3 page 10 of Commissioners Journal of Proceedings.

Fred K. Polvay  
County Recorder

Filed for record this 8 day of August 1911, at 1 o'clock and recorded in Vol. 3 Page 47 Volume of Plats Jackson County Oregon

Filed Sept. 6th, 1911

H. B. Coleman, Clerk.  
Myron Thompson, Spty.

See Declaration of Restrictive Covenants see Vol 350 Pgs 68-69 D.R.