ALA VISTA
ORCHARDS

Dedication:—

Know all men by these presents, that we Fred K. C. Page and Sara K. Page, husband and wife, are the owners in fee simple of the above described tract of land, and that we have subdivided the same into Lots as shown and numbered on the map of the same herewith attached and we hereby designate said tract as the Ala Vista Orchards and have so named it on the map hereto.

In Witness Whereof we have hereunto set our hands and seals this 8th day of July, 1908.

In Presence of
W. T. York
W. N. Campbell
Alice W. Goodwin } Witnesses as to
R. W. Kenney } Sara K. Page

Fred K. C. Page
Sara K. Page

Description:— The outside boundaries of the Ala Vista Orchards are as follows to wit:— Beginning at the S.E. corner D.L.C. No 47 Tp 36 S.R. 1 W.W.M., thence North 236.3 feet, thence East 2611.0 feet; thence North 1320 feet, thence West 2611 feet, thence South 236.3 feet, thence West 3495 feet; thence S. 43°05' W. 782 feet, thence South 759 feet, thence East 4028 feet to place of beginning.

I, T. W. Osgood, do hereby certify that I surveyed the above described tract as shown by the map hereon, and that the said map is a correct representation of said survey as made by me on the ground on the 19-20-21 days of June, 1908.

T. W. Osgood. C.E.

Map examined and approved this 7th day of July, 1908.

Frank A. Griesz, County Surveyor.

For order of County Commissioner's Court approving this plat see Vol 13 P. 211 of Commissioner's Journal of Proceedings. W. R. Coleman, County Clerk.
By M. B. Towne, dpy.

State of Oregon }
County of Jackson } ss.

Personally came before me, a Notary Public for said County and State, the within named Fred K. C. Page of Jackson County, State of Oregon, to me personally known to be the individual above named and who executed the above instrument and severally acknowledged to me that they executed the same freely and voluntarily for the purpose therein mentioned.

In Witness Whereof I have hereunto set my hand and official seal the day last above mentioned in said dedication.

W. T. York Notary Public for Oregon.

Notarial Seal
W. T. York.

Examined and approved this day of 1908
County Assessor.

Filed Aug. 5th, 1908.
W. R. Coleman, Co. Clerk.

State of Oregon }
County of Jackson } ss

On this the 17th day of August, 1908, before me, a Notary Public in and for said County and State, personally appeared Sara K. Page, wife of Fred K. C. Page, to me personally known to be the identical person described in and who executed the foregoing dedication of plat, and acknowledged to me that she executed the same freely ~~and~~ for the uses and purposes therein named.

Witness my hand and official seal this 17th day of Aug., 1908.

R. B. Dow,
Notary Public for Oregon.

Notarial Seal
R. B. Dow.

— Scale 1 in = 400 feet —

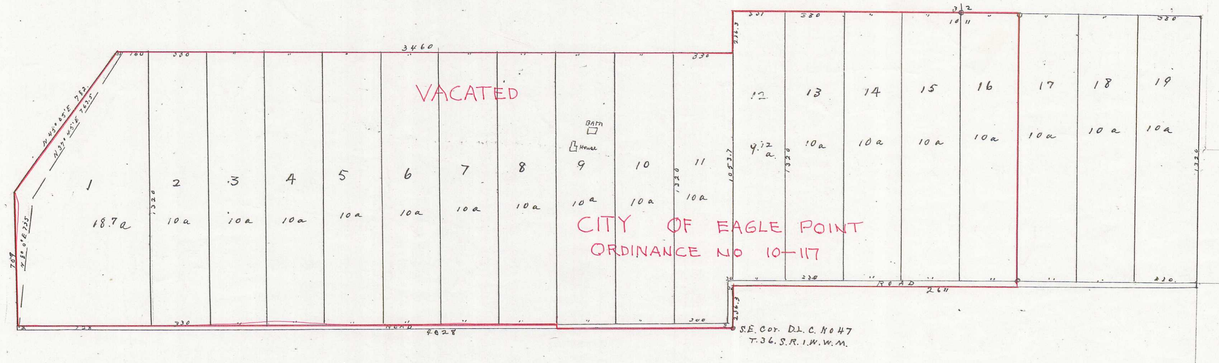

I certify that the within instrument of writing was received and filed for record at 1 o'clock P M. the 20th day of Aug. 1908 and is recorded in Volume 1 at page 130 of Plat Records of Jackson County, Oregon.

R. T. Burnett
COUNTY RECORDER.

By _____ DEPUTY.