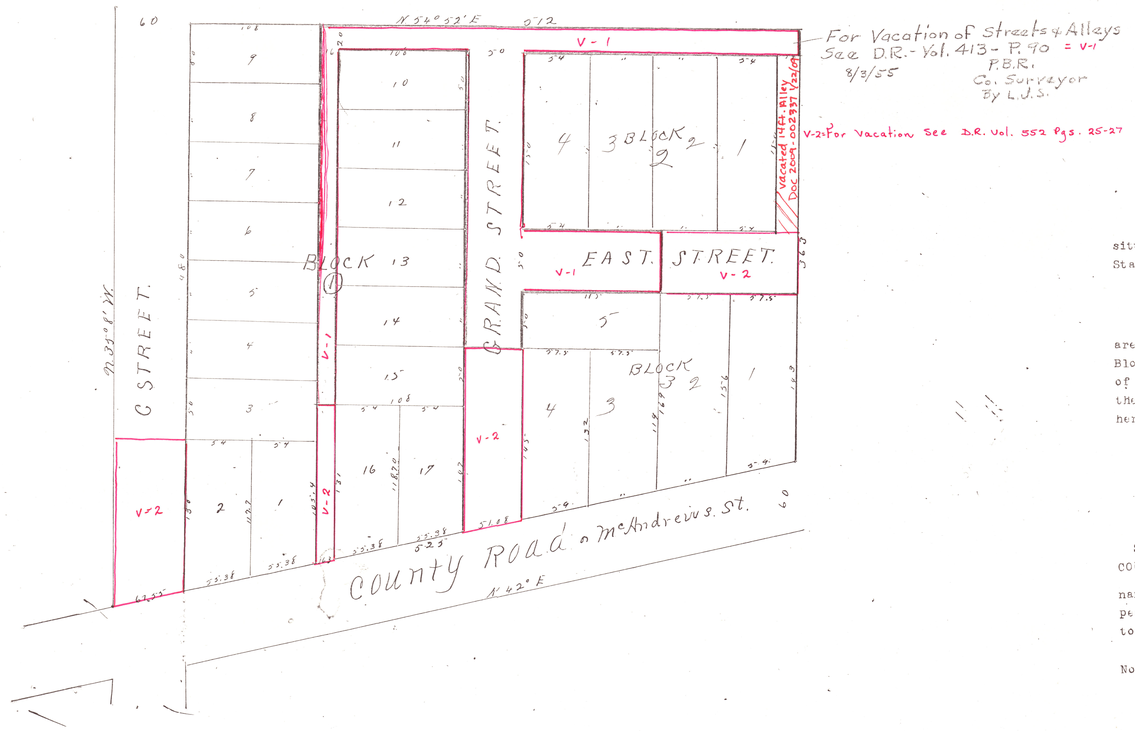

BUNKER HILL ADDITION
TO
MEDFORD:

---oooooooooo---

oooooooooooooo

DESCRIPTION

The Tract shown hereon is Lot 1 in Block 3 of the Ish Addition to Medford, Oregon, and situated in Section 24 in Township 37, South, of Range 2 West of the Willamette Meridian, in Jackson County State of Oregon, this tract joins the corporate limits of Medford on the North.

DEDICATION:

--ooOoo--

KNOW ALL MEN BY THESE PRESENTS, That we E. J. Eastman and Lora H. Eastman, husband and wife, are the owners in fee simple of the above described tract of land. that we have laid out the same into Blocks, lots, streets and alleys as shown by the map hereon; and that said map is a correct representation of said survey and the numberes of said blocks and lots and all distances in feet are plainly marked in figures thereon; and that we do hereby dedicate to the Public for Public Highways all of the streets and alleys shown hereon, and we do hereby designate and name said tract as " BUNKER HILL ADDITION TO MEDFORD" aforesaid.

IN WITNESS WHEREOF; we have hereunto set our hands and seals this 3rd day of January A.D.1908.

Done in the presence of
Fred Purdin
T. W. Miles

E. J. Eastman Seal
Lora H.Eastman Seal

STATE OF OREGON
COUNTY OF JACKSONSS:- Personally came before me, a NOtary Public in and for said County and State, the within named E. J. Eastman and Lora H. Eastman, husband and wife, of Jackson County, State of Oregon, and to me personally known to be the above named persons who executed the above instrument and severally acknowledged to me that they executed the same freely and voluntarily for the uses and purposes therein mentioned.

Done this 3rd day of January A. D. 1908

Notarial seal
T. W. Miles

T. W. Miles
Notary Public.

Examined and recommended for approval this 3rd day of January,A.D.1908
Peter Applegate, Assessor for Jackson County.Oregon.

Examined and approved this 3rd day of January A.D.1908
Frank A. Grisez, County Surveyor.

For County Commissioners order approving this plat see Vol Page of County Commissioners Journal of Proceedings.

Clerk of Jackson County.

Filed for record this 20 day of January A. D. 1908 at 9 o'clock and recorded in Vol. 1 page 53 of Plats

R. T. Burnett
Recorder for Jackson County.Or.

Filed January 13th,1908

W. R. Coleman
County Clerk.