DEDICATION.

Know all men by these presents: that we FRUIT GROWERS TRUST AND TITLE CO. an Oregon corporation are the owners of theequitable title under a contract to convey of the following described tract of land, and that we have subdivided the same into lots and streets as shown on the map of same, herewith attached, and on which the number and size of the lots and the leggths of all lines are plainly set forth and all other matters appertaining to the subdivision of said tract are shown on the map, and we hereby DEDICATE to the public, for public highways, all of the streets as shown on said map and we hereby designate said tract as the "CRESTBROOK ORCHARD TRACTS".

In witness whereof, said Corporation has caused this instrument to be signed in its corporate name by its its president and secretary this 30th day of January, 1909.

In the presence of

Fruitgrowers Trust and Title Company. By Reginald H. Parsons, Pres. Seal.

John F. Tenney.

By Worrall Wilson, Secy. Seal.

DESCRIPTION.

The outside boundaries of the CREST BOORK ORCHARD TRACTS subdivision are as follows, to wit: Commencing at the Northeast corner of Section 28, Township No. 37 South Range 1 West, thence running West 1838 ft. along North Boundary of said section to the Northwest corner: thence South 2640 ft: thence West 1535 ft.; thence South 2646 ft. to the Southwest corner; thence East 748 ft. thence North 330 ft. thence East 3249 ft. to the Southeast Corner: thence North 3960 ft: thence West 607 ft.; thence North 996 ft. to the place of beginning.

I, Harry E. Foster, do hereby certify that I surveyed the above described treact as shown by the map hereon and that the said map is a correct representat ion of said survey as made by me on the ground between the 25th and 31st days of December, 1908.

Harry E. Foster,

C. E.

Map examined and approved this 30th day of January, 1909.

Frank A. GriseZ,

County Surveyor.

Examined and approved this 7th day of April , 1909.

W. I. Grieve,

County Assessor. For order of County Commissioners Court approving this plat see Vol. 3 Page333of Commissioners It R. Coleman Journal of proceedings.

County Clerk.

State of Washington. County of King, SS.

On this 30th day of January, 1909, before me appeared Reginald H. Parsons, President and Worrall Wilson Secretary to me personally known who each being duly dworn did say that Reginald H. Parsons is president and said Worrall Wilson is Secretary of the Fruit Growers Trust and Title Co., a corporation, that executed the foregoing instrument, and that the seal affixed to said instrument is the corporate seal of the said corporation and that the said instrument was signed and sealed on behalf of the said corporation by authority of its board of Directors and said Reginald H. pArsons and said Worrall Wilson acknowledged said instrument to be their free act and deed.

IN testimoyn whereof, I have hereunto set my hand and affixed my official seal on this the day and year first above written.

Notarial Seal of John F. Tenney.

JohnF. Tenney,

Notary Public for Washington.

cartily that the within nrecord at 4 o'clock the 7 day of apr 1909 and is recorded in Volume ... et page l'alis

Scale 1 in.-200ft.

DEDICATION.

Know all men by these Presents: That we, D. H. Barneburg and Oda I. Barneburg, husband and wife, Laura B. Ferguson and James Ferguson, wife and husband, and J. M. Keene, the owners of the legal title to the lands described on the attached plat, subject to a contract to convey to Fruitgrowers Trust and Title Co., an Oregon corporation, do hereby comsent to have the same subdivided in to Lots and Streets as shown on the attacked map, and hereby join in the DEDICATION of the Streets shown on said plat to the use of the public.

In Witness Whereof, we have hereunto subscribed our names and affixed our seals this the Fifth

day of April, A. D., 1909. Witnesses.


J. M. Keene, Seal. Seal.

Geo. W. Trefren. Ruby Winter.

D. H. Barneburg, Oda I. Barneburg, Laura B. Ferguson, Seal. James H. Ferguson, Seal. (C) SX 11

This is to certify that on this 5" day of April, A. D. 1909, Efore me, the undersigned a Notary Public within and for the above named State and County, person ally appeared D. 17. Barneburg and Oda D. Barneburg. Insimple Jaura B. Ferguson and James Ferguson, her husband, and J. M. Keine, who are personally conven to me to be the identical persons named in and who executed the foregoing dedication in my presence, and there and there acknowledged to me that they executed the same freely and voluntarily and for the uses and purposes therein expressed. - In witness whereof, I have hereunto subscribed my name and affixed my notarial seal This the day and year last above written. - Notarial Seal of State of aregon, Tounty of Jackson S. On this 5th day of Spril, S. D., 1909, before me the undersigned, a notary Cubbic, within and for the above named beouty and State, appeared the above named James & Ferguson, to me known to be the individual described in and who executed the above instrument for and on behalf of the said James b. Ferguson, and acknowledged to me that she executed the same -for the uses and purposes therein set forth. In Witness Thereof I have hereunts set my hand and notarial seal the day and year last above written. - notarial Seal of

3/50

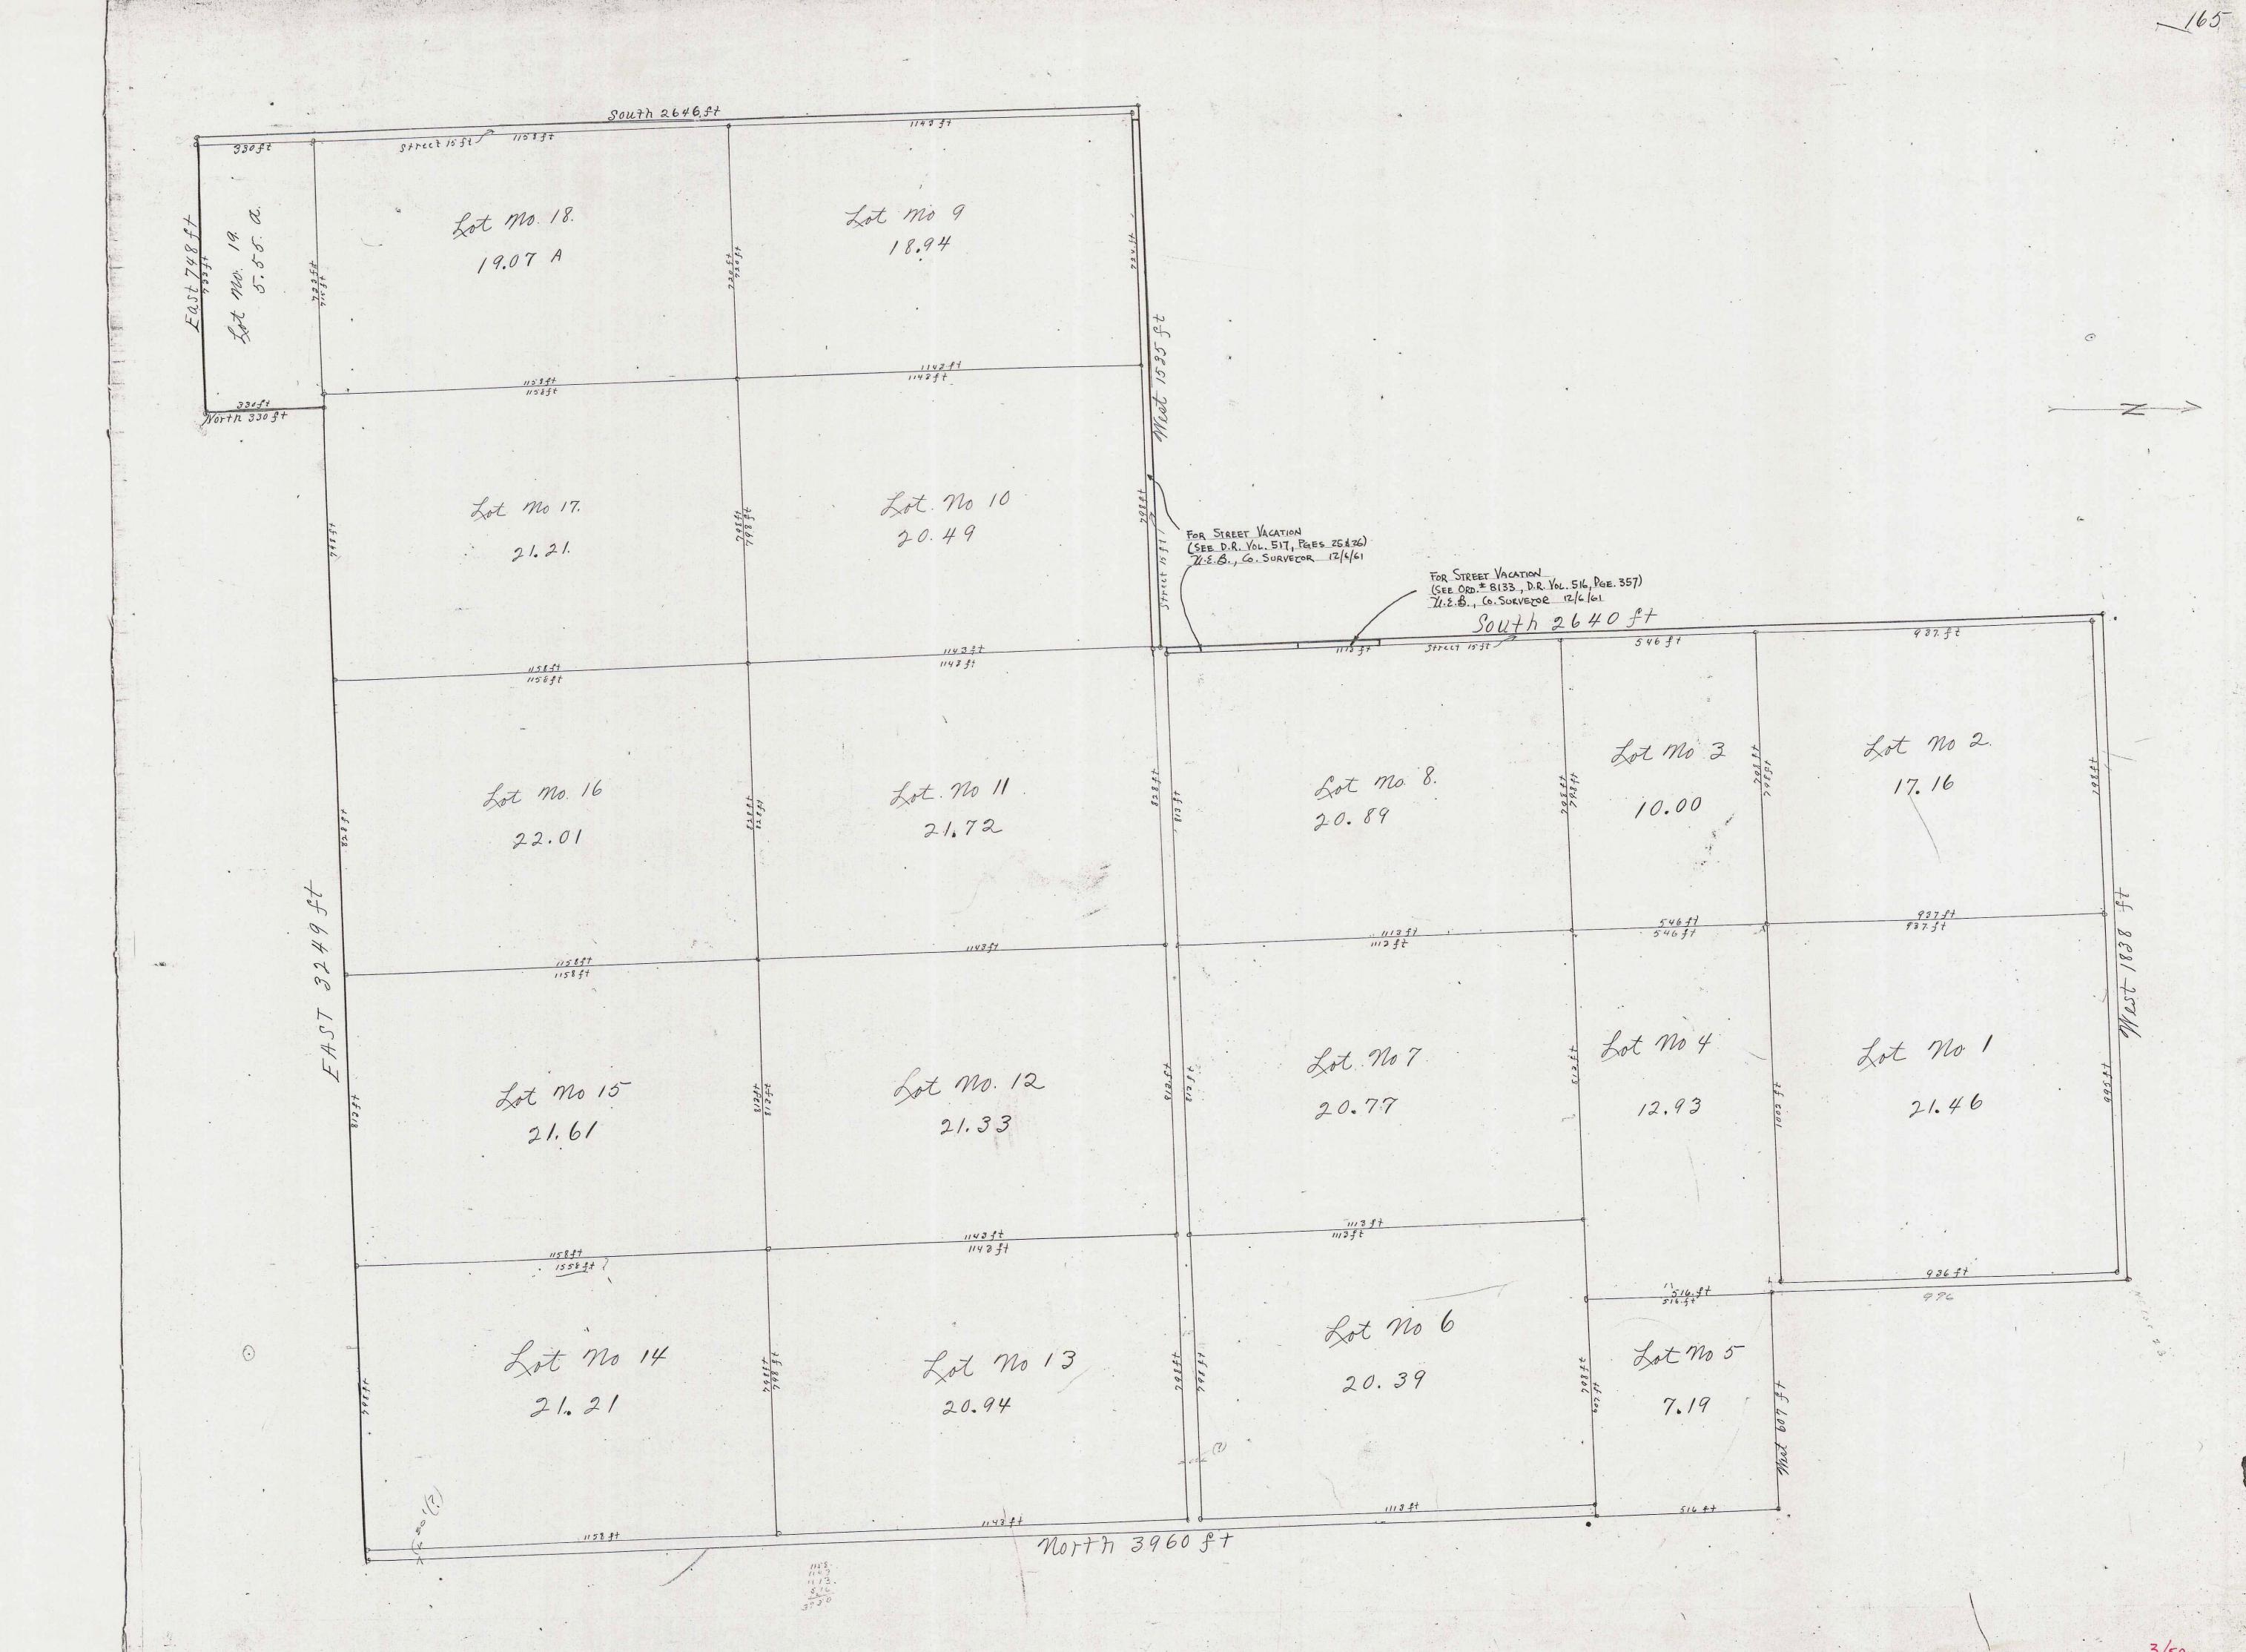

3/50