MAP SHOWING THE SUBDIVISIONS OF THE ENOCH WALKER PLACE.

SCALE, ONE INCH EQUALS EIGHT CHAINS.

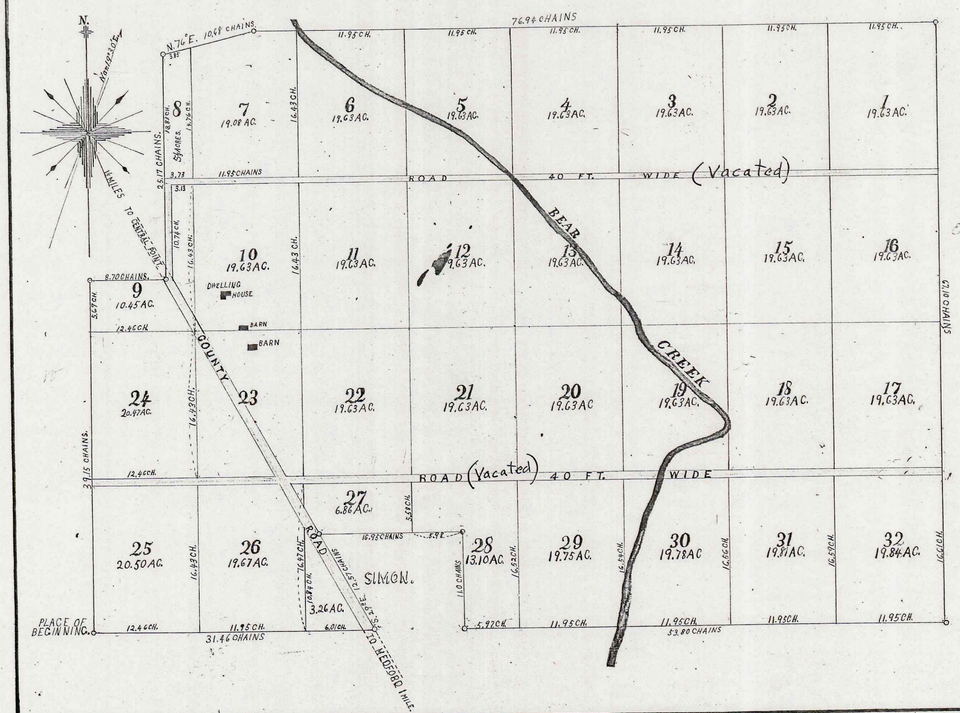

Know all Men by these Presents

That the Subdivisions Of the Enoch Walker Place comprise all of that tract known as the D.A. Rice Donation Claim No. 59 in Township Thirty-seven South, Range Two West of the Willamette Meridian, and Claim No. 38 in Township Thirty-seven South, Range One West of the Willamette Meridian, Jackson County, Oregon, and is described as follows, to-wit: Beginning at the southwest corner of said claim; thence north on the west boundary line of said claim thirty-nine chains and fifteen links (N. 15.65 ch.); thence east eight chains and seventy links (E. 8.70 chs.); thence north twenty-five chains and seventeen links (N. 25.17 ch.); thence north, seventy-six degrees east ten chains and sixty-eight links (N. 76° E. 10.68 chs.) to a point on the north boundary line of said claim; thence east on said north line seventy-six chains and ninety-four links (E. 76.94 chs.) to the north-east corner of said claim; thence south on the east boundary line of said claim sixty-seven chains and ten links (S. 67.10 chs.) to the south-east corner of said claim; thence west on the south boundary of said claim fifty-three chains and eighty links (W. 53.80 chs.); thence north eleven chains (N. 11 chs.); thence west sixteen chains and ninety-five links (W. 16.95 chs.); thence south twenty-nine degrees east twelve chains and fifty-seven links (S. 29° E. 12.57 chs.) along the County Road to the south boundary of said claim; thence west along said south line thirty-one chains and forty-six links (W. 31.46 chs.) to the place of Beginning. Containing 570.50 Acres, more or less.

We Enoch F. Walker and Prudence M. Walker, husband and wife, do hereby certify that we are the owners in fee simple of the above premises and that we have caused the same to be surveyed and platted into lots and public roads as shown on this map, and we hereby dedicate to the use of the public forever all of the roads shown on this map.

In Witness Whereof we have hereunto set our hands and affixed our seals this 17th day of April, A.D. 1894.

Witnessed by D.F. Lawton. Minnie Marsh.

Enoch F. Walker L.S.
Prudence Walker L.S.

State of Oregon, County of Jackson } ss.

Before me D.F. Lawton a Notary Public in and for the State of Oregon on this 17th day of April, A.D. 1894 personally appeared before me Enoch F. Walker and Prudence M. Walker, his wife, to me personally known to be the individuals who executed the foregoing instrument and they acknowledged to me that they executed the same freely and voluntarily for the uses and purposes therein set forth.

In Witness Whereof I have hereunto set my hand and affixed my official seal the day and year in this certificate first above written.

D.F. Lawton.
Notary Public, in and for the State of Oregon, Residing at Medford, Jackson County.

Notarial Seal.

State of Oregon, County of Jackson } ss. I hereby certify that the annexed instrument and Plat were received and duly filed for record on the 2nd day of October, A.D. 1894, at 3:00 o'clock P.M.

Grant Rawlings, County Recorder.

For vacation of roads see
Commissioner's Journal
Vol. 11 Page 136
Paul B. Agnew
Co. Surveyor
12/11/30

3/69