

THE CITY OF MEDFORD
0000000000

KNOW ALL MEN BY THESE PRESENTS, That we, Carl T. Jones, and Judith A. Jones, husband and wife, O.D. Owen, and Elizabeth F. Owen, husband and wife, and Edward E. Riser and Vesta A. Riser, husband and wife, and I.L. Hamilton and Enola Hamilton, husband and wife, and O.O. HULL an unmarried man, all of the County of Jackson and State of Oregon, owners by an indefeasible, and unencumbered title in fee simple of all those certain tracts of land described in the attached certificate of Carl T. Jones, surveyor, to which reference is hereby made for a full and complete description of said property; Said Carl T. Jones being the owner of that portion thereof designated on this plat as Lots 1, 2, 3, 4, 5 and 6, and O.D. Owen being the owner of all that portion thereof designated on said plat as lots 16, 17, 18, 19, 20, 21, 22, 23, and 24; and Edward E. Riser being the owner of all that portion thereof designated on said plat as Lots No 25, 26, 27, 28, 29, and 30; and I.L. Hamilton being the owner of all that portion thereof designated as said plat as Lots No 31, 32, 33, 34, 35, 36, 37, 38, 39, 40, 41, and 42; and O.O. Hull being the owner of all that portion designated as this plat as Lots No 7, 8, 9, 10, 11, 12, 13, 14, 15; and School District No 49 being the owner of that portion designated as North School Block; do hereby acknowledge, certify and declare that we have caused said land above described, to be surveyed, subdivided into lots, street and alleys as indicated and shown by the attached plat thereof; and have designated, and do hereby designate the same HIGHLAND ADDITION to the CITY OF MEDFORD, that we have caused said attached plat of said Addition to be made. That the same is a true and correct plat of said Addition; that the disposition of said tracts of land made by said plat is in accordance with our free wish and desire, and we hereby dedicate to the use of the public all that portion of said land which is designated on said plat as streets and alleys.


IN TESTIMONY WHEREOF, we have hereunto set our hands and seals this 30 day of November A.D. 1906.

Carl T. Jones Seal
Judith A. Jones Seal
O.D. Owen Seal
Elizabeth T. Owen Seal
Edward E. Riser Seal
Vesta A. Riser Seal
I.L. Hamilton Seal
Enola Hamilton Seal
O.O. Hull Seal

STATE OF OREGON SS:-
COUNTY OF JACKSON On this 30th day of November A.D. 1906, before me the undersigned, a Notary Public within and for the State of Oregon, residing in Jackson County, personally appeared Carl T. Jones, and Judith A. Jones, his wife, O.D. Owen and Elizabeth F. Owen his wife, Edward E. Riser and Vesta A. Riser, his wife, I.L. Hamilton and Enola Hamilton his wife, and O.O. HULL an unmarried man, all of Jackson County Oregon, to me personally known to be the individuals named and described in and who executed the above instrument and severally acknowledged to me that they executed the same freely and voluntarily, and the plat therein mentioned Witness my hand and Notarial seal hereunto affixed the day and year above written.

M. Purdin Notary Public
Accepted by the Council of the City of Medford at their Meeting on the day of A.D. 1906.

Recorder of the City of Medford.

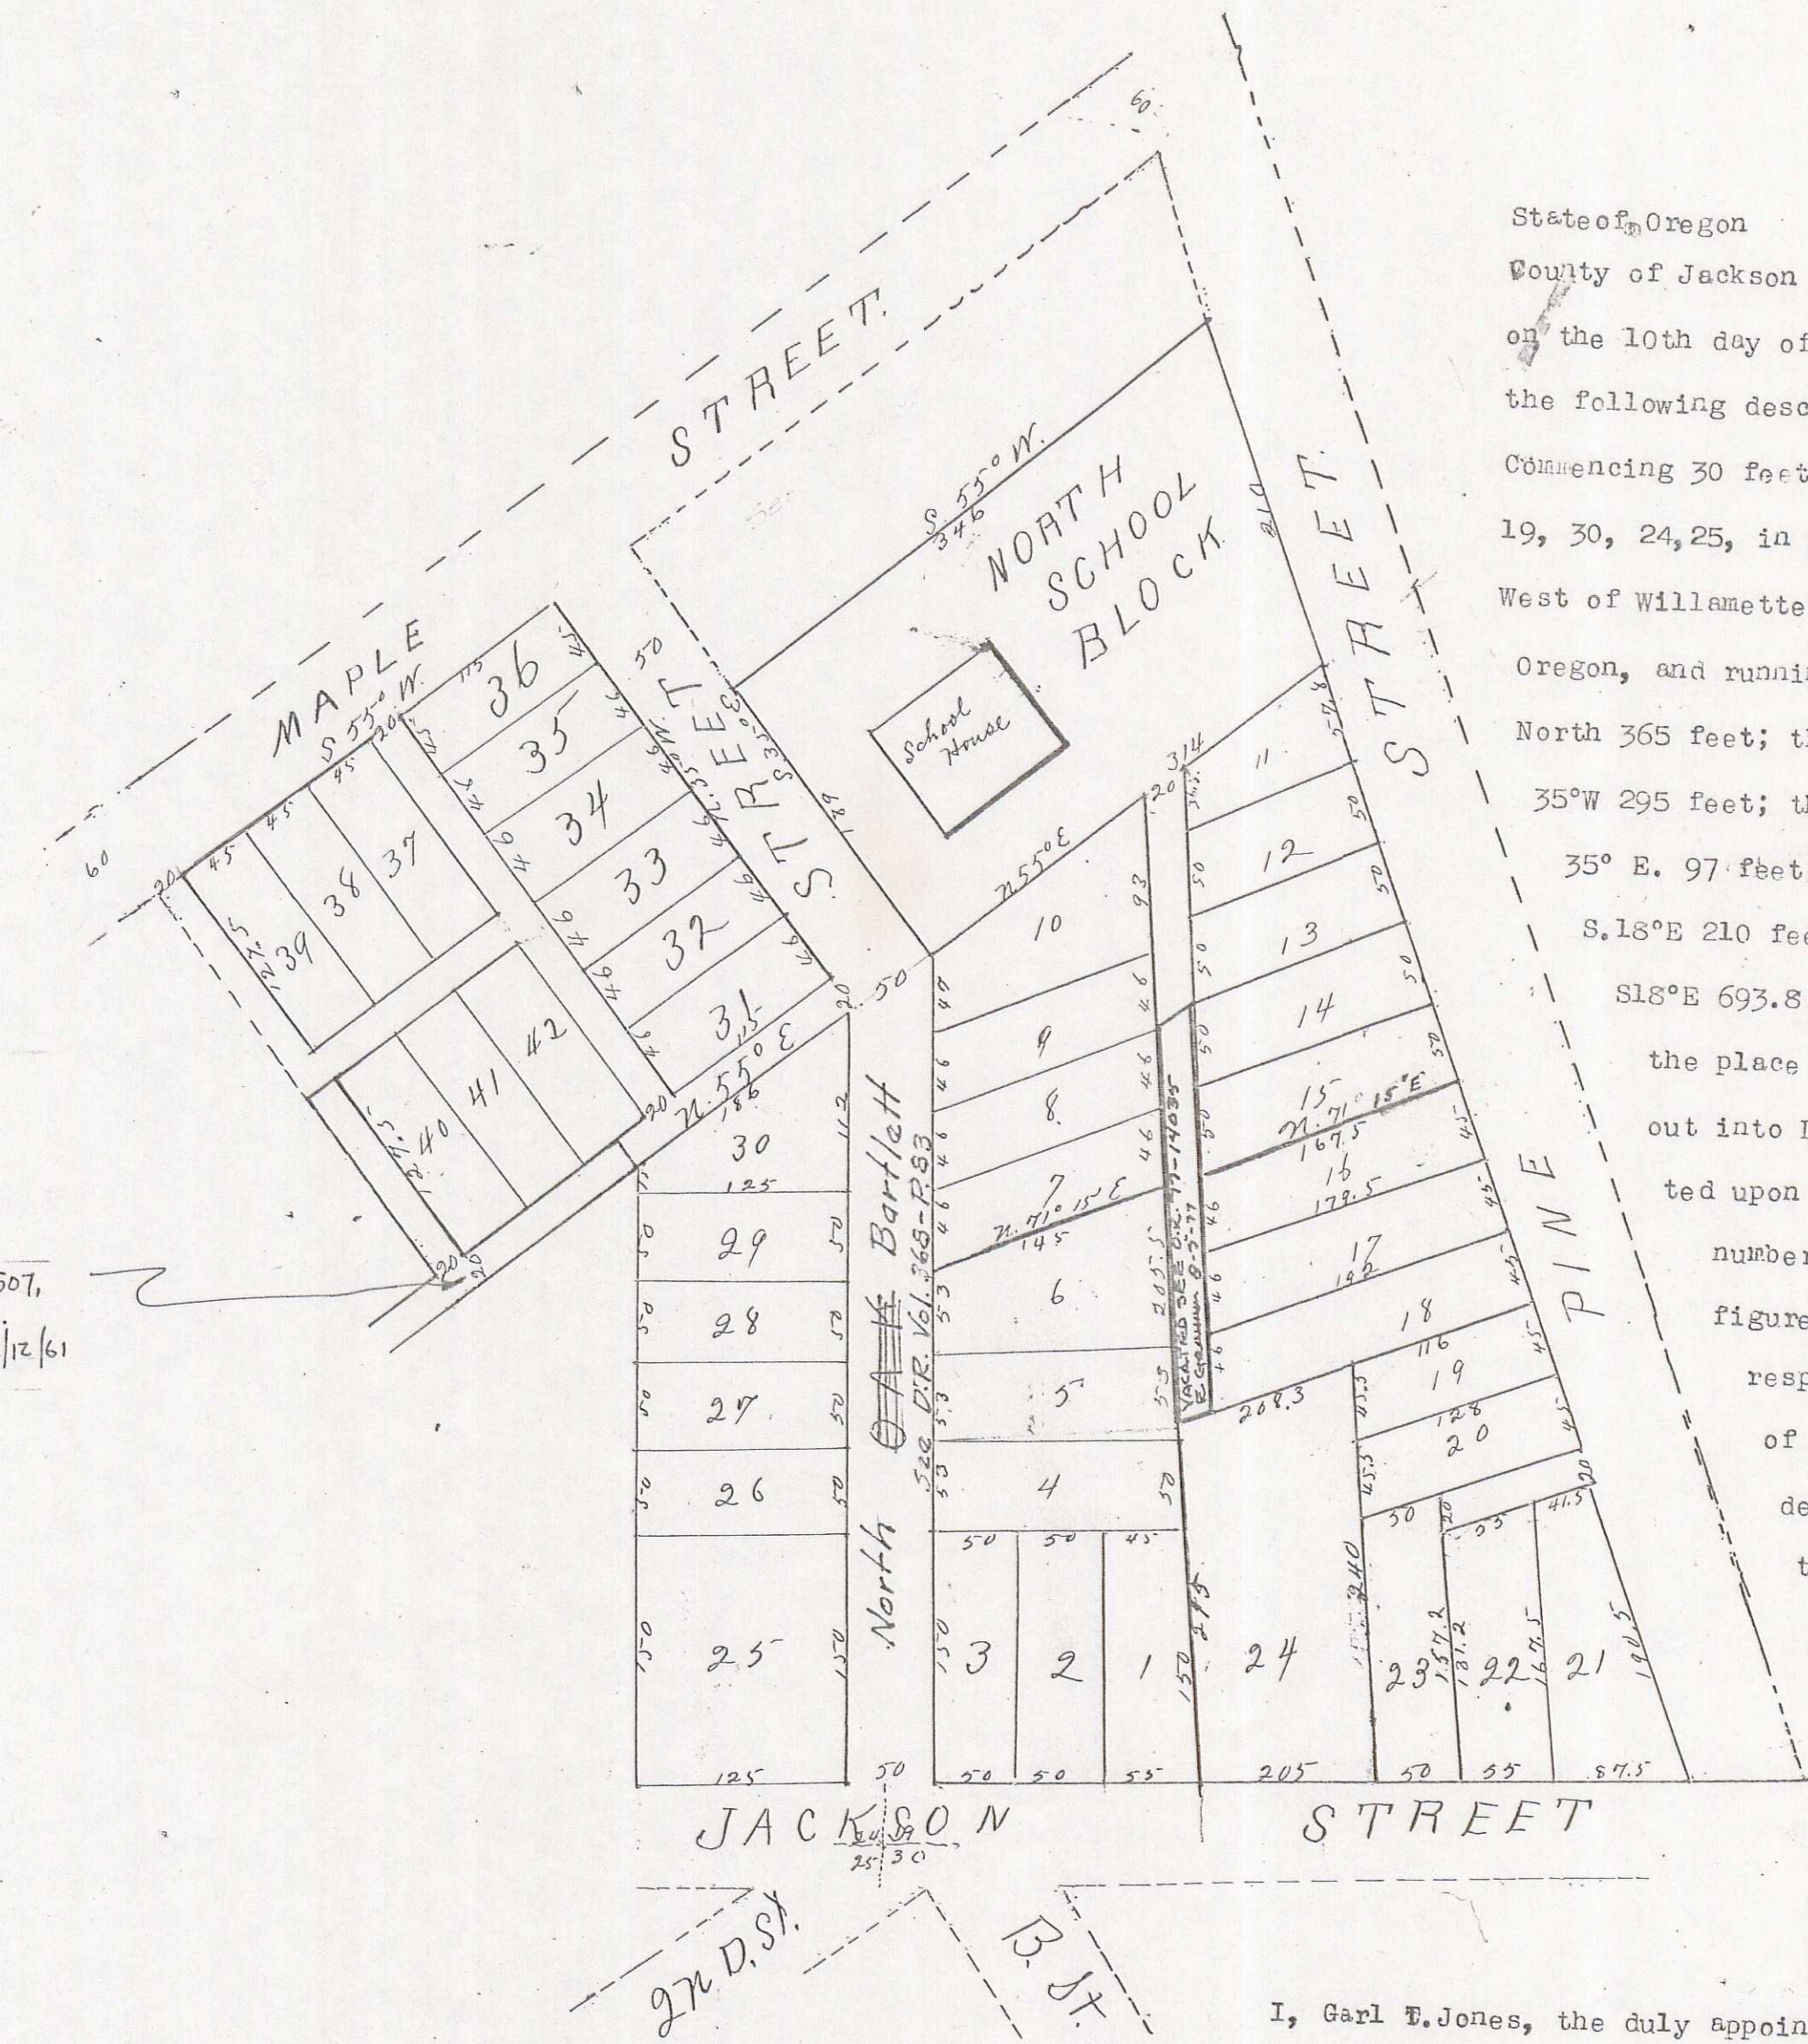

State of Oregon
County of Jackson SS:- I hereby certify that on the 10th day of November A.D. 1906, I surveyed the following described tract of land to-wit. Commencing 30 feet North of the corner of Sections 19, 30, 24, 25, in Township 37 South Range 1 and 2 West of Willamette Meridian, in Jackson County, Oregon, and running thence West 150 feet; thence North 365 feet; thence S55° W. 109 feet; thence North 35° W 295 feet; thence N. 55° E. 295 feet; thence S. 35° E. 97 feet; thence N. 55° E 401 feet; thence S. 18° E 210 feet; thence S. 55° W 30 feet; thence S. 18° E 693.8 feet; thence West 477.5 feet; to the place of beginning. That I laid the same out into Lots, street and alleys, as represented upon the plat hereto connected. The numbers of said lots are indicated by figures near the center thereof, respectively, and the dimensions of said lots are indicated by figures denoting feet near the boundaries thereof, and that the plat is a full true and correct representation of said survey.

Carl T. Jones
Surveyor.

I, Carl T. Jones, the duly appointed City engineer of the City of Medford, Oregon, hereby certify that the Map of the HIGHLAND ADDITION to the CITY OF MEDFORD, is correct and do hereby approve the same. Carl T. Jones
Done this day of Dec A.D. 1906. City Engineer of Medford.

Examined and approved on this 5 day of Dec. A.D. 1906
Peter Applegate
Assessor for Jackson County.

Filed in my office for presentation to the City Council for their action this 4 day of Dec. A.D. 1906.
Benj. M. Collins
Recorder for City of Medford.

FOR ALLEY VACATION
See Ord # 1995, Vol. 507,
Pg. 380, Deed Records,
11/2 B. Purdin, G. Sater. 9/12/01

Approved by the City Council for the City of Medford at their meeting of the same held the day of A.D. 1906. For action of Council see Journal of Board proceedings Vol Page in Recorder's office, said city.

Recorder for City of Medford

State of Oregon
County of Jackson SS
For order of County Court approving this plat see Vol Page of Commissioner's Journal of Jackson County.
W. R. Coleman
County Clerk, Jackson County

Filed for Record this 5th Day of December A.D. 1906 at 1 o'clock P.M. and recorded in Vol 1 of Plats at Page 25, Records of Jackson County.

R. T. Burnett
County Recorder of Jackson County.