


Helms' Addition to Medford.

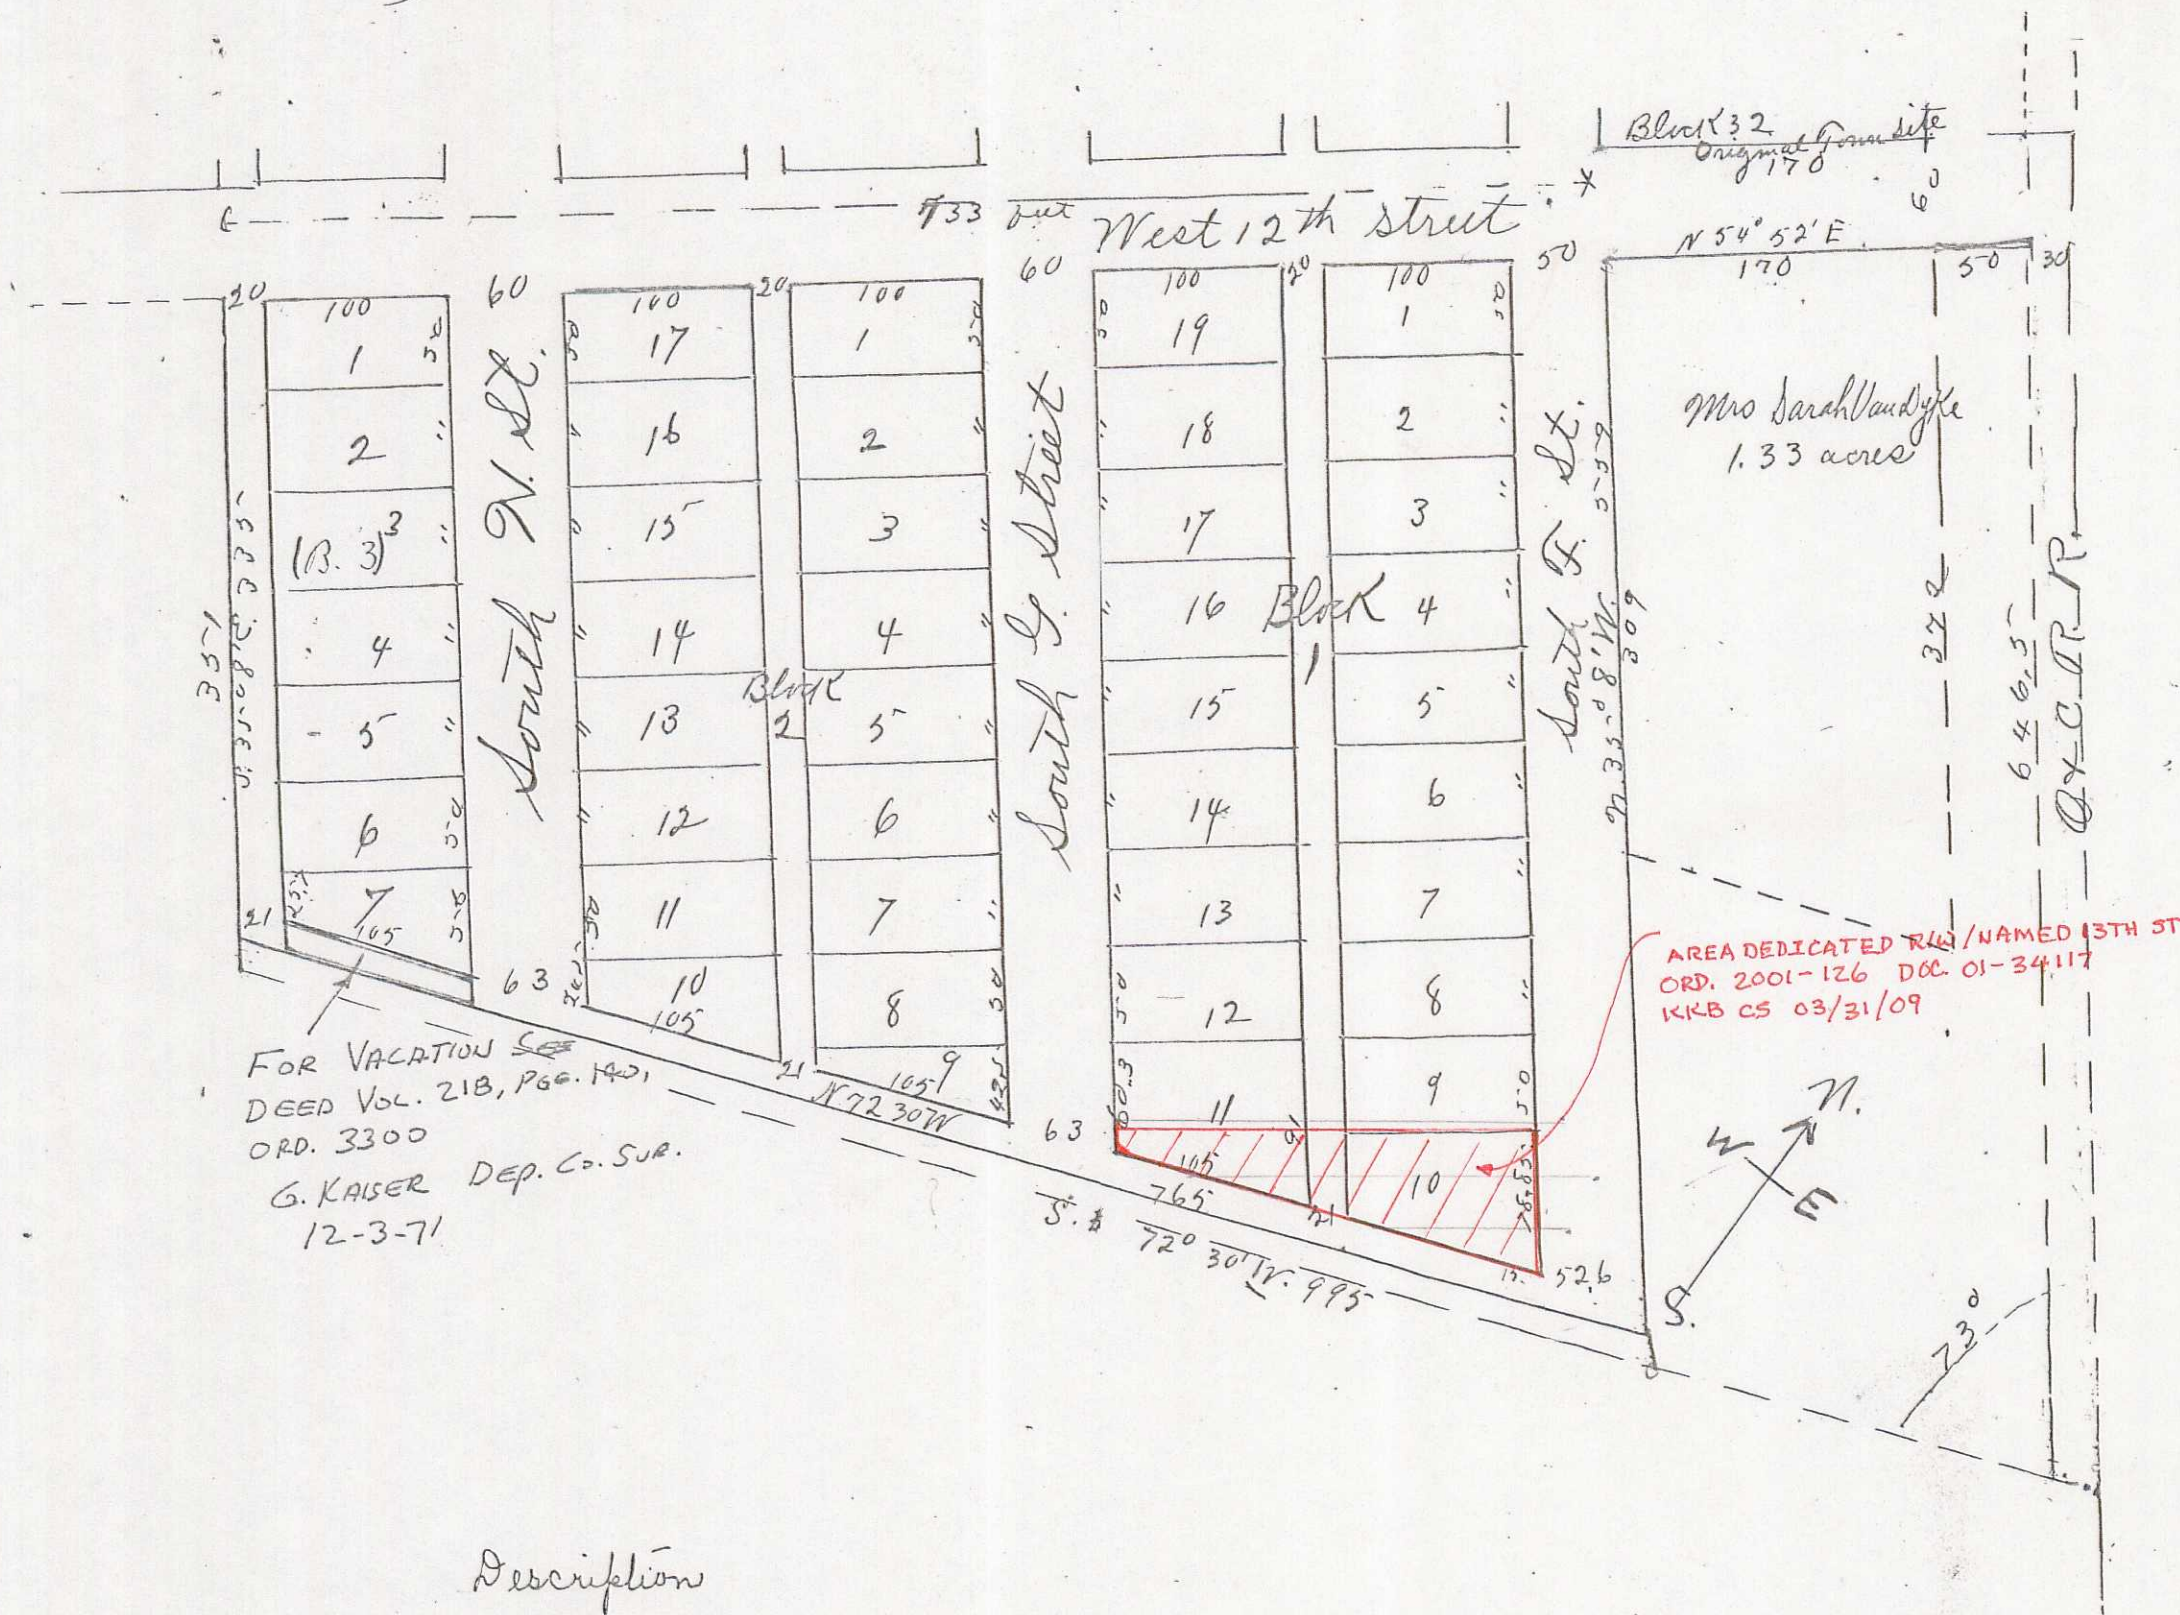

Description

Commencing at a point on the South line of West 12th Street of the City of Medford, Jackson County Oregon, S 85° 46' E, 60 feet from the south-west corner of Block 32 (original Townsite) and running thence; S 04° 52' West along the South line of the Street 120 feet; thence S 35° 8' E, 335 feet; thence North 72° 30' E, 165 feet; N 35° 8' W 559 feet to the place of beginning, certified correct. J. B. Howard, Surveyor.

Dedication

Know all men by these presents that we A. B. Helms and Mary B. Helms (husband and wife) are the owners in fee simple of the above described tract of land and that we have laid out the same into Blocks, lots, Streets, and Alleys as shown hereon, and that said map is a correct representative of said survey and subdivisions and we do hereby dedicate to the public for public highways all of the Streets and Alleys shown on said map, and we hereby designate and name said tract as named here on as the Helms Addition to the City of Medford; aforesaid, the same being within the corporate limits of said City. In witness whereof we have hereunto set our hands and seals this 28 day of May A.D. 1907.

Sons in presence of
 F. B. Engle.
 L. L. Mulit.

A. B. Helms Seal
 Mary B. Helms Seal

Filed June 22nd, 1907.
 W. R. Coleman, County Clerk.

Filed for record the 15th day of July, 1907 at 8 o'clock A.M. and recorded Vol 1 page 39 of Plats.
 R. J. Burnett, Sec. Rec. of Jackson County
 Mary Peter 1907.

State of Oregon.

County of Jackson ss:

Personally came before me a Notary Public in for said County and State the within named A. B. Helms and Mary B. Helms (husband and wife) all of Jackson County, State of Oregon, to me personally known to be the above named, and who executed the above instrument and severally acknowledge to me that they executed the same freely and voluntarily for the purposes therein mentioned.

Notary seal of
 L. L. Mulit

L. L. Mulit.
 Notary Public.

Examined and recommended for approval by the City Council for Medford, Oregon on the 27th day of May A.D. 1907.

J. B. Howard
 City Engineer.

Filed in the City Recorder's office this 29th day of May A.D. 1907.

Benj. M. Collins.
 Recorder for the City of Medford, Or.

Examined and approved this 22nd day of June 1907. Peter Applegate

Assessor for Jackson County, Oregon.

For order of County Commissioners Court approving this plat see Volume 13 page 57 of Commissioners Journal of proceedings

W. R. Coleman,
 Clerk of Jackson County Oregon.

Accepted by the Council for the City of Medford, Oregon this day - 1907. See Journal of proceedings Vol - page -

Recorder for City of Medford, Or.