


HIGHCROFT ADDITION TO THE CITY OF MEDFORD

SCALE: 1 in. = 100 FT.
MEDFORD, ORE. H.G. STOECKMANN,
JANUARY 11, 1911. CIVIL ENGINEER.

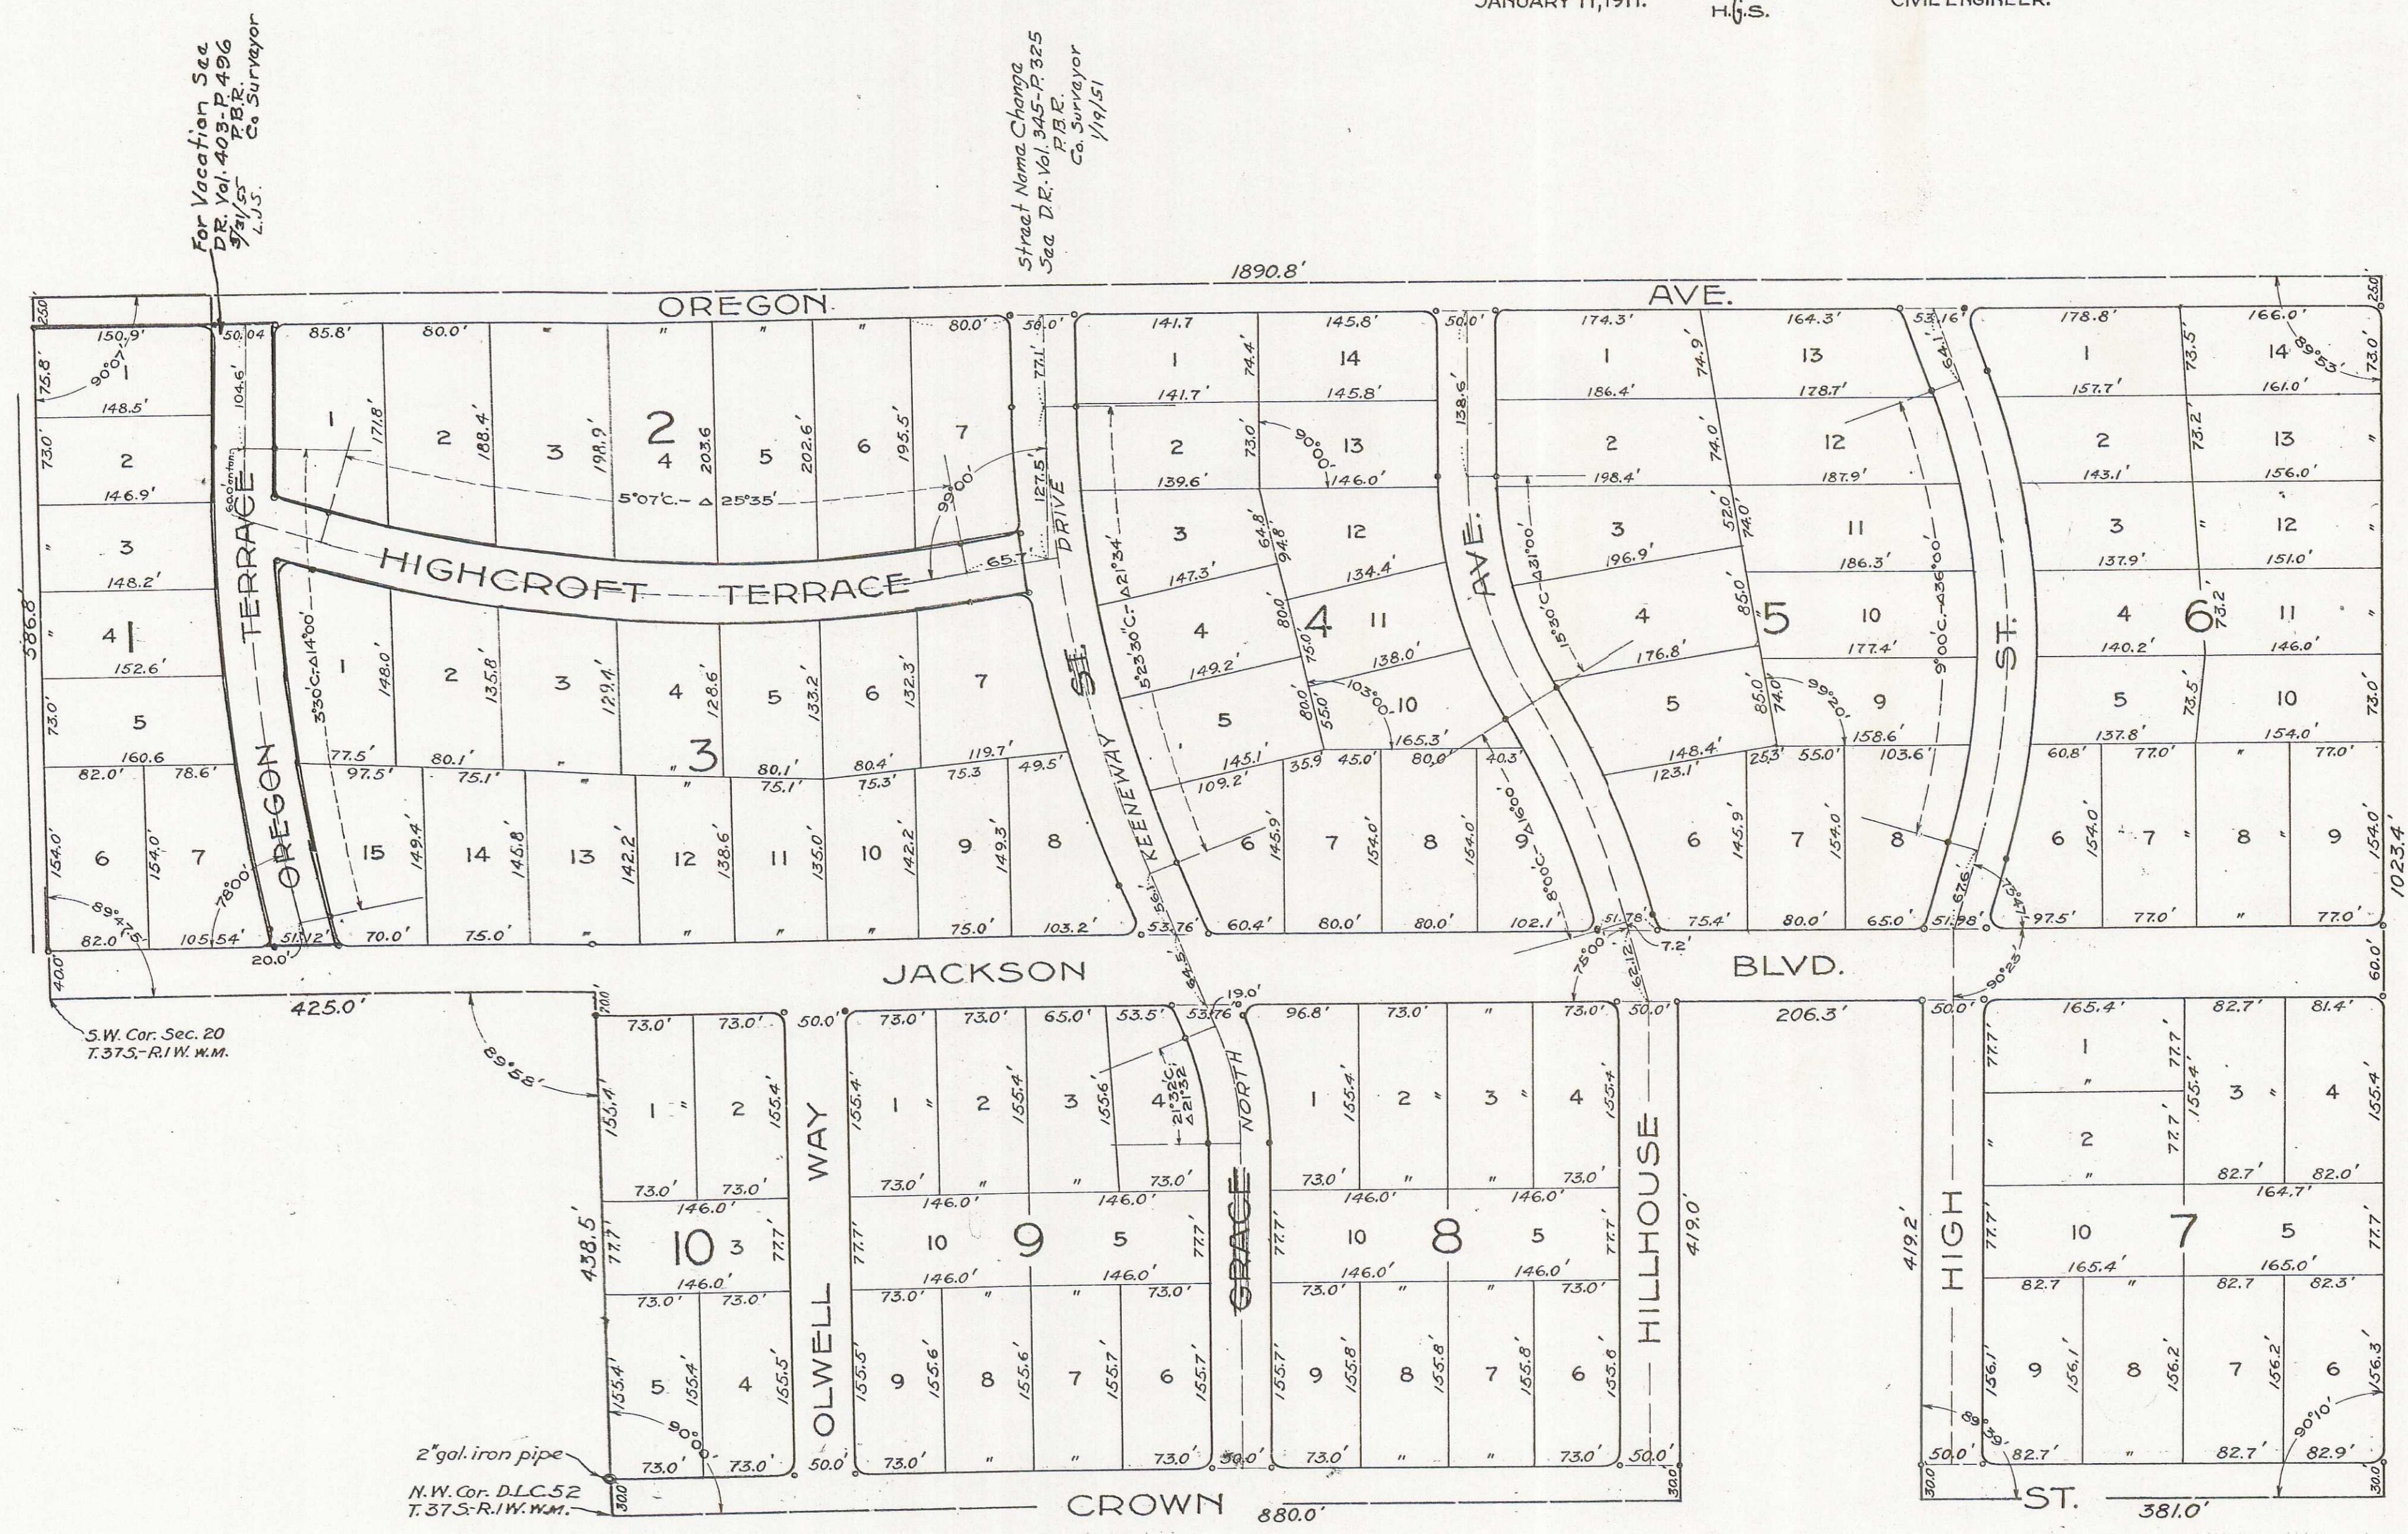

For Vacation See
DR. Vol. 409 - P. 496
9/21/51
Co. Surveyor
L.J.S.

Street Name Change
See DE. Vol. 345 - P. 325
P.B.E.
Co. Surveyor
1/19/51

REFERENCE
Initial Point - 2 in. gal. iron pipe 3 ft. long driven to below the surface of ground, with 1/2 in. gal. iron pipe inside, center of which is Initial Point - Shown thus A 1/2 in. gal. iron pipe driven at each Corner, and Point of Curve and Point of Tangent on block lines - Shown thus All Block Corners rounded on radius of 10'

DESCRIPTION Beginning at the N.W. Cor. of D.L.C. 52 - T.37S.-R.1W.W.M. from which the center of a 2" gal. iron pipe bears North 30.0'; thence E. on N. line of D.L.C. 52 - 880.0'; thence N. 419.0'; thence N 69° 58' E. 206.3'; thence S 0° 21' W. 419.2'; thence E. on said N. line of D.L.C. 52 - 381.0'; thence N 0° 10' E. 1023.4'; th. N. 89° 51' W. - 189.8'; thence S 0° 10' W. - 886.8' to S.W. Cor. of Sec. 20 - T.37S.-R.1W.W.M.; thence N. 69° 58' E. - on Sec. line 425.0'; thence South 438.5' to place of beginning.

DEDICATION Know all Men by these Presents: That we HIGHCROFT, an Oregon Corporation, are the owners of the equitable title under a contract to convey of the above described tract of land, and that we have subdivided the same into Blocks, Lots and Streets as shown hereon, and that we do hereby DEDICATE to the Public, for Public use, all of the Streets as shown hereon.
In witness whereof, said Corporation has caused this instrument to be signed in its corporate name by its president and secretary this 23rd day of January, A.D. 1911.
In presence of
H.G. Stockmann, President
A.C. Abrams, Secretary

STATE OF OREGON } S.S.
COUNTY OF JACKSON }
On this 23rd day of January, A.D. 1911 before me, a Notary Public within and for the above named state and county, appeared John D. Olwell, President, and A. Conro Fiero, Secretary, to me personally known, who, each being duly sworn, did say that said John D. Olwell is president, and said A. Conro Fiero is secretary of HIGHCROFT, the corporation that executed the foregoing instrument, and that the seal affixed to said instrument is the corporate seal of said corporation and that said instrument was signed and sealed on behalf of said corporation by authority of its Board of Directors, and said John D. Olwell and said A. Conro Fiero acknowledged said instrument to be the free act and deed of said corporation.
In witness whereof, I have hereunto set my hand and affixed my official seal on this the 23rd day first above written.
J.E. Barkdull
Notary Public for Oregon.

CONSENT TO DEDICATION Know all Men by these Presents: That we, Margaret Buckley, widow of James Buckley, also Kate M. Andrew, daughter of Thomas M. Andrew, also Maggie Burroughs and Grant Burroughs, wife and husband, also William Clark and Minnie Clark, husband and wife, the owners of the legal title to the land above described, subject to a contract to convey to HIGHCROFT, an Oregon Corporation, do hereby consent to have the same subdivided as shown hereon, and hereby join in the Dedication of the Streets as shown hereon, to the use of the Public.
In witness whereof, we have hereunto subscribed our names and affixed our seals - William Clark and Minnie Clark, husband and wife, through Wm S. Crowell their attorney in fact - this 23rd day of January, A.D. 1911.
In presence of
Margaret Buckley
Kate M. Andrew
Maggie Burroughs
Grant Burroughs
William Clark
Minnie Clark
William S. Crowell
Their Attorney in fact

STATE OF OREGON } S.S.
COUNTY OF JACKSON }
On this 23rd day of Jan. A.D. 1911, before me, a Notary Public within and for the above named state and county, personally appeared Margaret Buckley, widow of James Buckley, Kate M. Andrew, daughter of Thomas M. Andrew, Maggie Burroughs and Grant Burroughs, wife and husband, and Wm S. Crowell, attorney in fact for William Clark and Minnie Clark, husband and wife, to me personally known to be the above named persons, and who executed the foregoing instrument, and who acknowledged to me that they executed the same freely for the purposes therein mentioned.
In witness whereof, I have hereunto set my hand and affixed my official seal on this the 23rd day first above written.
J.E. Barkdull
Notary Public for Oregon.

STATE OF OREGON } S.S.
COUNTY OF JACKSON }
I, H.G. Stockmann, being first duly sworn, do hereby certify, that I have duly surveyed and marked with proper monuments, the above described tract of land, as shown by the plat hereon and that said plat is a correct representation of said survey as made by me on the ground between August 20 and December 13, A.D. 1910.
H.G. Stockmann
Civil Engineer.

Subscribed and sworn to before me this 12th day of January, A.D. 1911.
John Guy Wilson
Notary Public for Oregon.
Examined and recommended for approval of County Commissioners Court this 1st day of Feb. A.D. 1911.
Frank A. Guss
County Surveyor.

For order of County Commissioners approving this Plat see Vol. 14 Page 78 of Commissioners Journal of Proceedings.
H.K. Coleman
County Clerk.
Examined and approved this 1st day of Feb. A.D. 1911.
A.T. Grieve
County Assessor.
Filed for Record this 11 day of Feb. A.D. 1911 at 10 o'clock and recorded in Vol. 3 of Plats Page 30 Records of Jackson County.
Fred W. Long
County Recorder.
By Mary Peter Spay

Filed Jan. 1st 1911
W. H. Woodman
Clerk
3/99