

JACKSON'S SECOND ADD. TO MEDFORD.

DESCRIPTION.

Starting at a point 4.62 ft. West of the S. E. corner of D. L. C. No. 42 Twp. 37 S. R. 1 W. M. and running thence South 769.56 ft. to the Corporate Boundary Line of the City of Medford, Ore.; thence South 78° W. along said Corporate Boundary Line 166.12 ft.; thence North 805.21 ft.; thence east 162.5 ft. to the place of beginning.

DEDICATION:

Know all men by these presents that we L. H. Tucker and A. M. Tucker (husband and wife) and Geo. A. Jackson and Sarah A. Jackson (husband and wife) are the owners in fee simple of the above described tract of land, that we have laid out the same in to Block, Lots, Streets, and Alleys, as shown by the map hereon and that said map is a correct representation of said survey and subdivisions, and that we do hereby Dedicate to the Public for Public Highways all the Streets as shown by the map of said Tract hereon and hereby Designate and name said Tract as shown hereon as Jackson's Second Addition to Medford, Ore. and name the Streets as shown by said map, in witness whereof We have hereunto set our hands and seals This day of March, A. D., 1909.

Done in the presence of

Etta E. Tucker.  
W. H. Jackson.

L. H. Tucker, Seal  
A. M. Tucker, Seal  
Geo. A. Jackson, Seal  
Sarah A. Jackson, Seal

State of Oregon,  
County of Jackson, SSs

Personally came before me a Notary Public in and for said County and state the within named L. H. Tucker and A. M. Tucker (husband and wife) and Geo. A. Jackson and Sarah A. Jackson (husband and wife) all of Jackson County, State of Oregon, to me personally known to be the within named, and who executed the above instrument, and severally acknowledged that they executed the same freely and voluntarily for the purposes therein mentioned.

Notarial Seal of W. B. Jackson, Notary Public for Oregon.

Examined and redommed for approval this 29 day of March, A. D., 1909.

W. T. Grieve, Assessor for Jackson County.

For order of County Commissioner approving this plat see Vol. 13 Page 332 of County Commissioners Journal of proceedings.

W. R. Coleman Clerk of Jackson County.

Filed for record this 7 day of Apr. A. D., 1909, at 4 o'clock and recorded in Vol. 1 Page 163 of Plats.

Copy of Plat filed in my office this 29 day of March A. D., 1909.

Harry E. Foster, City Engineer for Medford.

Approved by the City Council this 29<sup>th</sup> day of March, A. D., 1909.

Benj. M. Collins, Recorder for Medford, Ore.

Presented and accepted by the City Council this 6<sup>th</sup> day of April, A. D., 1909.

Benj. M. Collins, Recorder for Medford, Ore.

Filed April 7, 1909.

W. R. Coleman, Clerk.


By M. B. Towne, Deputy.

Filed in the office of the City Recorder at 3:20 P. M. This 29<sup>th</sup> day of March, 1909.

Benj. M. Collins, City Recorder.

Acted on by the City Council.

This \_\_\_ day of \_\_\_ 190\_\_ AND \_\_\_ City recorder.

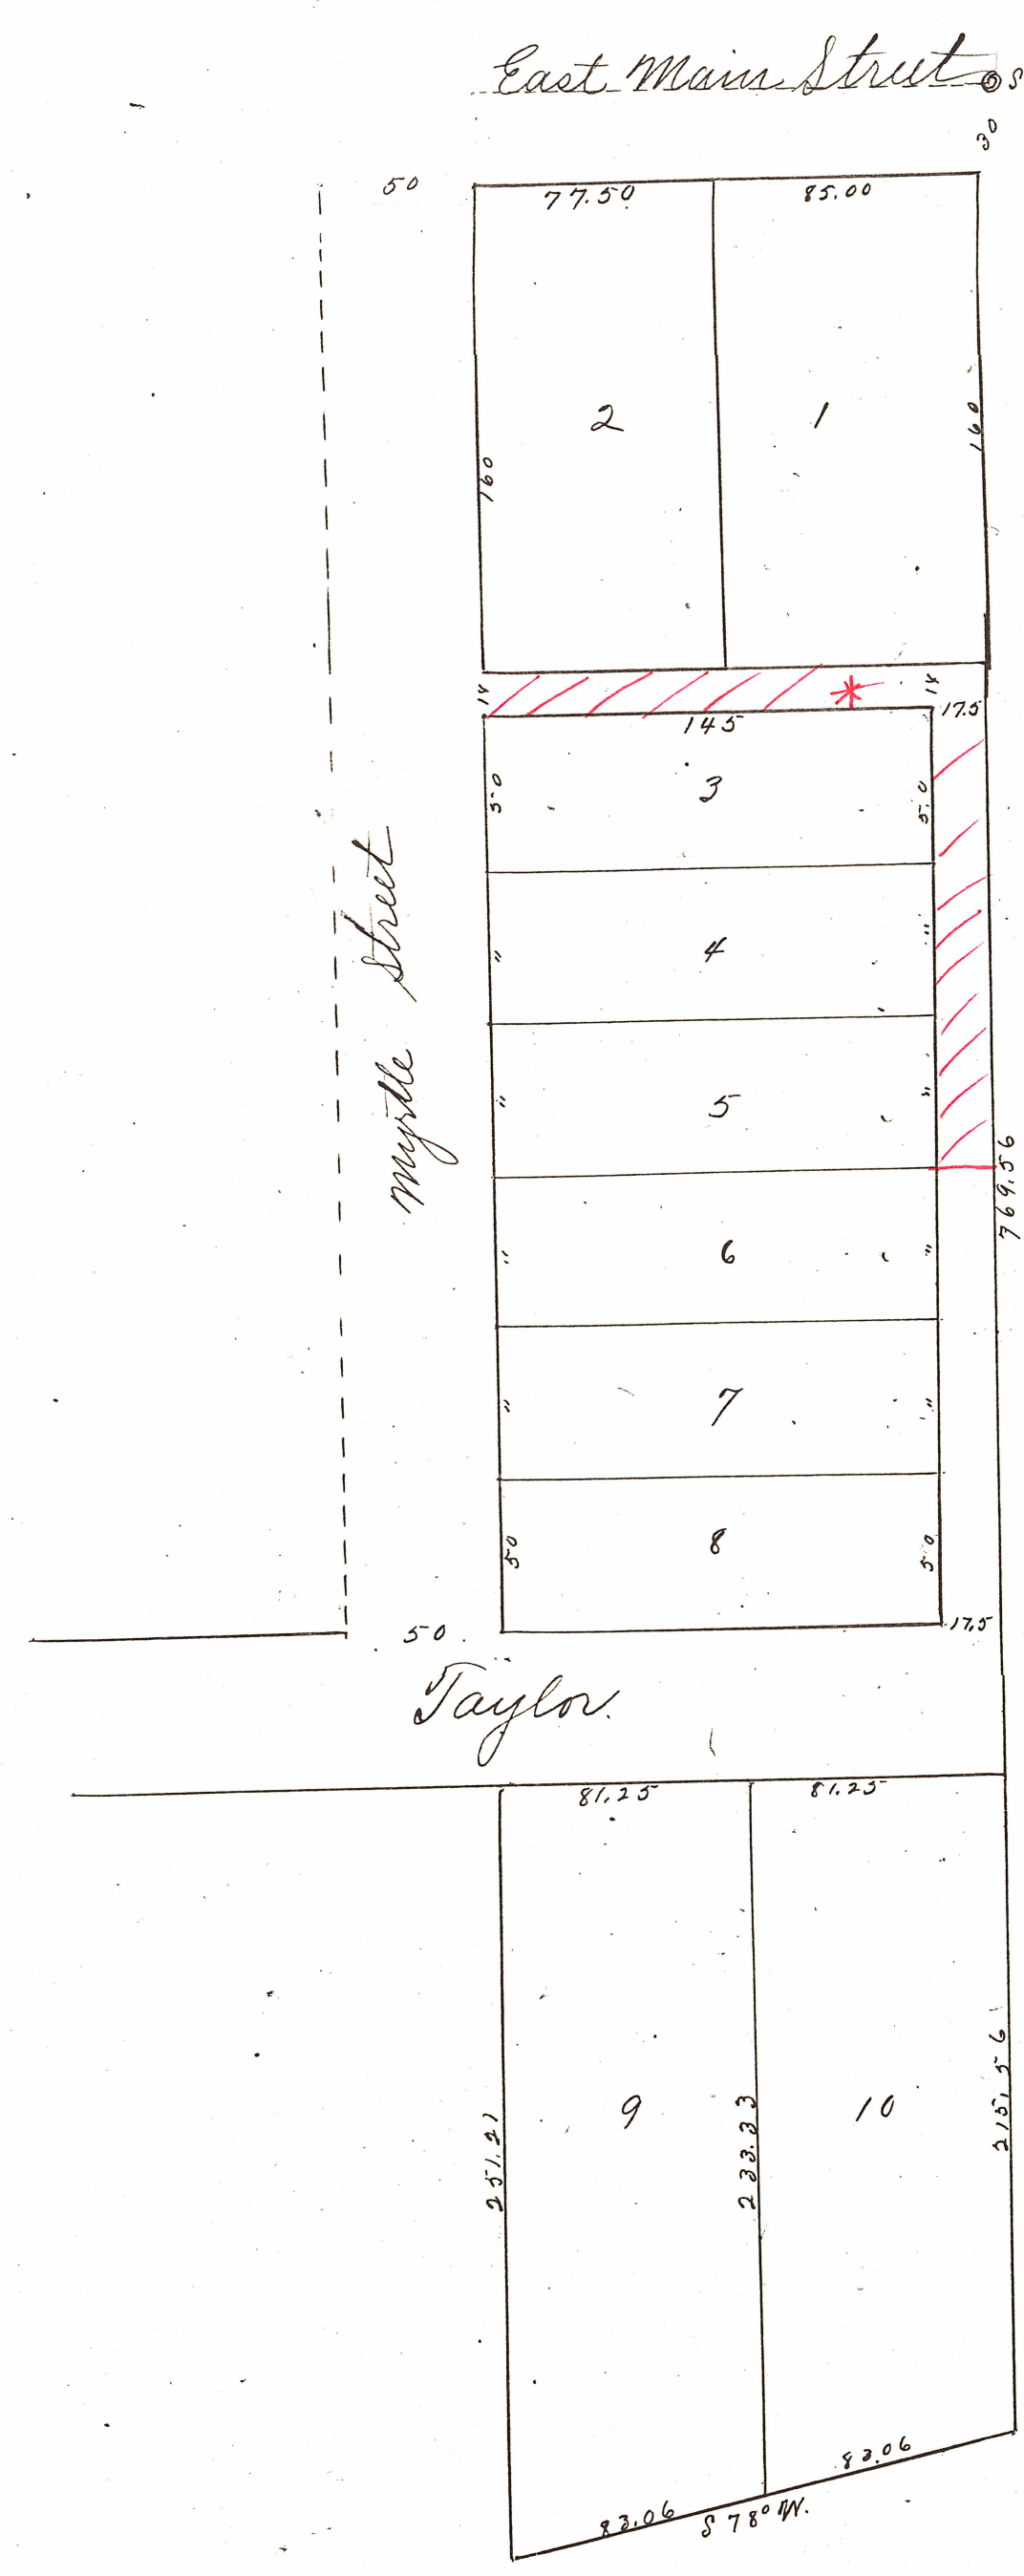

\* Alley way  
Vacated 10/20/2023  
Per Doc. # 2023-022160