


M A P
OF
THE LEWIS ADDITION
TO THE CITY OF MEDFORD OREGON
Scale 50 feet 1 inch.

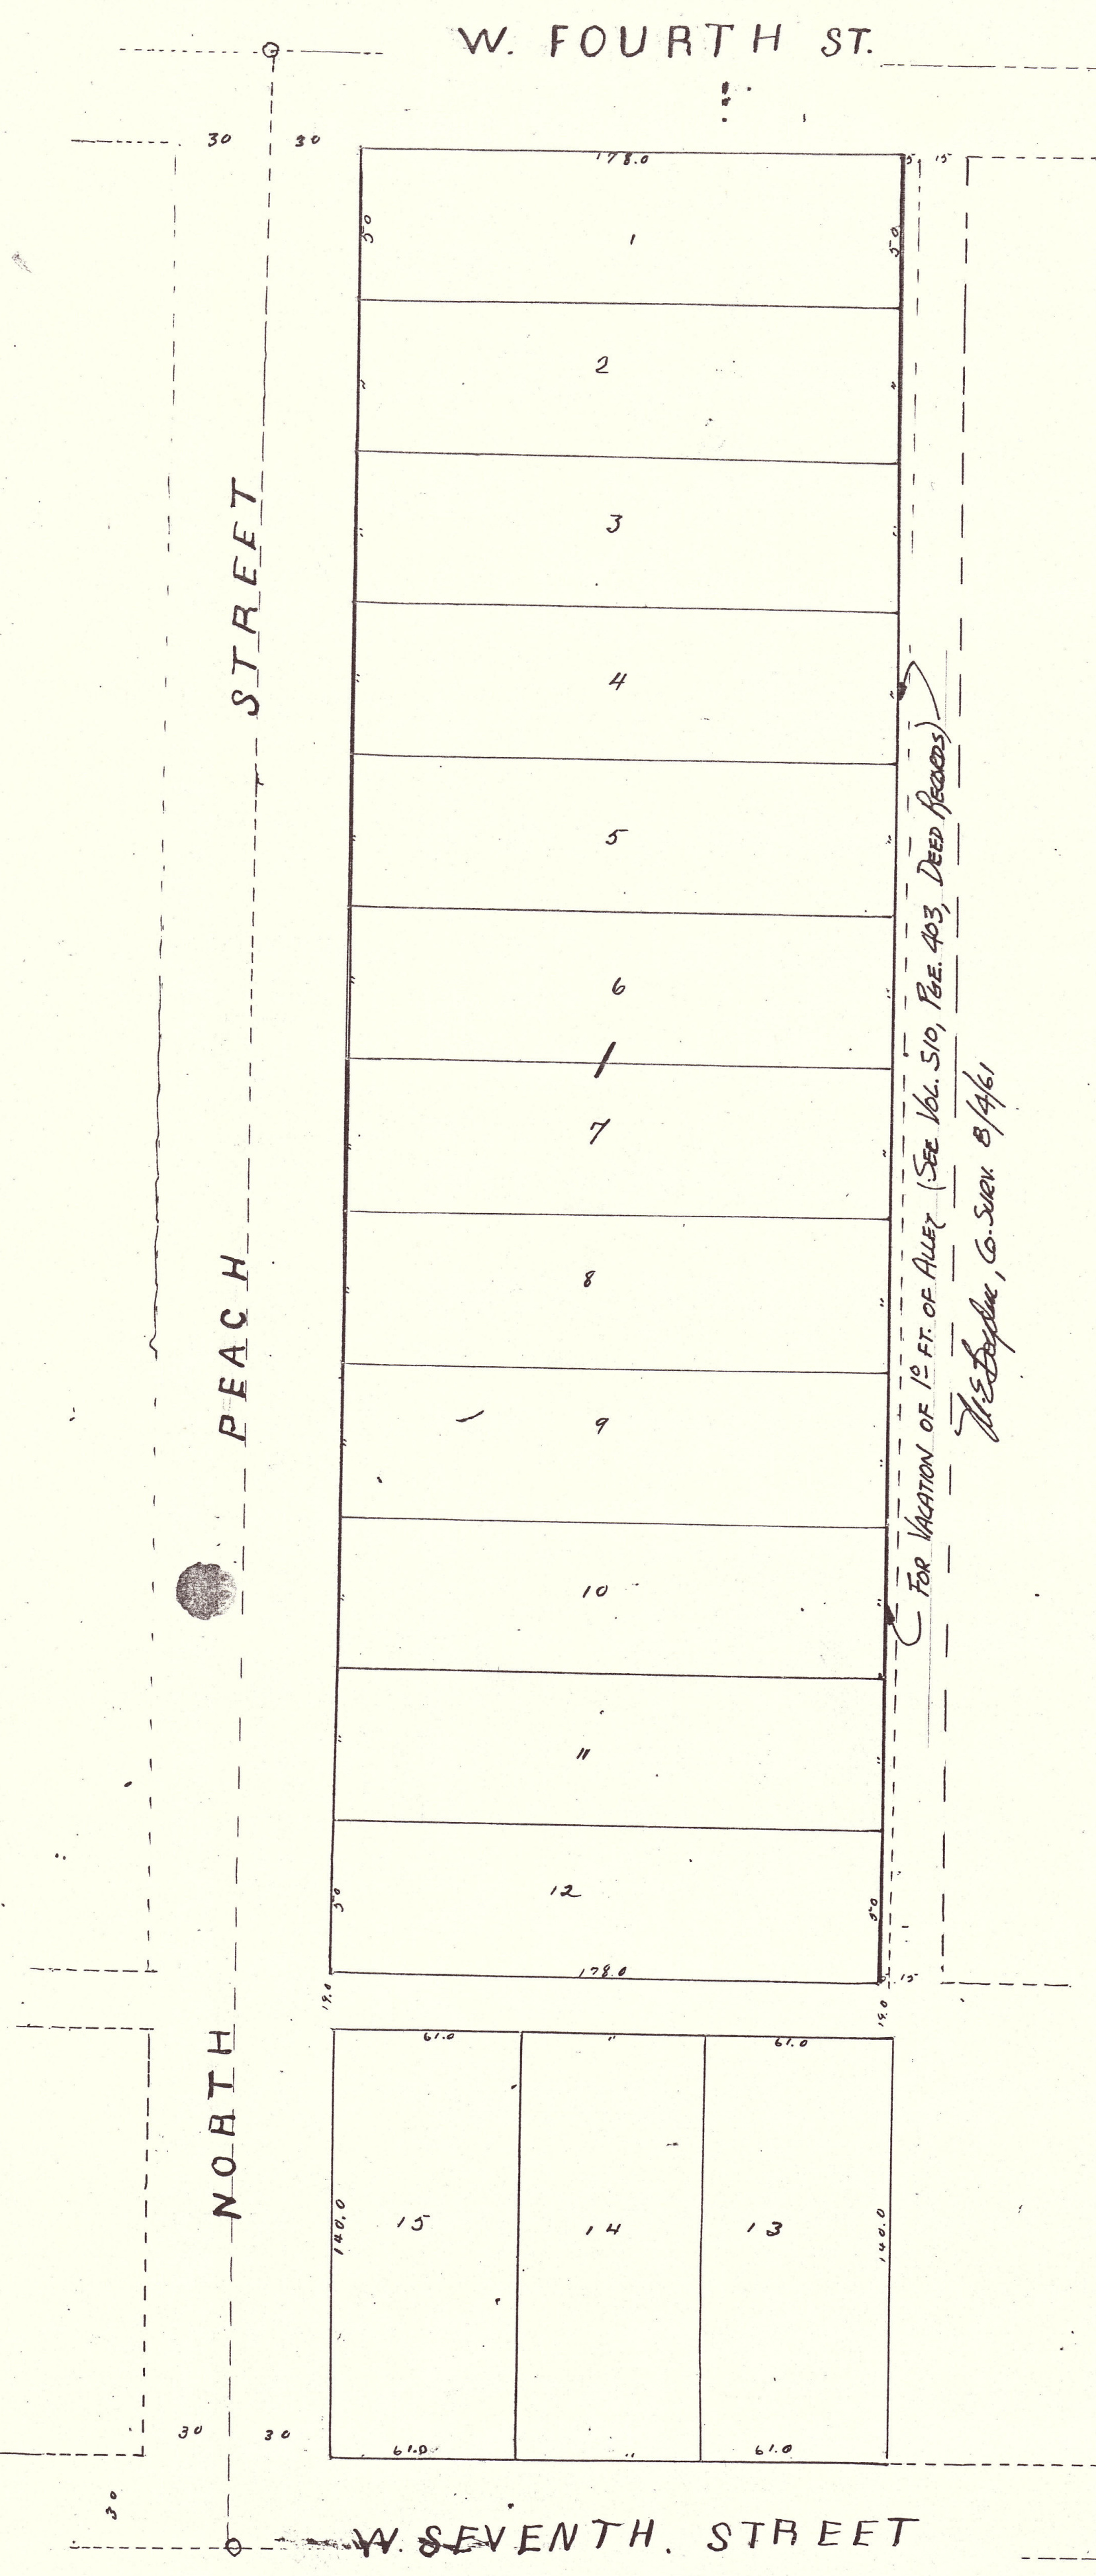

Description:-
Commencing at a point on the center line of North Peach Street 30 feet from the monument at the intersection of North Peach and West Seventh Streets; thence North 759 feet on the center line of Peach Street thence east 213 feet thence South 759 feet thence West 213 feet to place of beginning.

DEDICATION:- Know all men by these presents, That we, William Lewis and Eliza J. Lewis (his wife) are the owners in fee simple of the above described land; that we have laid out the same into Lots, Blocks, Streets and Alleys as shown by the Map hereon, and that said Map is a correct representation of said Survey and Subdivision and we do hereby dedicate to the Public for Public Highways all the Streets and Alleys shown on said tract and do hereby designate and name said tract as shown hereon as the Lewis Addition to the City of Medford, State of Oregon.

In witness Whereof, we have hereunto set our hands and seals this 10th day of August, 1908.
In the presence of
John S. Orth
W. B. Jackson
William Lewis
Eliza J. Lewis ...

State of Oregon
County of Jackson SS:-
Personally appeared before me a Notary Public in and for said County and State, the within named William Lewis and Eliza J. Lewis, His wife, of Jackson County, State of Oregon, to me personally known to be the above named, and who executed the above instrument, and severally acknowledged to me that they executed the same freely and voluntarily for the purposes therein mentioned.
Done this 10 day of Aug, 1908.
Notarial Seal
J.E. Eryart
J.E. Eryart
Notary Public.

I hereby certify to having examined and approved this plat.
T.W. Osgood, City Engineer
For order of County Commissioner' approving this plat See Vol 13 Page 210 of Commissioner's Journal of Proceedings.
W. R. Coleman
Clerk, Jackson County, Oregon.
Examined and approved this 2nd day of September, A.D. 1908.
Peter Applegate, Assessor.
Examined and approved by City Council of Medford, Oregon, and recorded in Vol. Page by
Benj.M. Collins, City Recorder
Filed for record this 3rd day of September 1908, at 3 o'clock P.M. and recorded in Vol. 1 of Plats page 132 Records of Jackson Co. Oregon.
R. J. Burnett
County Recorder
Filed Aug 17, 1908
W.R. Coleman, Clerk
By M.B. Towne, Deputy