


MAP

of

L. N. SUBDIVISION No 1

Scale 500 ft = 1 inch

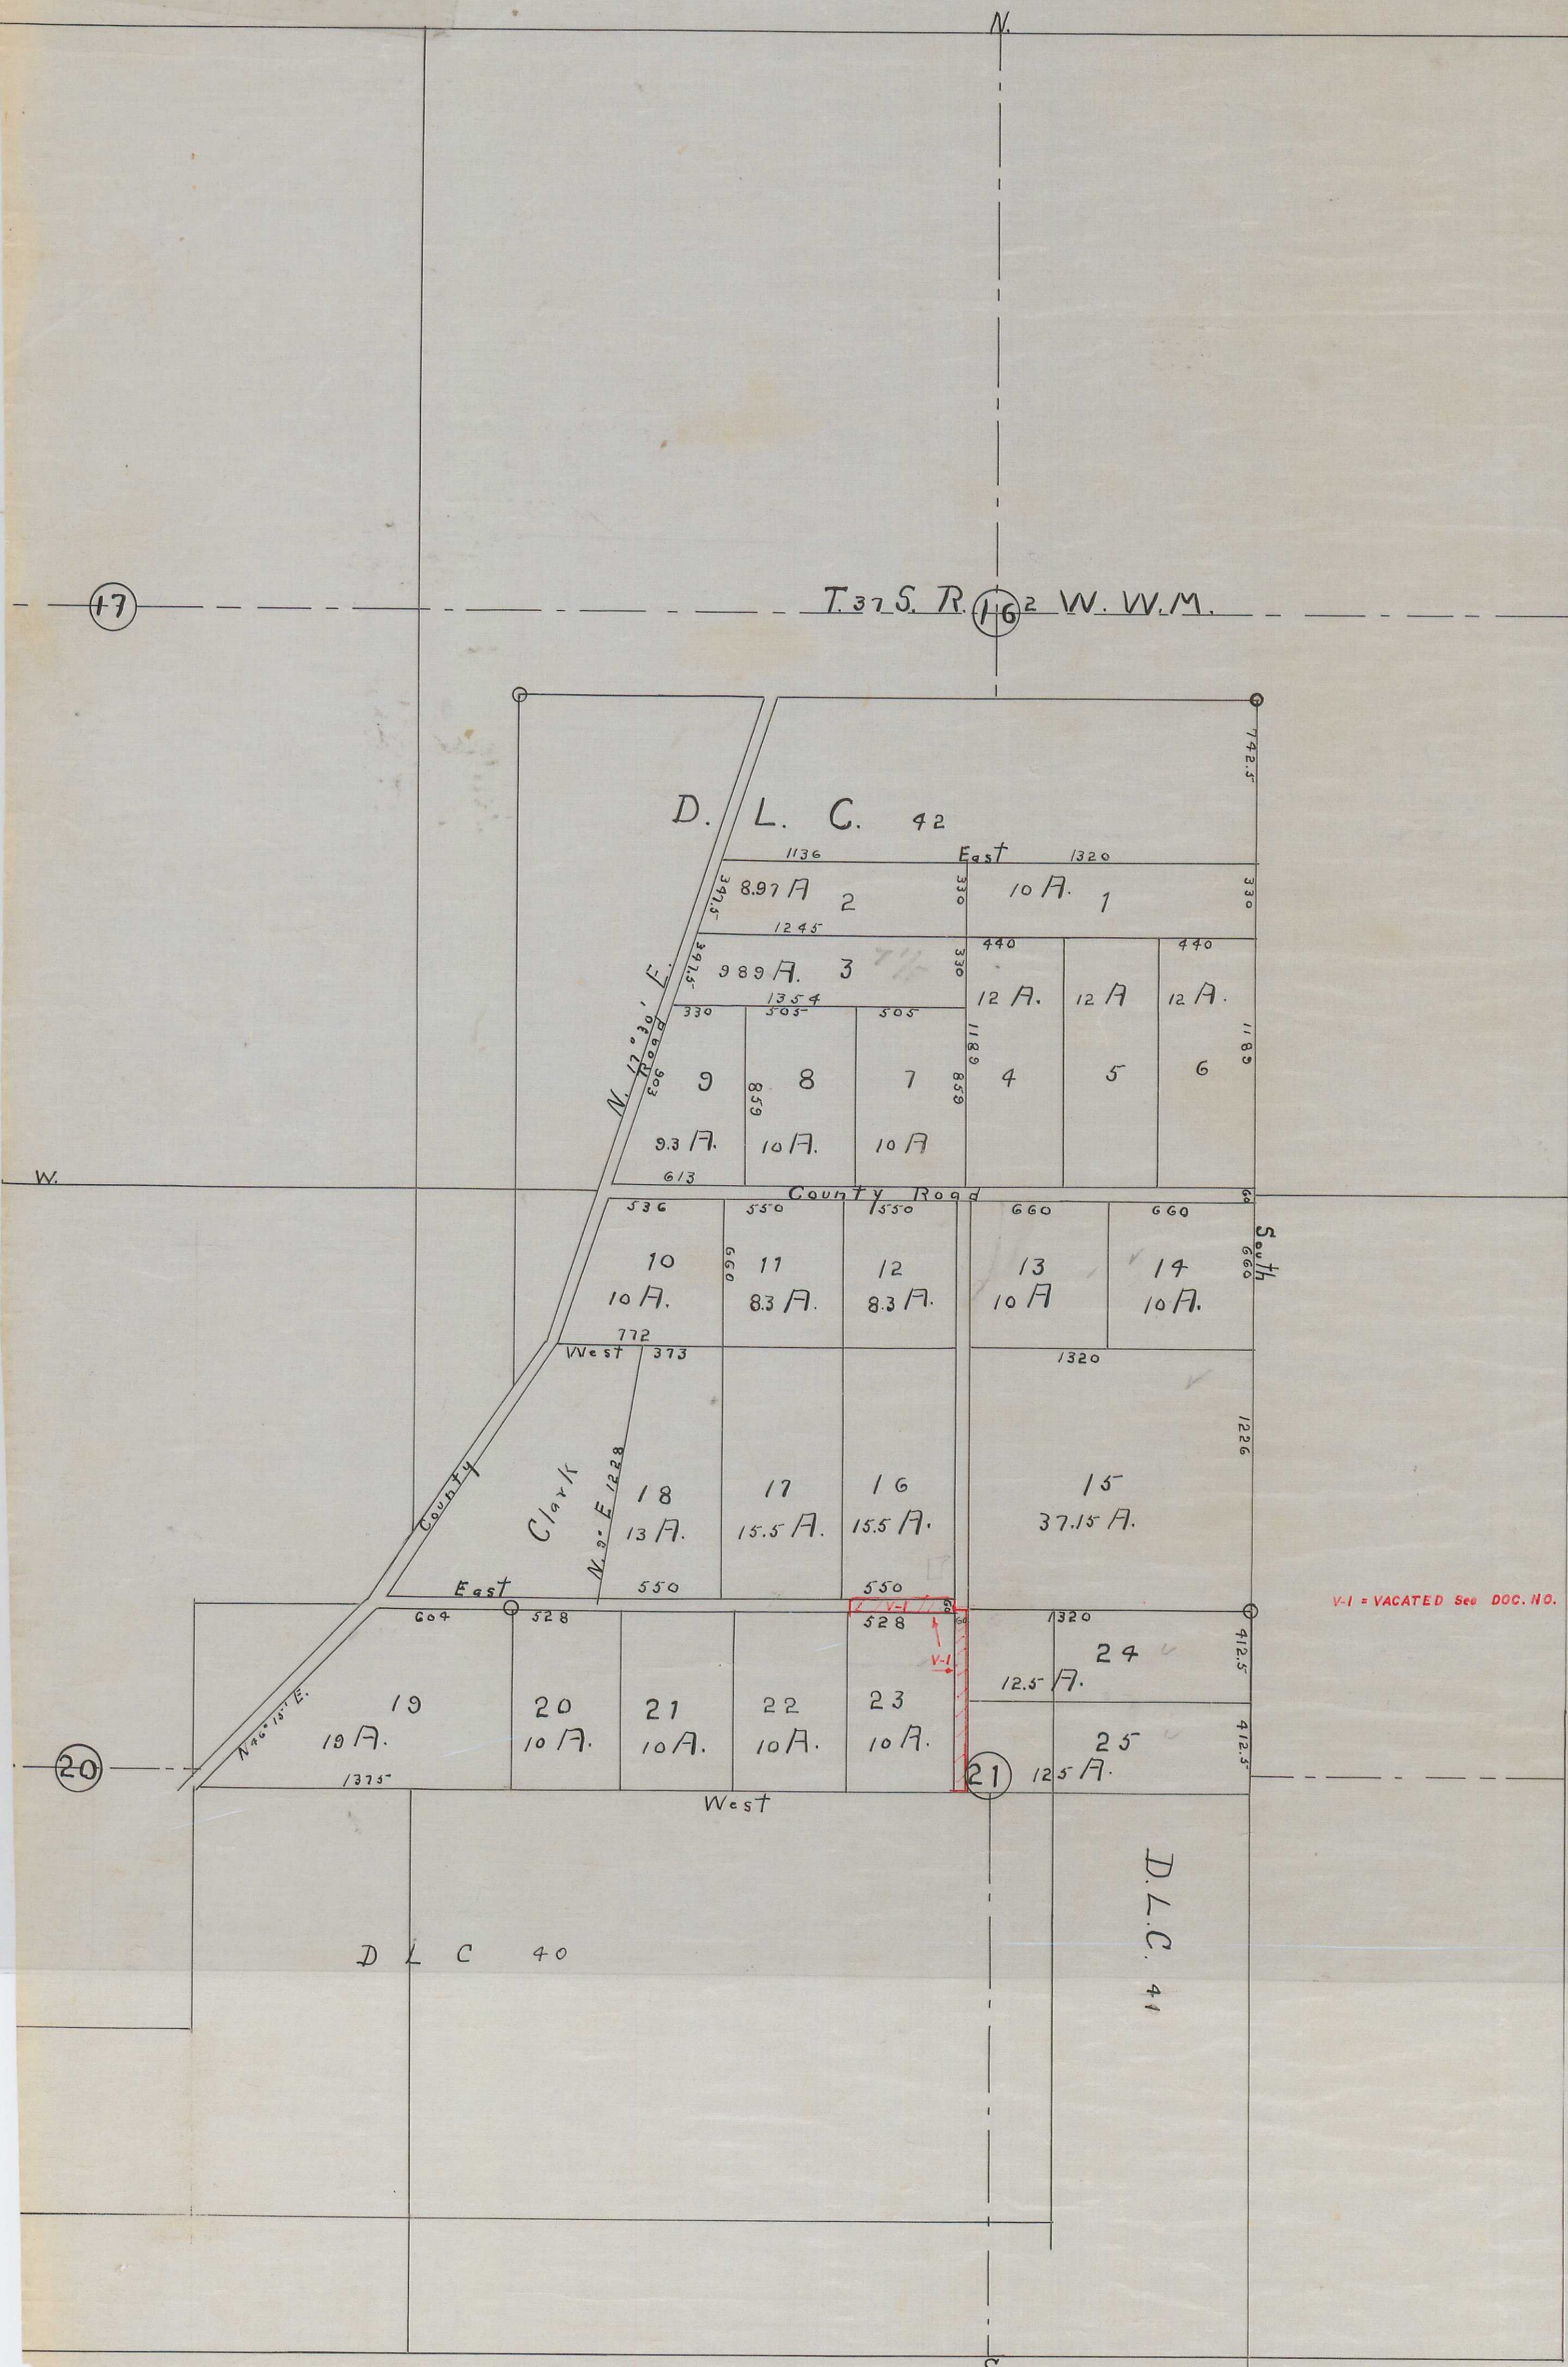

Description of Land N. Subdivision No 1:-
Commencing at a point 122.5 ft S. of N.E. cor. of D.L.C. No 42
Thence S 37.65 ft. to S.E. cor. thence S 82.5 ft. Thence W.
48.37 ft. Thence N 46' 15" E. 1135 ft. Thence E. 1031 ft. Thence
N. 5' E. 1228 ft. Thence W. 729 ft. Thence N 17' 30" E. 2310 ft. Thence
E. 2788 ft. to place of beginning, containing 3055 1/2 A. more or less
and being a part of Donation Land Claim 42 and 41 and 40 T. 37 S.
R. 2 W. W.M.

Dedication:- Know all men by these presents that I, K. Neidermyer,
on the owner of the above described tract of land, that I have laid out
the same into lots and roads as shown by the map hereon and that
said map is a correct representation of said survey and subdivision
and that I do hereby Dedicate to the Public for Public Highways all the roads
as shown on the map of said tract and do hereby designate and name
said tract as shown here on the L. and N. Subdivision No 1.
In Witness Whereof I have here unto set my hand and seal this 27th day
of March A.D. 1908.

Done in the presence of
J. L. Dutton
Examined and recommended for approval this 27th day of March A.D. 1908

L. Neidermyer
K. Neidermyer
County Surveyor

Examined this 27th day of March A.D. 1908 and recommended for
approval of County Commissioners Court
Geo. Applegate
Assessor *Geo. Applegate*

For order of County Commissioners Court approving this plat see
Vol. 14 Page 187 of Commissioners Journal of proceedings
State of Oregon } S.S.
County of Jackson }
W. R. Coleman
Clerk of Jackson County

Personally came before me a Notary Public in and for said County and State the within named K. Neidermyer and for said County State of Oregon to me personally to be the above named, and who executed the above instrument and acknowledged to me that he executed the same freely and voluntarily for the purposes there in mentioned
Done this 27th day of March A.D. 1908
Jay L. Dutton
Notary Public for State of Oregon

Mrs. Ed. Neidermyer acknowledged same March 30 1908
Jay L. Dutton
Notary Public

Filed April 1 - 1908
W. R. Coleman
Clerk
By *M. B. Brown*
Deputy

I certify that the within instrument of writing was received and read the County of Jackson Oregon on the 3rd day of April 1908 and is recorded in volume 1 of the County Records at *116* pages
R. V. Burnett
County Recorder

116-A

3

116