


ENTIRE PLAT VACATED, EXCEPT LOT No. 33  
(SEE C.C.J. Vol. 13, Page 24) 1/13/21  
M.E. Boyden Co. Surv. 1/26/61

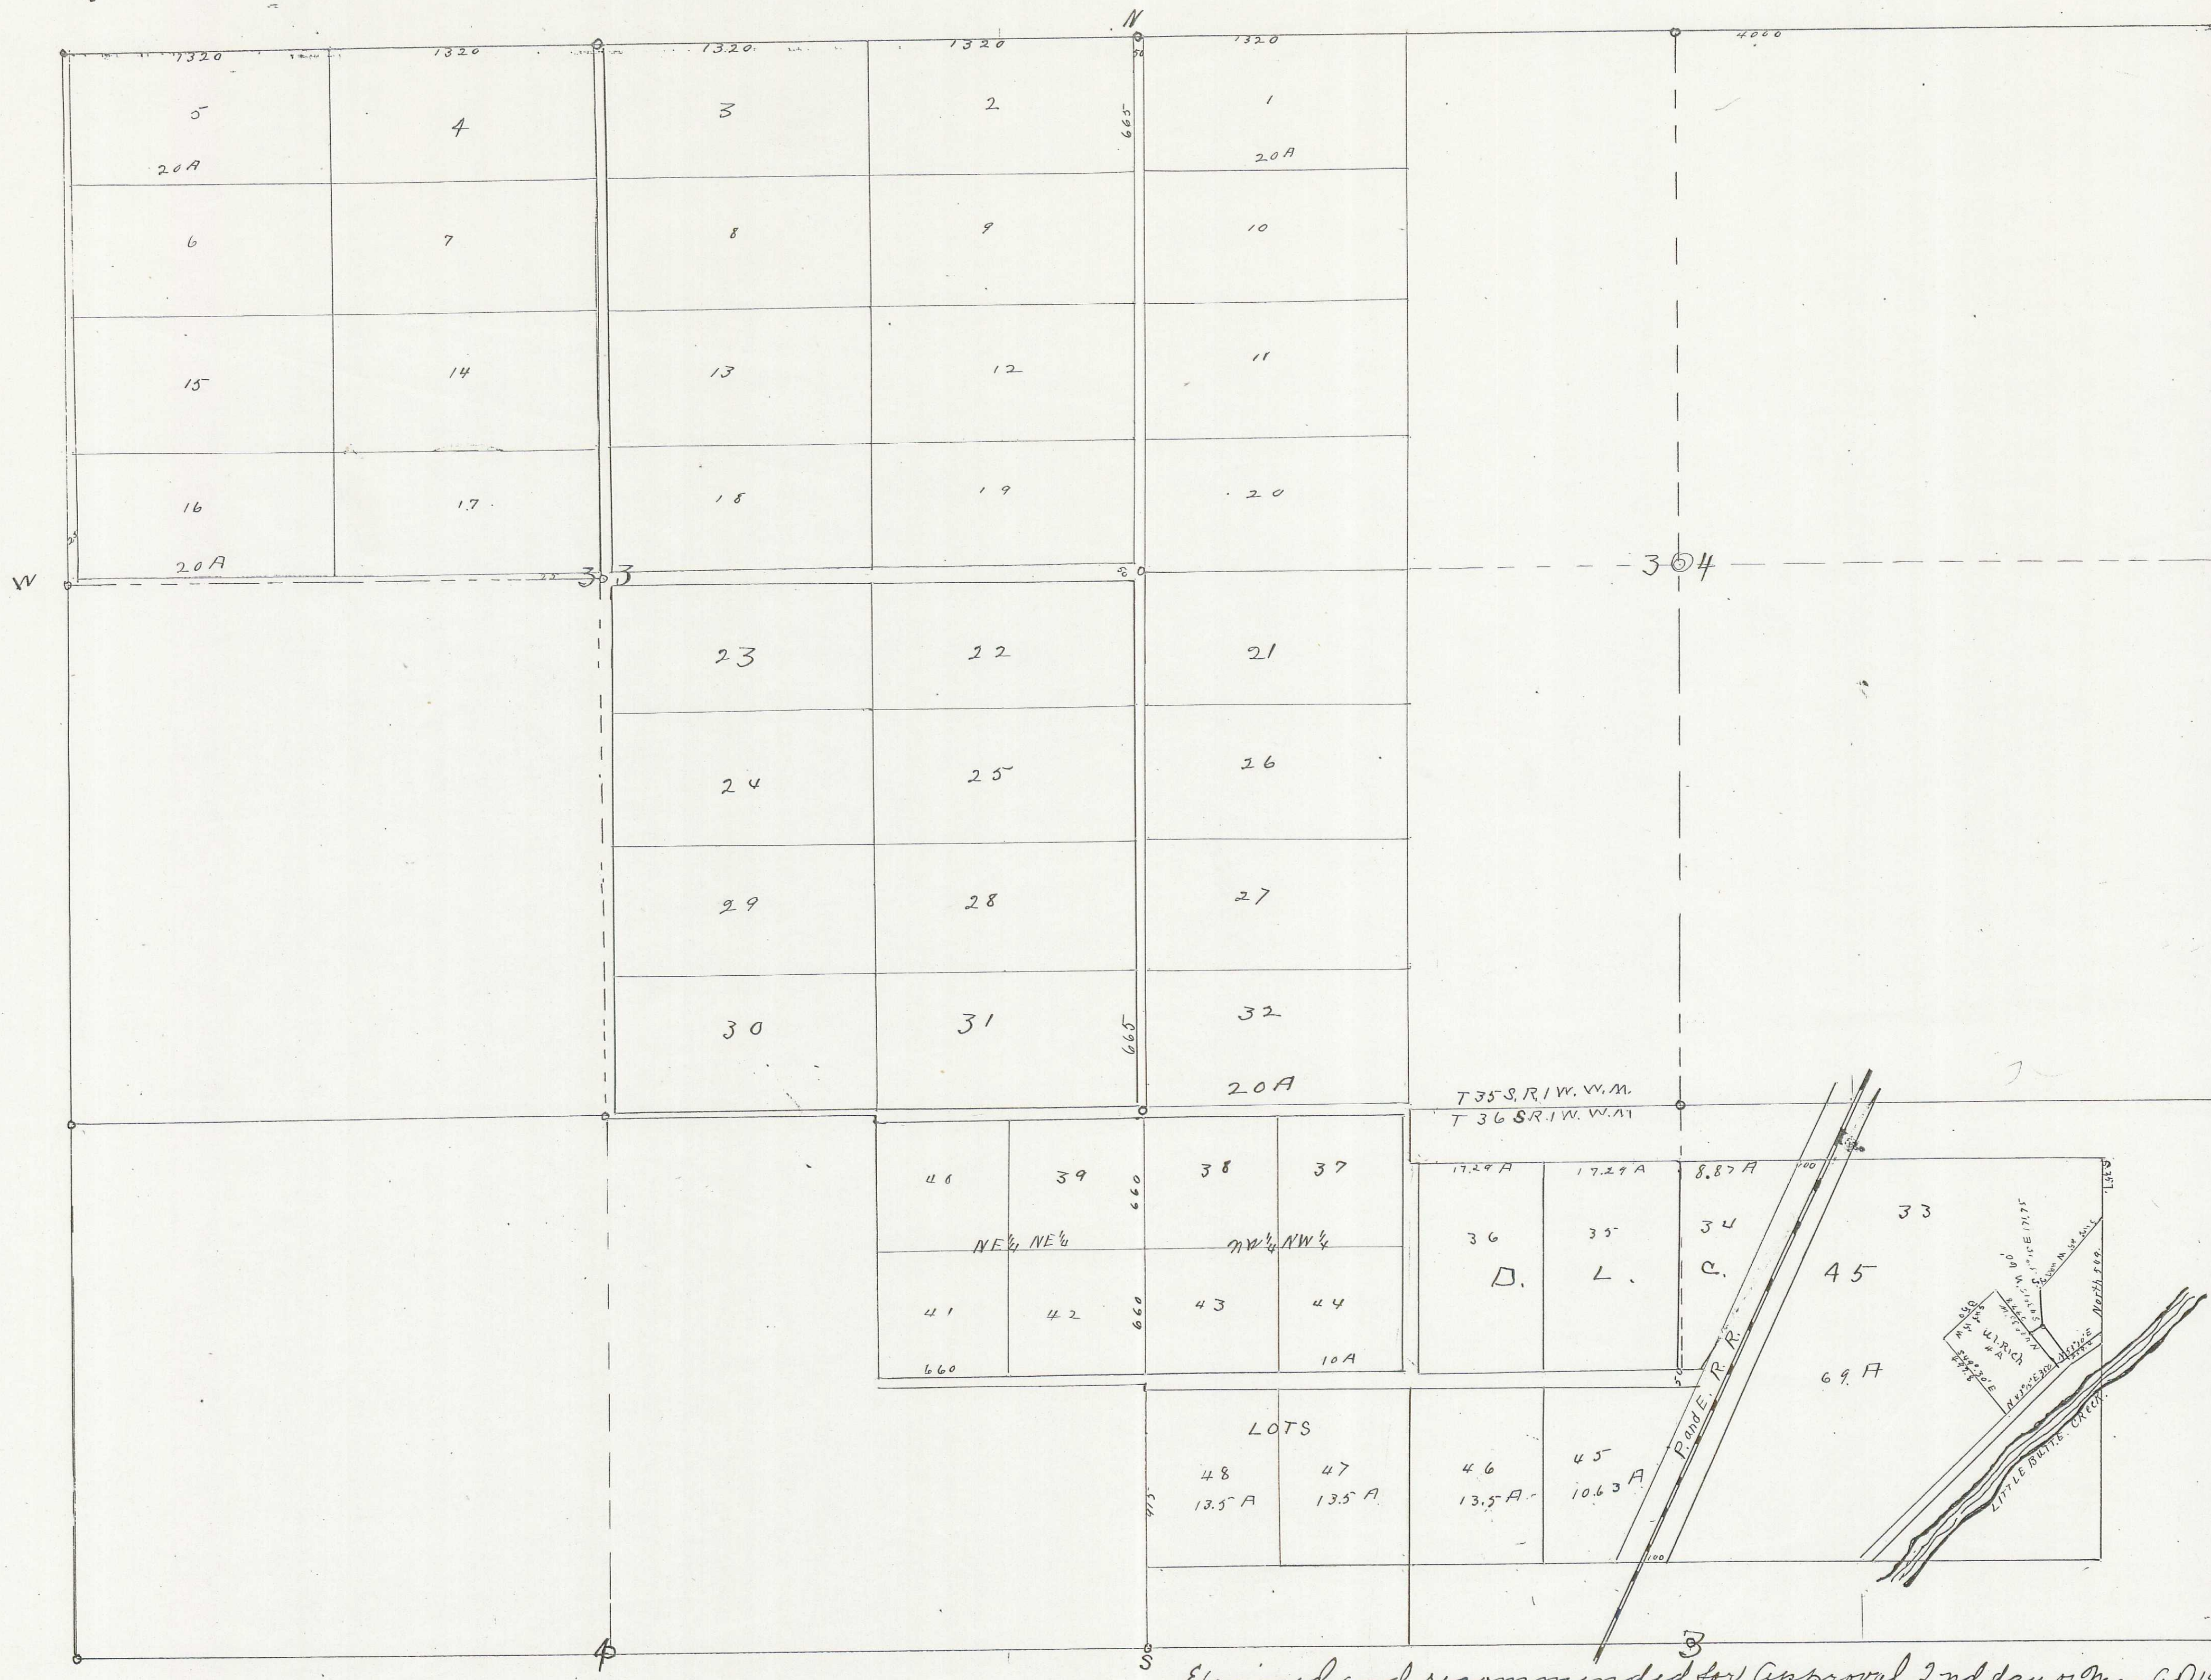

Description of Rogue River Irrigated Orchard Lands:- The N W  $\frac{1}{4}$  and the E  $\frac{1}{2}$  Sec. 33 the N  $\frac{1}{2}$  W  $\frac{1}{2}$  Sec 34  $\frac{1}{2}$  S R 1 W W M. The N. E  $\frac{1}{4}$  NE  $\frac{1}{4}$  Sec 4 the N W  $\frac{1}{4}$  and N W  $\frac{1}{4}$  and D. L. C. 45 and Lot 5 Sec 3 T 36 S. R 1 W W. M containing 563.6 Acres.

Dedication:- Know all men by these Presents that, we N Hart Hamilton and M. O. Hamilton, his wife are the owners of the above described tract of land that we have laid out the same in to lots and roads as shown by the map hereon and that said map is a correct representation of said survey and subdivision and that we do hereby dedicate to the Public for Public Highways all the roads as shown on the maps of said tract, and do hereby designate and name said tract as shown hereon the Rogue River Irrigated Orchards. In Witness Whereof, we have hereunto set our hands and seals this eighteenth day of March, A. D. 1908.

done in presence of N. Hart Hamilton  
John P. Halse M. O. Hamilton  
State of California } S. S.  
County of Santa Barbara

Personally came before me, a Notary Public in and for said County and State the within named N. Hart Hamilton and M. O. Hamilton, his wife, of Jackson County, State of Oregon, to me personally known to be the above named and who executed the above instrument and acknowledged to me that they executed the same freely and voluntarily for the purposes therein mentioned Done this 16th day of March A. D. 1908. John P. Halse

Examined and recommended for approval 2nd day of May A. D. 1908. Notary Public in and for the County of Santa Barbara State of California.  
Frank A. Grinn  
County Surveyor.

Examined this 6th day of May A. D. 1908 and recommended for approval of County Commissioners Court Approved May 6, 1908 Peter Applegate  
Assessor.

For Order of County Commissioners Court approving this Plat see Vol. 13 Page 168 of Commissioners Journal of Proceedings W. R. Coleman  
Clerk of Jackson County, Oregon  
By M. B. Towne, Spy

I certify that the within instrument of writing was received and filed for record at 8 o'clock A. M. the 14 day of May 08 and is recorded in Volume of Plat Records of Jackson County Oregon.  
R. K. Burnitt  
COUNTY RECORDER.

Filed May 6th, 1908  
W. R. Coleman  
Co. Clerk