


MAP OF THE CHITWOOD TRACT AT ASHLAND OREGON.

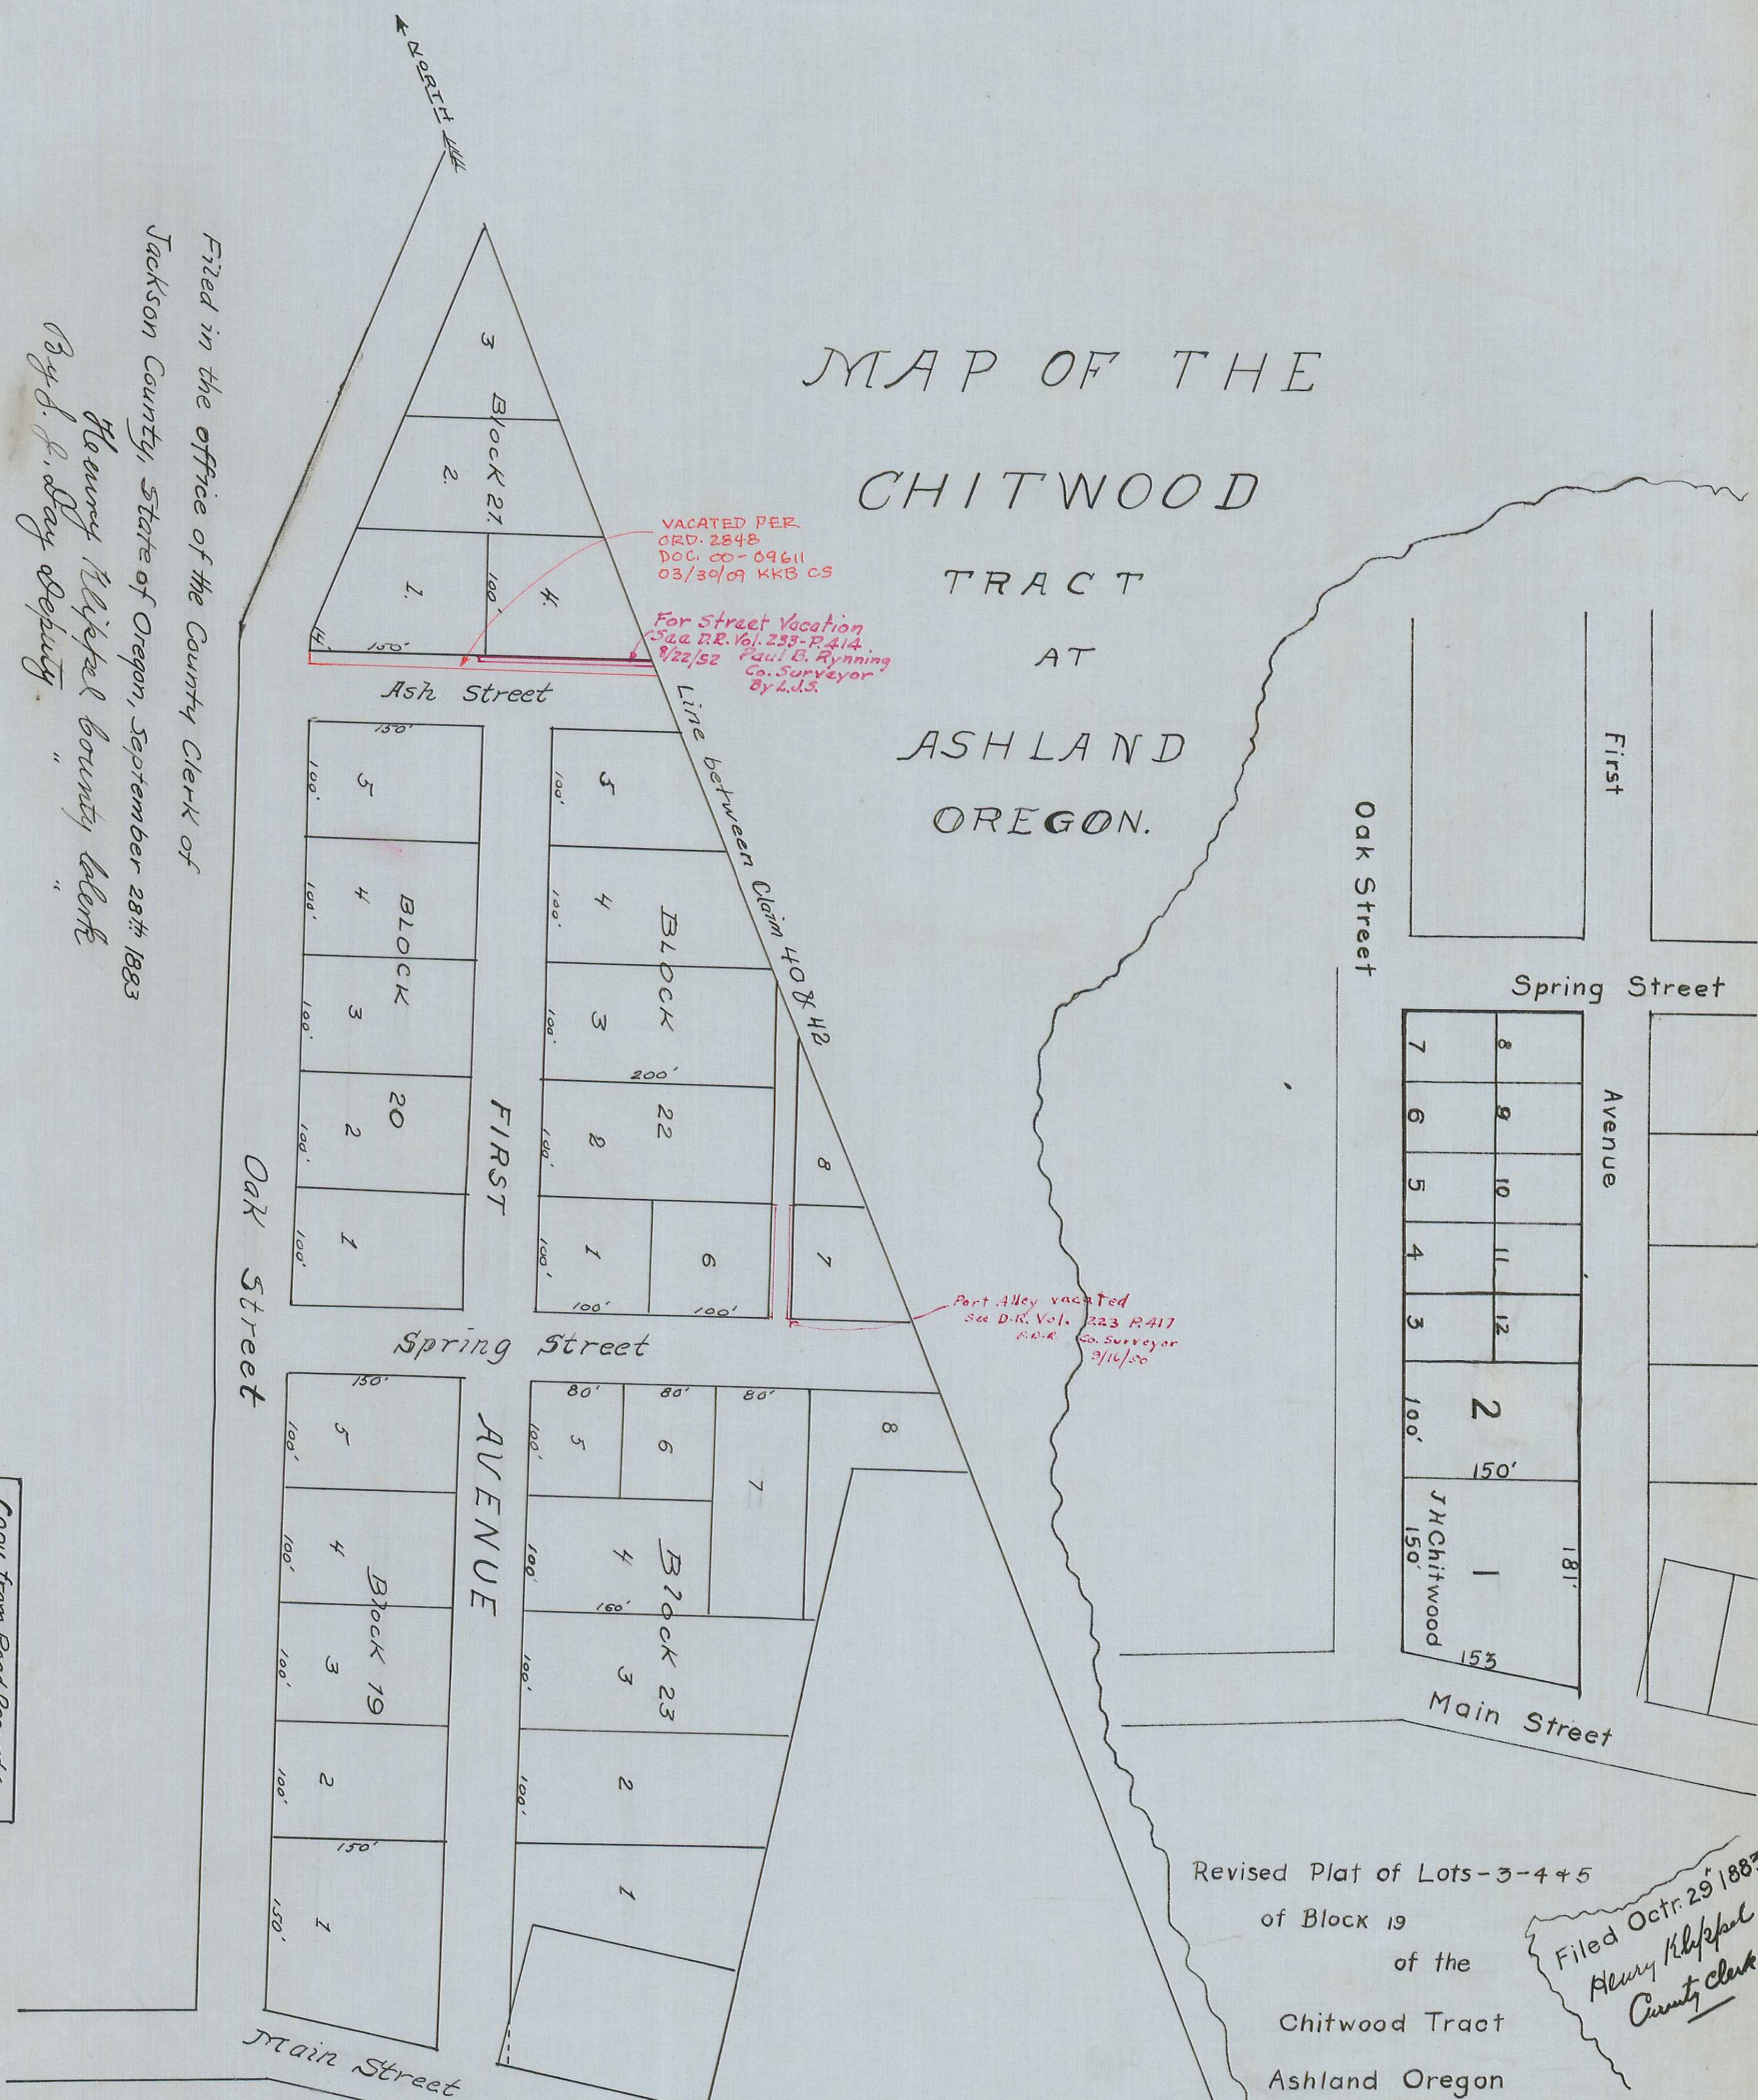

Filed in the office of the County Clerk of
Jackson County, State of Oregon, September 28th 1883
By S. J. Day Deputy

Copy from Road Records
Vol. 2 page 29
Dec. 3, 1936 by F.M.R.
Checked by C.I.B.

Copy from Road Records
Vol. 2 Page 31
March 28, 1941 by R.H.
Checked by O.B.

Filed Oct. 29 1883
County Clerk

Revised Plat of Lots-3-4+5
of Block 19
of the
Chitwood Tract
Ashland Oregon