


The town of Gold Hill is situated in sections 15 and 22 T. 36 S. R. 3 W. of the Willamette Meridian and is part of the South 1/2 of the South West 1/4 of sec. 15. and part of the N.W. 1/4 of sec. 22. T. 36 S. R. 3 W. The S.E. corner of block 18 is 76.2 feet South and 37.3 feet East of the section corner to the above named sections. The lettered streets run S. 77° 20' E. and the numbered streets run at right angles with the same. All streets are 60 feet wide except 4th street which is 80 feet wide and except D, E, & F streets which are 50 feet wide. The alleys are 20 feet wide. The full blocks are 300x220 feet and have lots 50x100 feet excepting blocks 12, 13, 14, 15, 16, 17, 23, 24, 25, 26, 27 & 28 in which blocks the lots facing railroad are 25x100 feet the others 50x100 feet. The ground marked Oregon & California Railroad Depot Grounds is set apart as Depot Grounds for said Oregon & California Railroad. Boundary lines of town are shaded green. Boundary lines of O & C. R. R. Depot Grounds are shaded brown.

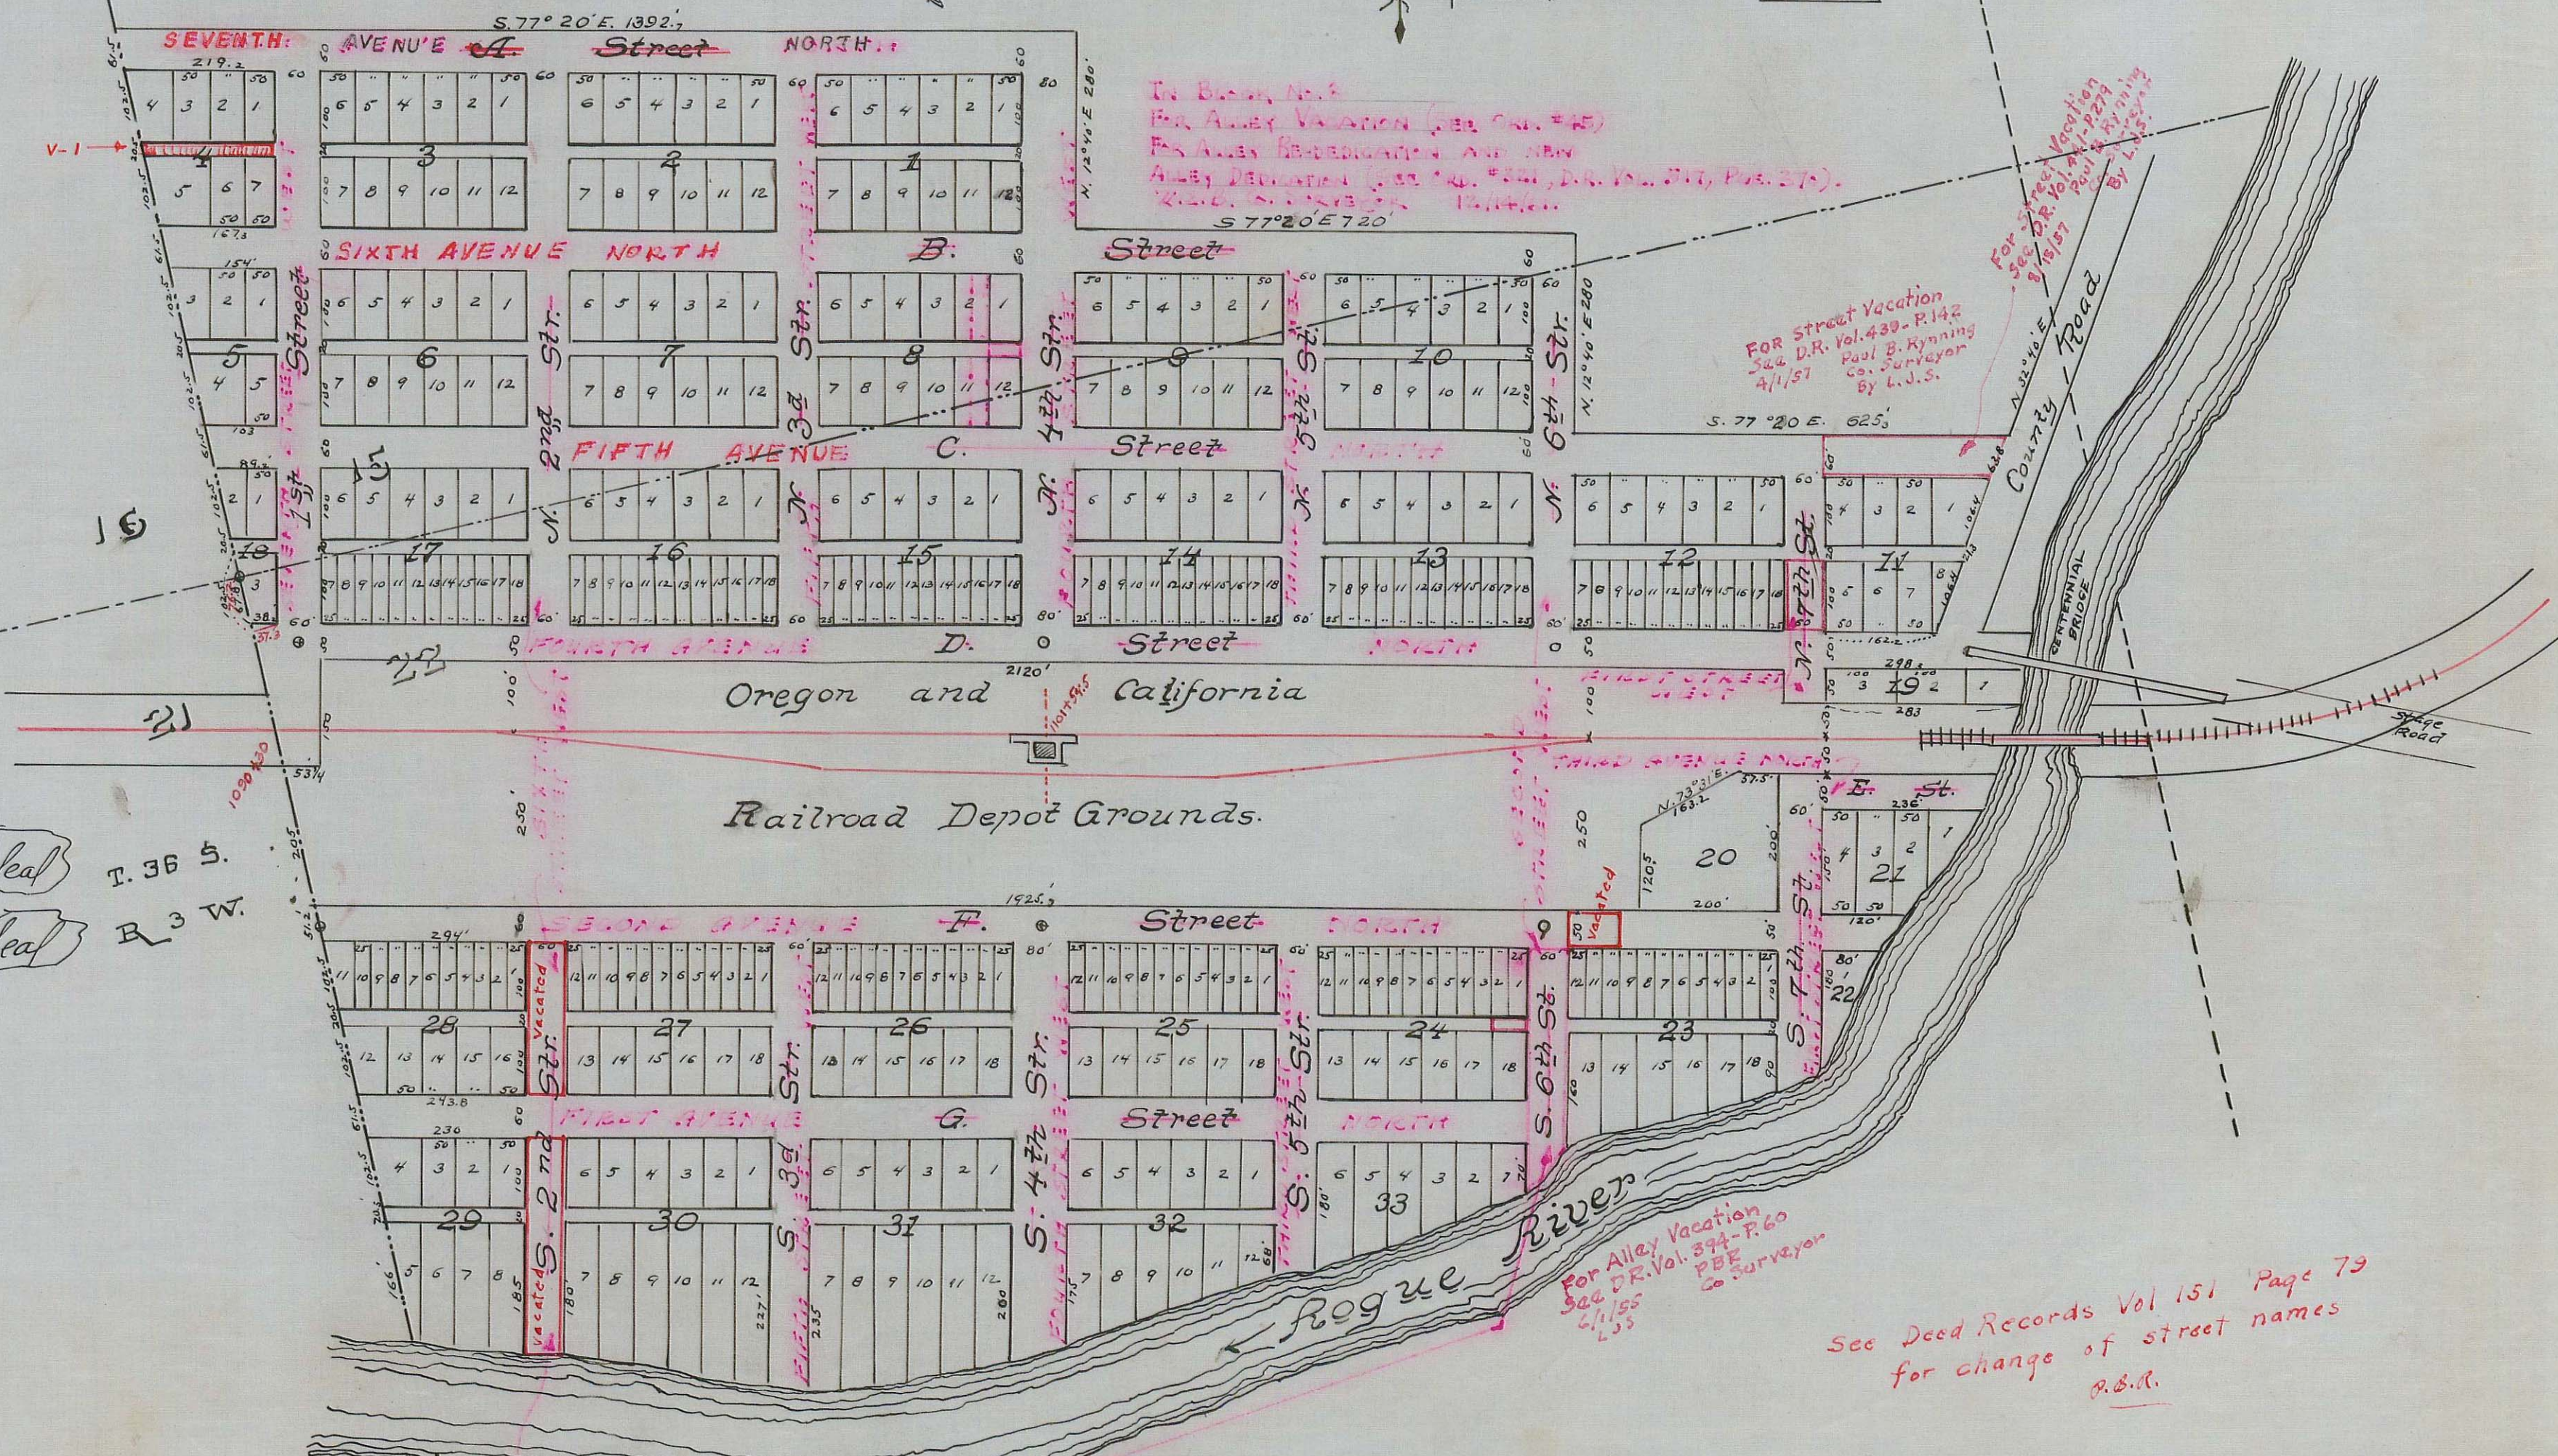

In Block No. 1  
For Alley Vacation (See Ord. #45)  
For Alley Dedication and New  
Alley Dedication (See Ord. #44, DR. Vol. 117, Pgs. 27).  
K. G. R. Co. Surveyor  
1/24/85

For street Vacation  
See D.R. Vol. 151, Pgs. 79  
Paul B. Kynning  
Co. Surveyor  
4/1/57

For Alley Vacation  
See D.R. Vol. 874-P. 60  
P.B.E.  
Co. Surveyor  
4/1/55

State of Oregon } S.S.  
County of Jackson }

We Thomas Chauner and Rosa Chauner his wife of the County of Jackson and State of Oregon do hereby acknowledge and declare the foregoing map or plat to be the map or plat of the Town of Gold Hill in Jackson County in the State of Oregon, as surveyed and laid out by us, and we do hereby dedicate to the use of the public all the above described streets and alleys as shown and designated on said map.

In witness whereof we have hereunto set our hands and seals this 7th day of January 1884 at 10 A.M.  
In presence of *Thomas Chauner* Seal T. 36 S.  
*Rosa Chauner* Seal R. 3 W.


State of Oregon } S.S.  
County of Jackson }

This certifies that on this 7th day of January 1884, 10 A.M. before me the undersigned, personally appeared the within named Thomas Chauner and Rosa Chauner his wife personally known to me to be the persons described in and who executed the foregoing dedication of plat and acknowledged to me that they executed the same and Rosa Chauner wife of said Thomas Chauner on a private examination made by me separately and apart from her said husband, acknowledged to me that she executed the same freely and voluntarily and without fear or compulsion from any one.

In testimony whereof I have hereunto set my hand and seal the day above written.  
*Charles Piim*  
Notary Public.

NOTE: This entry in street names changed prior to vacation.  
For vacation of streets  
See Deed Records  
Vol. 258 P. 269-270  
P.B.R.  
Co. Surveyor  
2/24/85

See Deed Records Vol 151 Page 79  
for change of street names  
P.B.R.

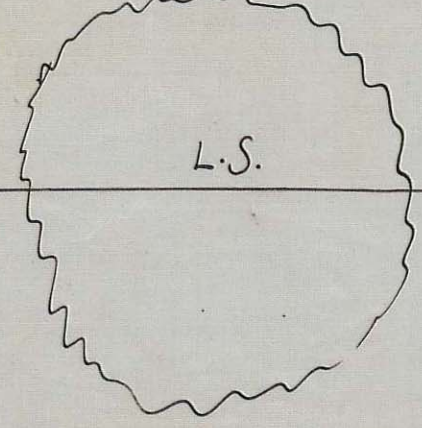

Filed and duly recorded in Vol. 2, page 37, Jackson County, Records of Roads. This 7th day of January 1884 at 10 o'clock A.M.  
Henry Klippel  
County Clerk.

Copy from Road Records  
Vol. 2, page 37.  
Dec. 8, 1936. By F.M.P.  
checked by. czb.

Gold Hill

4/57

57

R.R. 2-57