


MAP OF HUNSAKERS ADDITION TO ASHLAND OREGON

SCALE 100 feet = 1 inch.

For Ordinance vacating an alley see Misc. Records Vol. L Page 268

Copy from Dead Records
Vol. 16 - Page 25 + 26
Oct. 9, 1936 By F.M.P.
Checked By c.z.b.

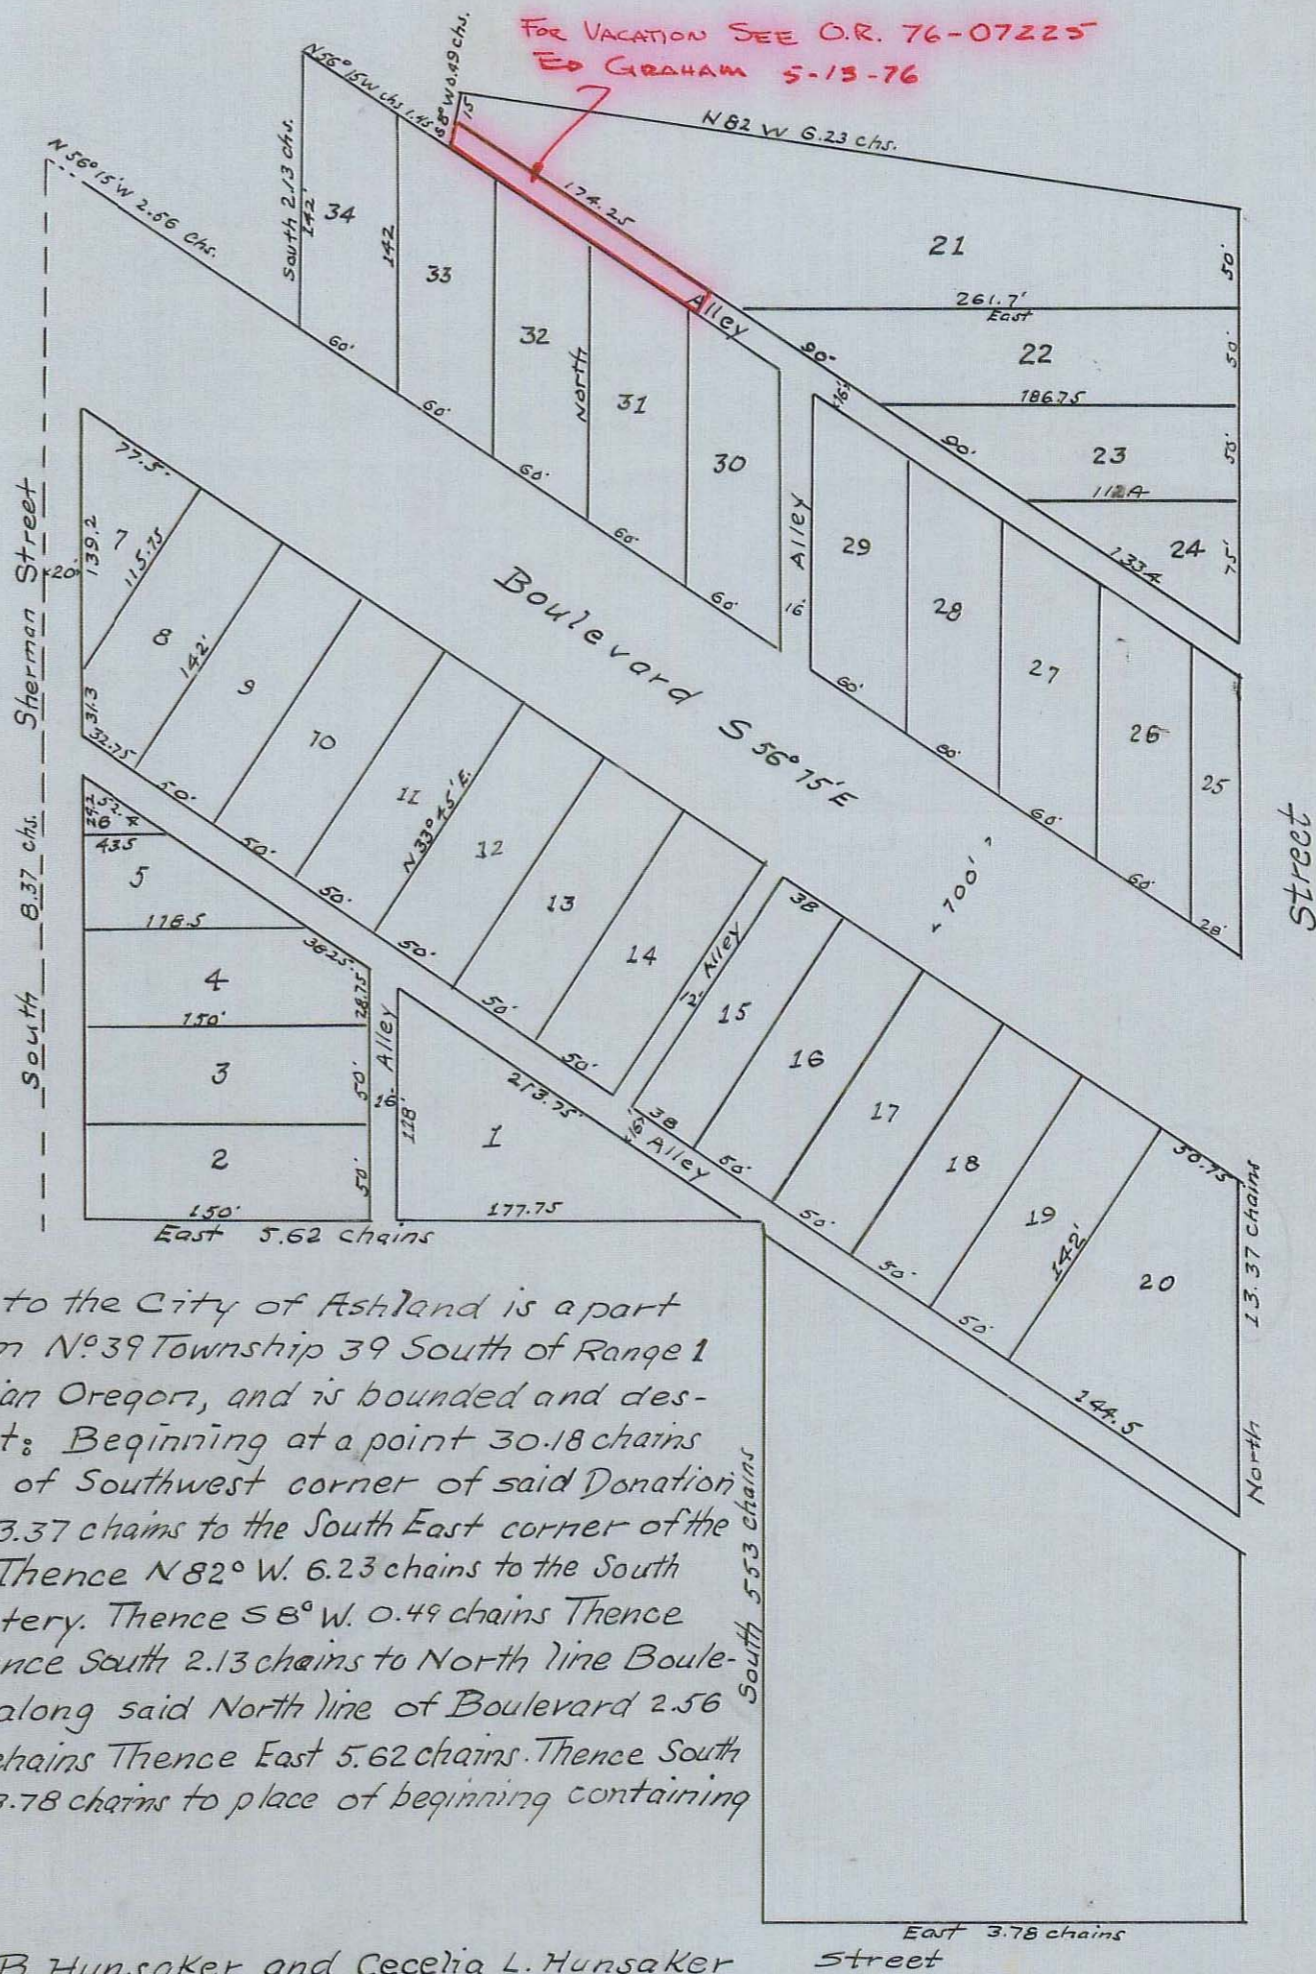

Hunsakers Addition to the City of Ashland is a part of Donation Land Claim N° 39 Township 39 South of Range 1 East Willamette Meridian Oregon, and is bounded and described as follows to wit: Beginning at a point 30.18 chains East and 0.45 chs. North of Southwest corner of said Donation Claim 39. Thence North 13.37 chains to the South East corner of the Ashland Cemetery lot. Thence N 82° W. 6.23 chains to the South west corner of said Cemetery. Thence S 6° W. 0.49 chains Thence N. 56° 15' W. 1.45 chains, Thence South 2.13 chains to North line Boulevard. Thence N. 56° 15' W. along said North line of Boulevard 2.56 chains. Thence South 8.37 chains Thence East 5.62 chains. Thence South 5.53 chains, Thence East 3.78 chains to place of beginning containing 10 acres.

State of Oregon } ss.
County of Jackson } We E.B. Hunsaker and Cecelia L. Hunsaker

his wife of the County of Jackson state of Oregon, do hereby acknowledge and declare that the piece or parcel of land designated on this Map or Plat as above described to be the map or plat of Hunsakers Addition to the City of Ashland Oregon as was by us who at the time were the owners thereof laid out and subdivided into 34 lots the length and courses of whose boundary lines are shown on this map or plat in characters and figures representing courses and distances. And we hereby dedicate to the use of the public all streets and alleys as shown on this Map.

In Witness Whereof we have hereunto set our hands and seals this 21st day of May A.D. 1888.
In Presence of { M. L. McCall
Peter Applegate

E.B. Hunsaker (Seal)
Cecelia L. Hunsaker (Seal)

state of Oregon } ss.
County of Jackson }

This certifies that on this 21st day of May 1888 before me a Notary Public in and for the State and County aforesaid personally appeared the above named E.B. Hunsaker and Cecelia L. his wife to me personally known to be the identical persons described in and who executed the foregoing dedication of plat and acknowledged to me that they executed the same freely and for the purposes therein mentioned. And the said Cecelia L. on examination separate and apart from her said husband E.B. Hunsaker acknowledged to me that she executed the same freely and without fear or compulsion from anyone.

In Witness Whereof I have hereunto set my hand and official seal the day and year last above written.

(L.S.) W.L. McCall
Notary Public

state of Oregon } ss. I certify that the annexed Instrument was received and filed for record the 23rd day
County of Jackson } of May 1888., at 8 o'clock A.M., and duly recorded the 25th day of May 1888.

W.H. Parker
County Clerk.