


Pool & Klippel's

Addition to The Town of

Jacksonville.

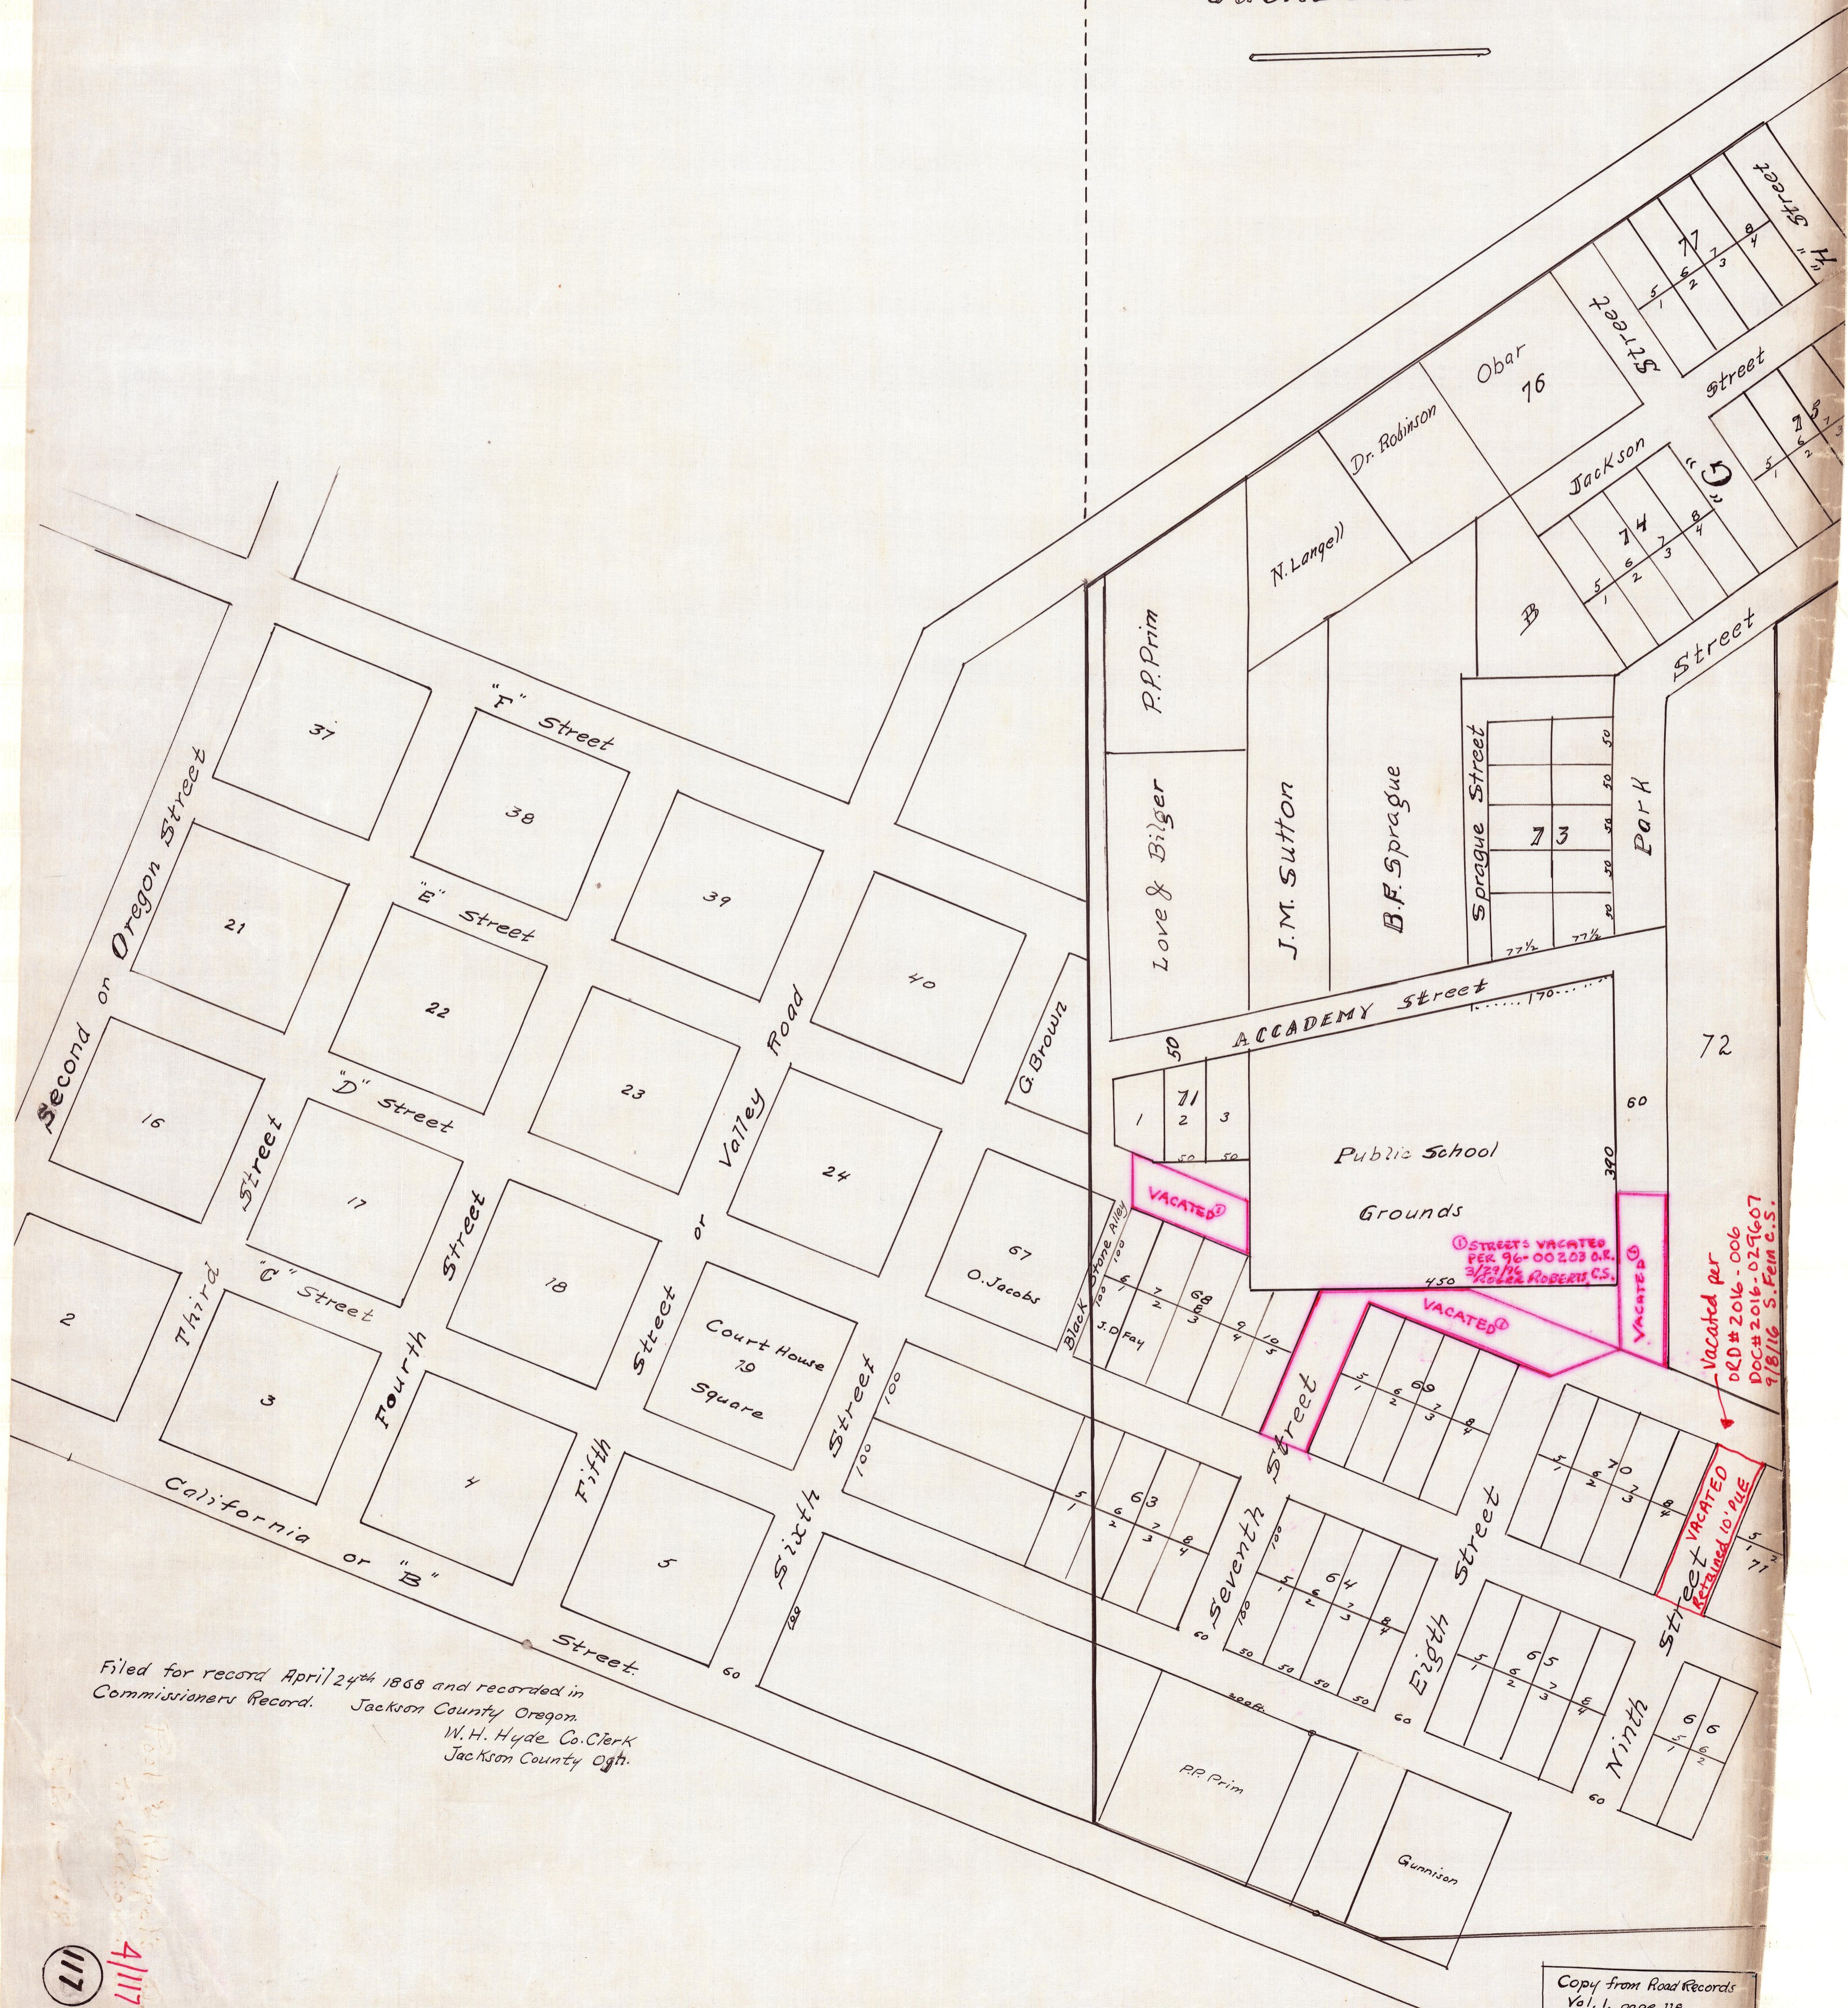

Filed for record April 24th 1868 and recorded in
 Commissioners Record. Jackson County Oregon.
 W.H. Hyde, Co. Clerk
 Jackson County Ogt.

VACATED
 Streets vacated per 96-00203 A.R.
 3/21/22 ROBERT C.S.
 450
 VACATED
 VACATED
 VACATED per
 O.C.D.# 2016-006
 D.C.# 2016-015607
 9/8/16 S. Fain C.S.

Set VACATED
 returned 10/2/22

117
 4117

Copy from Road Records
 Vol. 1, page 118
 Dec. 7, 1936 1:45 P.M.
 Checked by C.Z.B.