Plat of a Block of Lots in Rockpoint Surveyed for J. B. White
February 13th 1871.
Laying in Township 36 S.R. 3 W. Section 19

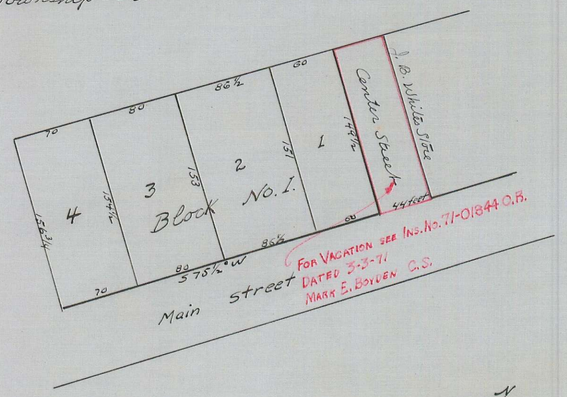

I do hereby certify that the above plat is correct as Surveyed by me February 13th. 1871.
Jas. S. Howard County Surveyor
Jackson County
Oregon.

Scale of feet

Filed March 10th 1871.
Silas J. Day County Clerk.

Copy from Road Records
Vol. 1 - page 203
Dec. 16, 1936 By F.M.P.
Checked By. C.E.B.

Plat of Rock Point.

Block No. 1 Surveyed February 13th 1871
Block No. 2, 3, 4, 5 & 6 Surveyed Nov. 23rd 1874
By Jas. S. Howard
Surveyor Jackson County Oregon.

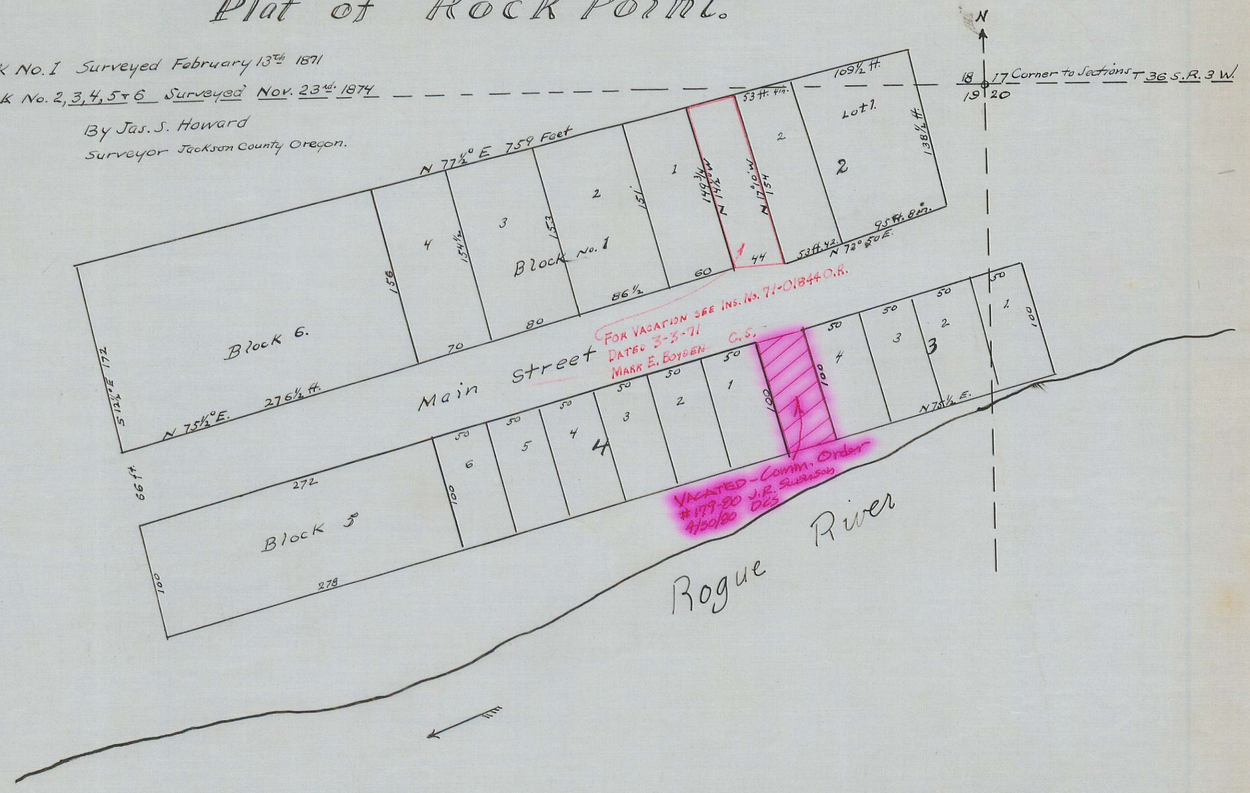

Know all Men by these presents that I have this day of presented the above plat of the town of Rock Point for record in the clerks office for the County of Jackson, State of Oregon.

Filed and recorded in the office of the County Clerk for Jackson County Oregon. on the 23rd day of January A.D. 1875 in Road map of said County.

County Clerk.
E. D. Fouraty.

Copy from Road Records
Vol. 1 - page 265
Dec. 16. 1936. By F.M.P.
Checked By C.E.B.

4/140
140