


# ORIG. PLAT OF

# SAM'S VALLEY

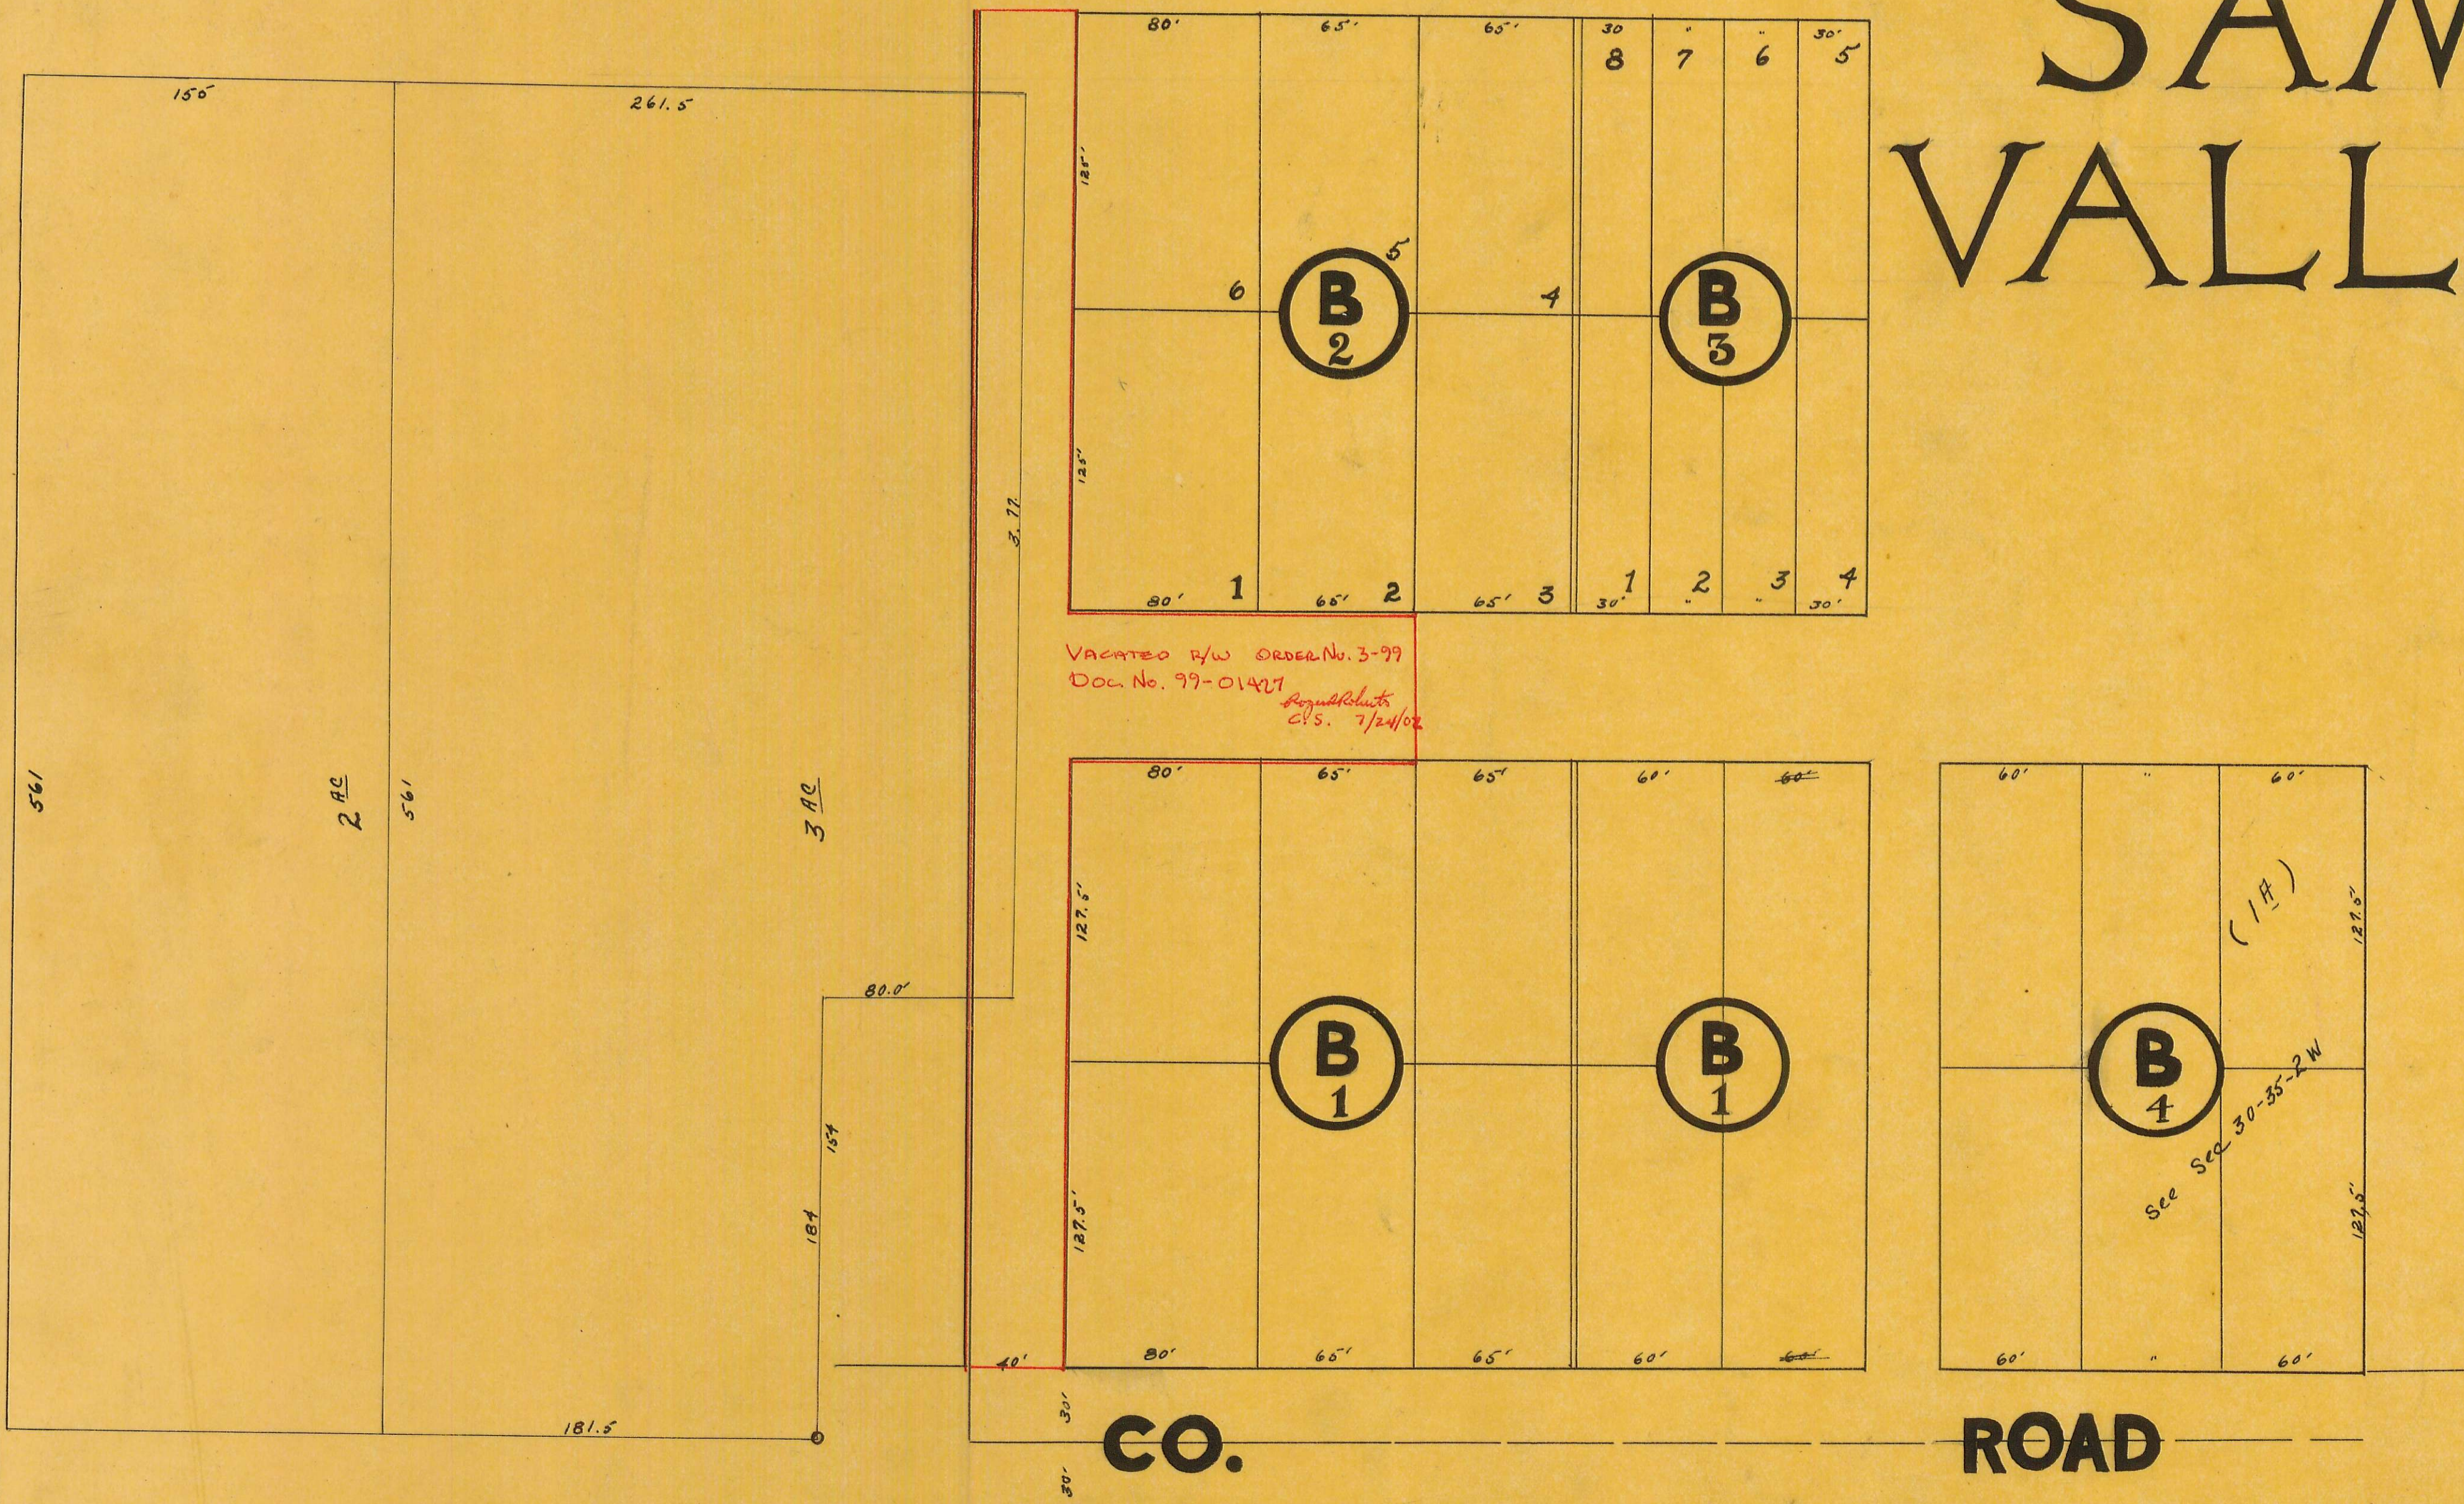

Copy from Co. Plat Book  
Vol. 13 Page 7  
April 19, 1941 by R.H.D.  
Checked by

CAUTION! THIS PLAT CONTAINS  
EXTREME INACCURACIES. SEE  
JOB FILE # 07-01 SEE C.S. July 8 4/158

Located in Block of Graham Co. 13 Town