
## BLOSSOM HILL TERRACE-UNIT NO. 2

LOCATED IN SECTION 19, T.37S., R.IW.W.M.

## MEDFORD, OREGON

HOVERDE

NOVEMBER 18, 1949 LELAND P. LOVEJOY 282

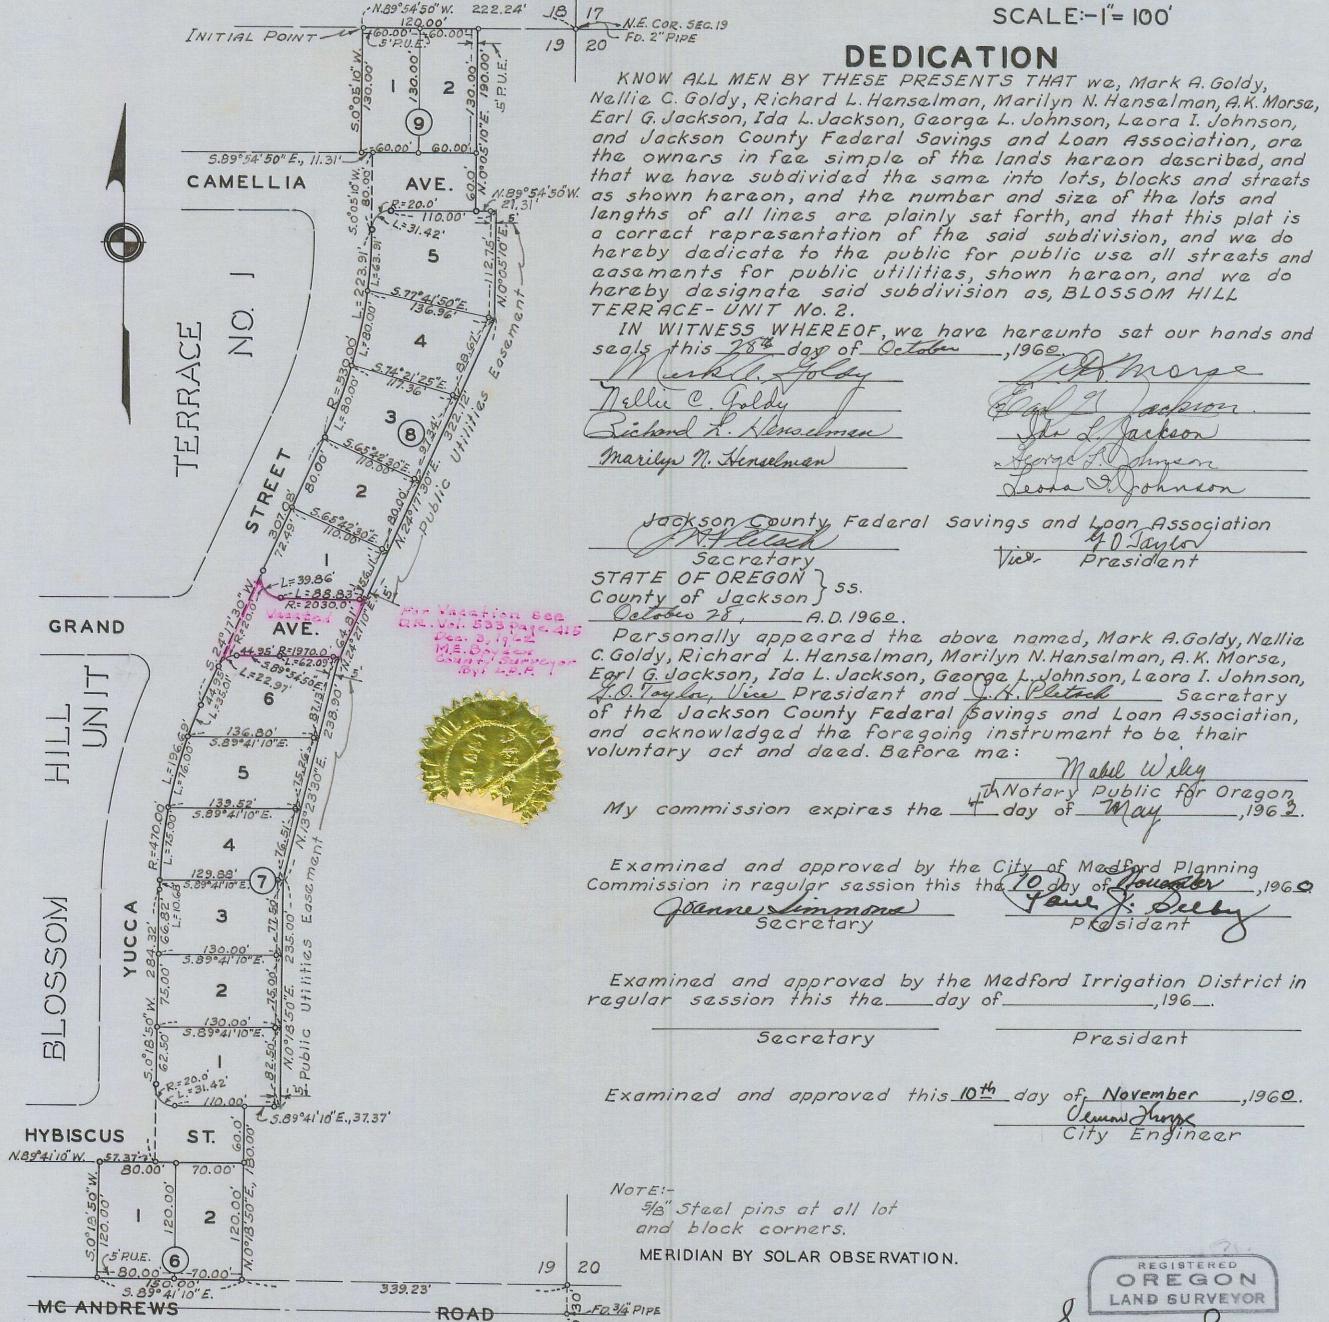

## SURVEYOR'S CERTIFICATE

STATE OF OREGON ) 55. I, Laland P. Lovejoy, a duly registered surveyor of the State of Oregon, being first duly sworn, do hereby certify that I have correctly surveyed and marked with proper monuments as provided by law the tract of land hereon shown, and the said plat is a correct representation of the same, and the following is an accurate description of the boundary lines; Beginning at a point in the northerly line of Section 19, Township 37 South, Range I West, W. M., Jackson County, Oragon, said point bearing N. 89° 54' 50" W., 222.24 feet from a found 2" pipe, said 2" pipe being the northeast corner of said Section 19; thence 5.0°05'10" W., 130.00 feet to north line of Comellia Avenue; thence 5.89°54'50" E., 11.31 feet along north line of said Camellia Avenue; thence 5.00 05'10" W., 80.00 feet; thence on the arc of a 530.00 foot radius curve to the right (the chord bears 5.12°11'20"W., 222.24 feet) a distance of 223.91 fact; thance 5.24°17'30" W., 307.08 fact; thance on the arc of a 470.00 foot radius curve to the left (the chord bears 5.12° 18' 10" W., 195.26 feet) a distance of 196.69 feet; thence 5.0° 18'50" W., 284.32 feet to south line of Hybiscus Street; thance N. 89° 41' 10" W., 57. 37 feet along south line of said Hybiscus Street; thence 5.0° 18'50" W., 120.00 fact to a point on the north line of ME Andrews Road; thence 5.89°41'10" E., 150.00 feet along the north line of said Mc Andrews Road; thence N. 0° 18' 50" E., 180.00 feet to north line of Hybiscus Streat; thence 5.89°41'10" E., 37.37 feet along north line of said Hybiscus Street; thence N. 0° 18' 50" E., 235.00 feet; thence N. 13°23'30" E., 238.90 feet to south line of Grand Avenue; thence N. 24°27'10" E., 64.81 feet to north line of said Grand Avenue; thence N. 24° 17'30" E., 322.12 fact; thence N. 0° 05'10" E., 112.75 feet to south line of Camellia Avenue; thence N.89°54'50" W., 21.31 feet along south line of said Camellia Avanua; thence N. 0° 05' 10" E., 190.00 feet to north line of said Section 19, said Township and Range; thence N. 89° 54' 50" W., 120.00 feet along north line of said Section 19 to point of beginning.

Subscribed and sworn to before me this 26 day of (October , 1960. Notary Public for foregon

My commission expires the\_

Examined and approved this 18thday of nov. County Assessor

All taxes paid in full to date this the Thoday of Wecember, 1900. County Sheriff

502312 Filed for record this & day of Ocenher, 1960, at 11:44 oclock a.M. and recorded in & Volume of Plats at Page 42 of records of Jackson County, Oregon, mmadele County Recorder

I hereby certify that this tracing is an exact copy of the original plat filed with the County Clark P. Lougow Surveyor