


SUNSET PARK.

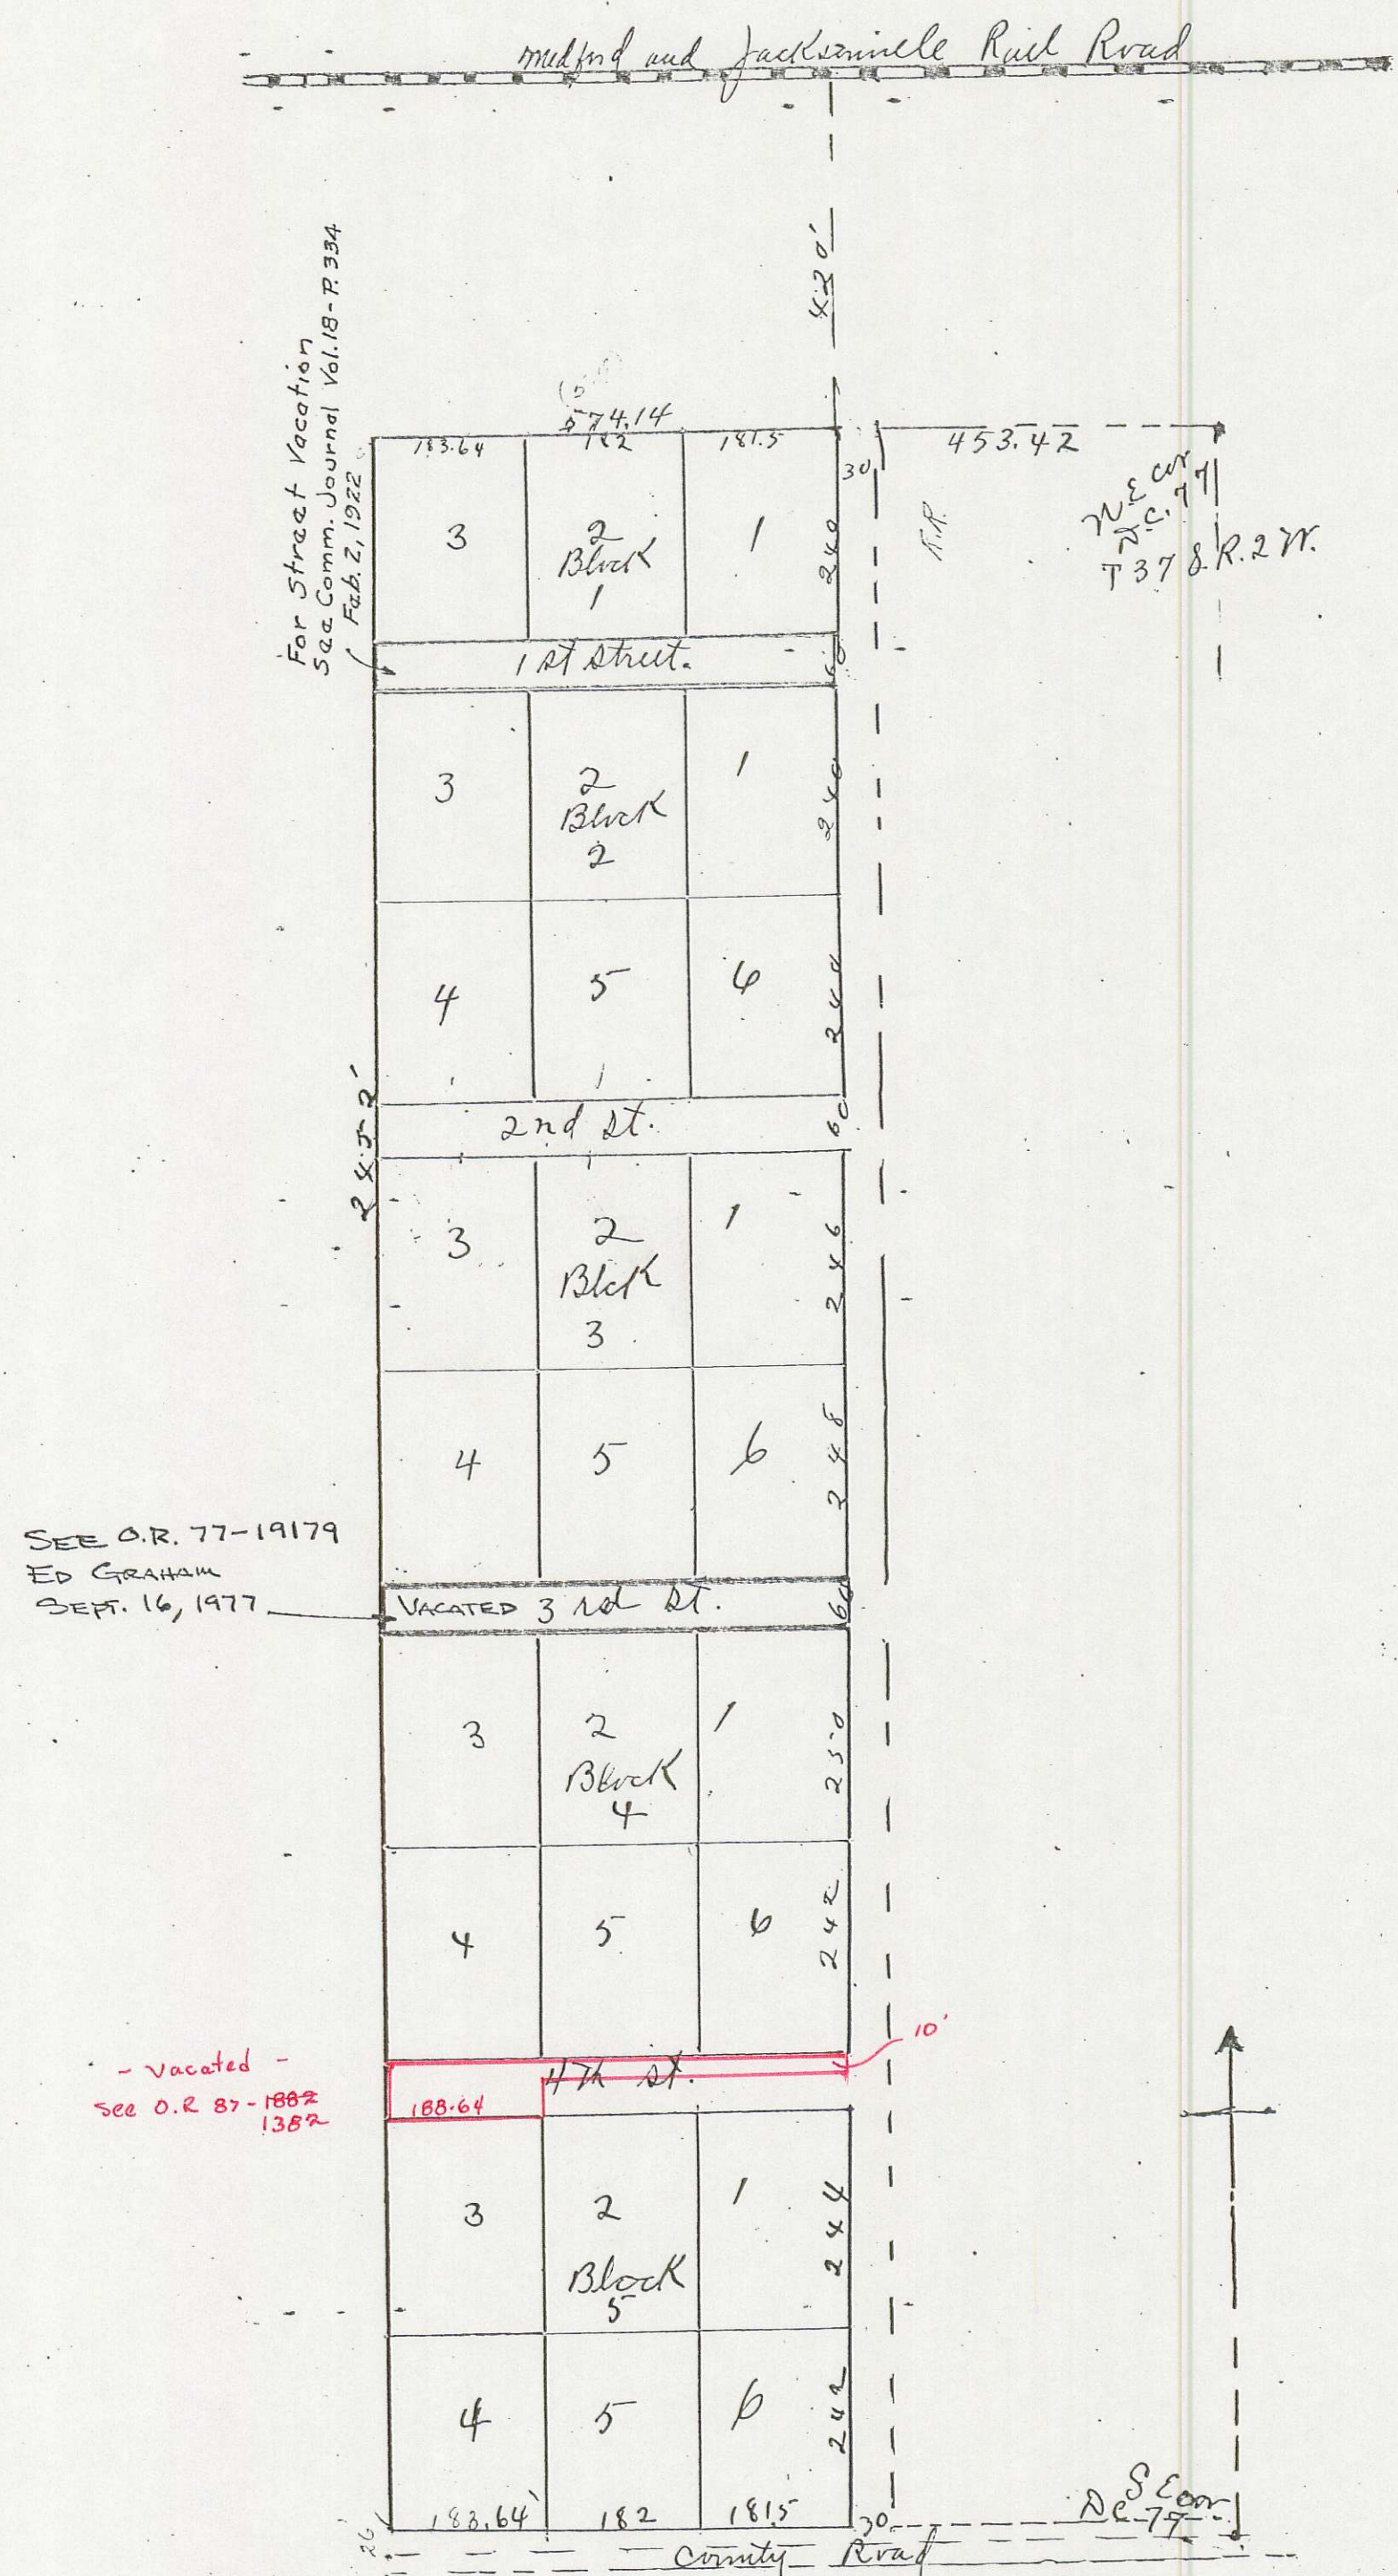

Description

The outside boundaries of the "Sunset Park" Subdivision are as follows to-wit: Beginning 11.88 feet North of and 453.42 feet West of Donation Land Claim Number 77 (Northeast corner of the same) and running thence West 547.14 feet; thence South 245.2 feet to the South boundary of the said claim; thence East 453.42 feet to a point from which the Southeast corner of said claim 77 bears East 453.42 feet; thence North 245.2 feet to the place of beginning; said tract being located in Sections 26 and 35 in T. 37 S. R. 2 W of the Willamette Meridian, State of Ore.

Dedication

Know all men by these presents, that we Harry C. Stoddard and Minnie Stoddard (husband and wife) are the owners in fee simple of the above described tract of land, and that we have laid out the same into Blocks and Lots and Streets as shown by the map of the same herewith attached and on which the number of the Blocks and the length of all lines and numbers of all Lots and the size hereof are plainly set forth on said map and all other matters appertaining to the subdivision of said tract are all plainly shown on said map. And we hereby dedicate to the Public for Public Highways all the streets shown on said map and we hereby designate said tract as subdivided as the "Sunset Park" and have so named it on the map herewith.

In witness whereof we have herewith set our hands and seals this 31st day of May 1907

Witness
W. G. Aldenbagen
John P. Lynch.

Harry C. Stoddard (Seal)
Minnie Stoddard (Seal)

I, J. S. Howard, do hereby certify that I surveyed the above described tract as shown by the map herewith and that said map is a correct representation of said survey as made by me on the ground on the 24 and 25 days of May A.D. 1907.

J. S. Howard, Surveyor.

Map examined and approved this 31st day of May A.D. 1907.
Peter Applegate ex-officio County Surveyor for Jackson County, Oregon

I filed for Record this 5th day of June A.D. 1907
R. P. Burnett, Recorder for Jackson County, Oregon.

For order of County Commissioner's Court approving this plat see Vol. Page of Commissioner's Journal of proceedings. W. R. Coleman, Clerk of Jackson County, Oregon.

State of Oregon
County of Jackson S.S.:

Personally came before me a Notary Public in and for said County and State the within named Harry C. Stoddard and Minnie Stoddard (husband and wife) all of Jackson County, State of Oregon, to me personally known to be the above named and who executed the above instrument and severally acknowledged to me that they executed the same freely and voluntarily for the purposes above mentioned.

In witness whereof I have herewith set my hand and official seal the day last above mentioned in said dedication.

L. C. Narregan
Notary Public for Oregon.

Filed May 31, 1907
W. R. Coleman, Co. Clerk.