


# MAP of TALLENT OREGON.

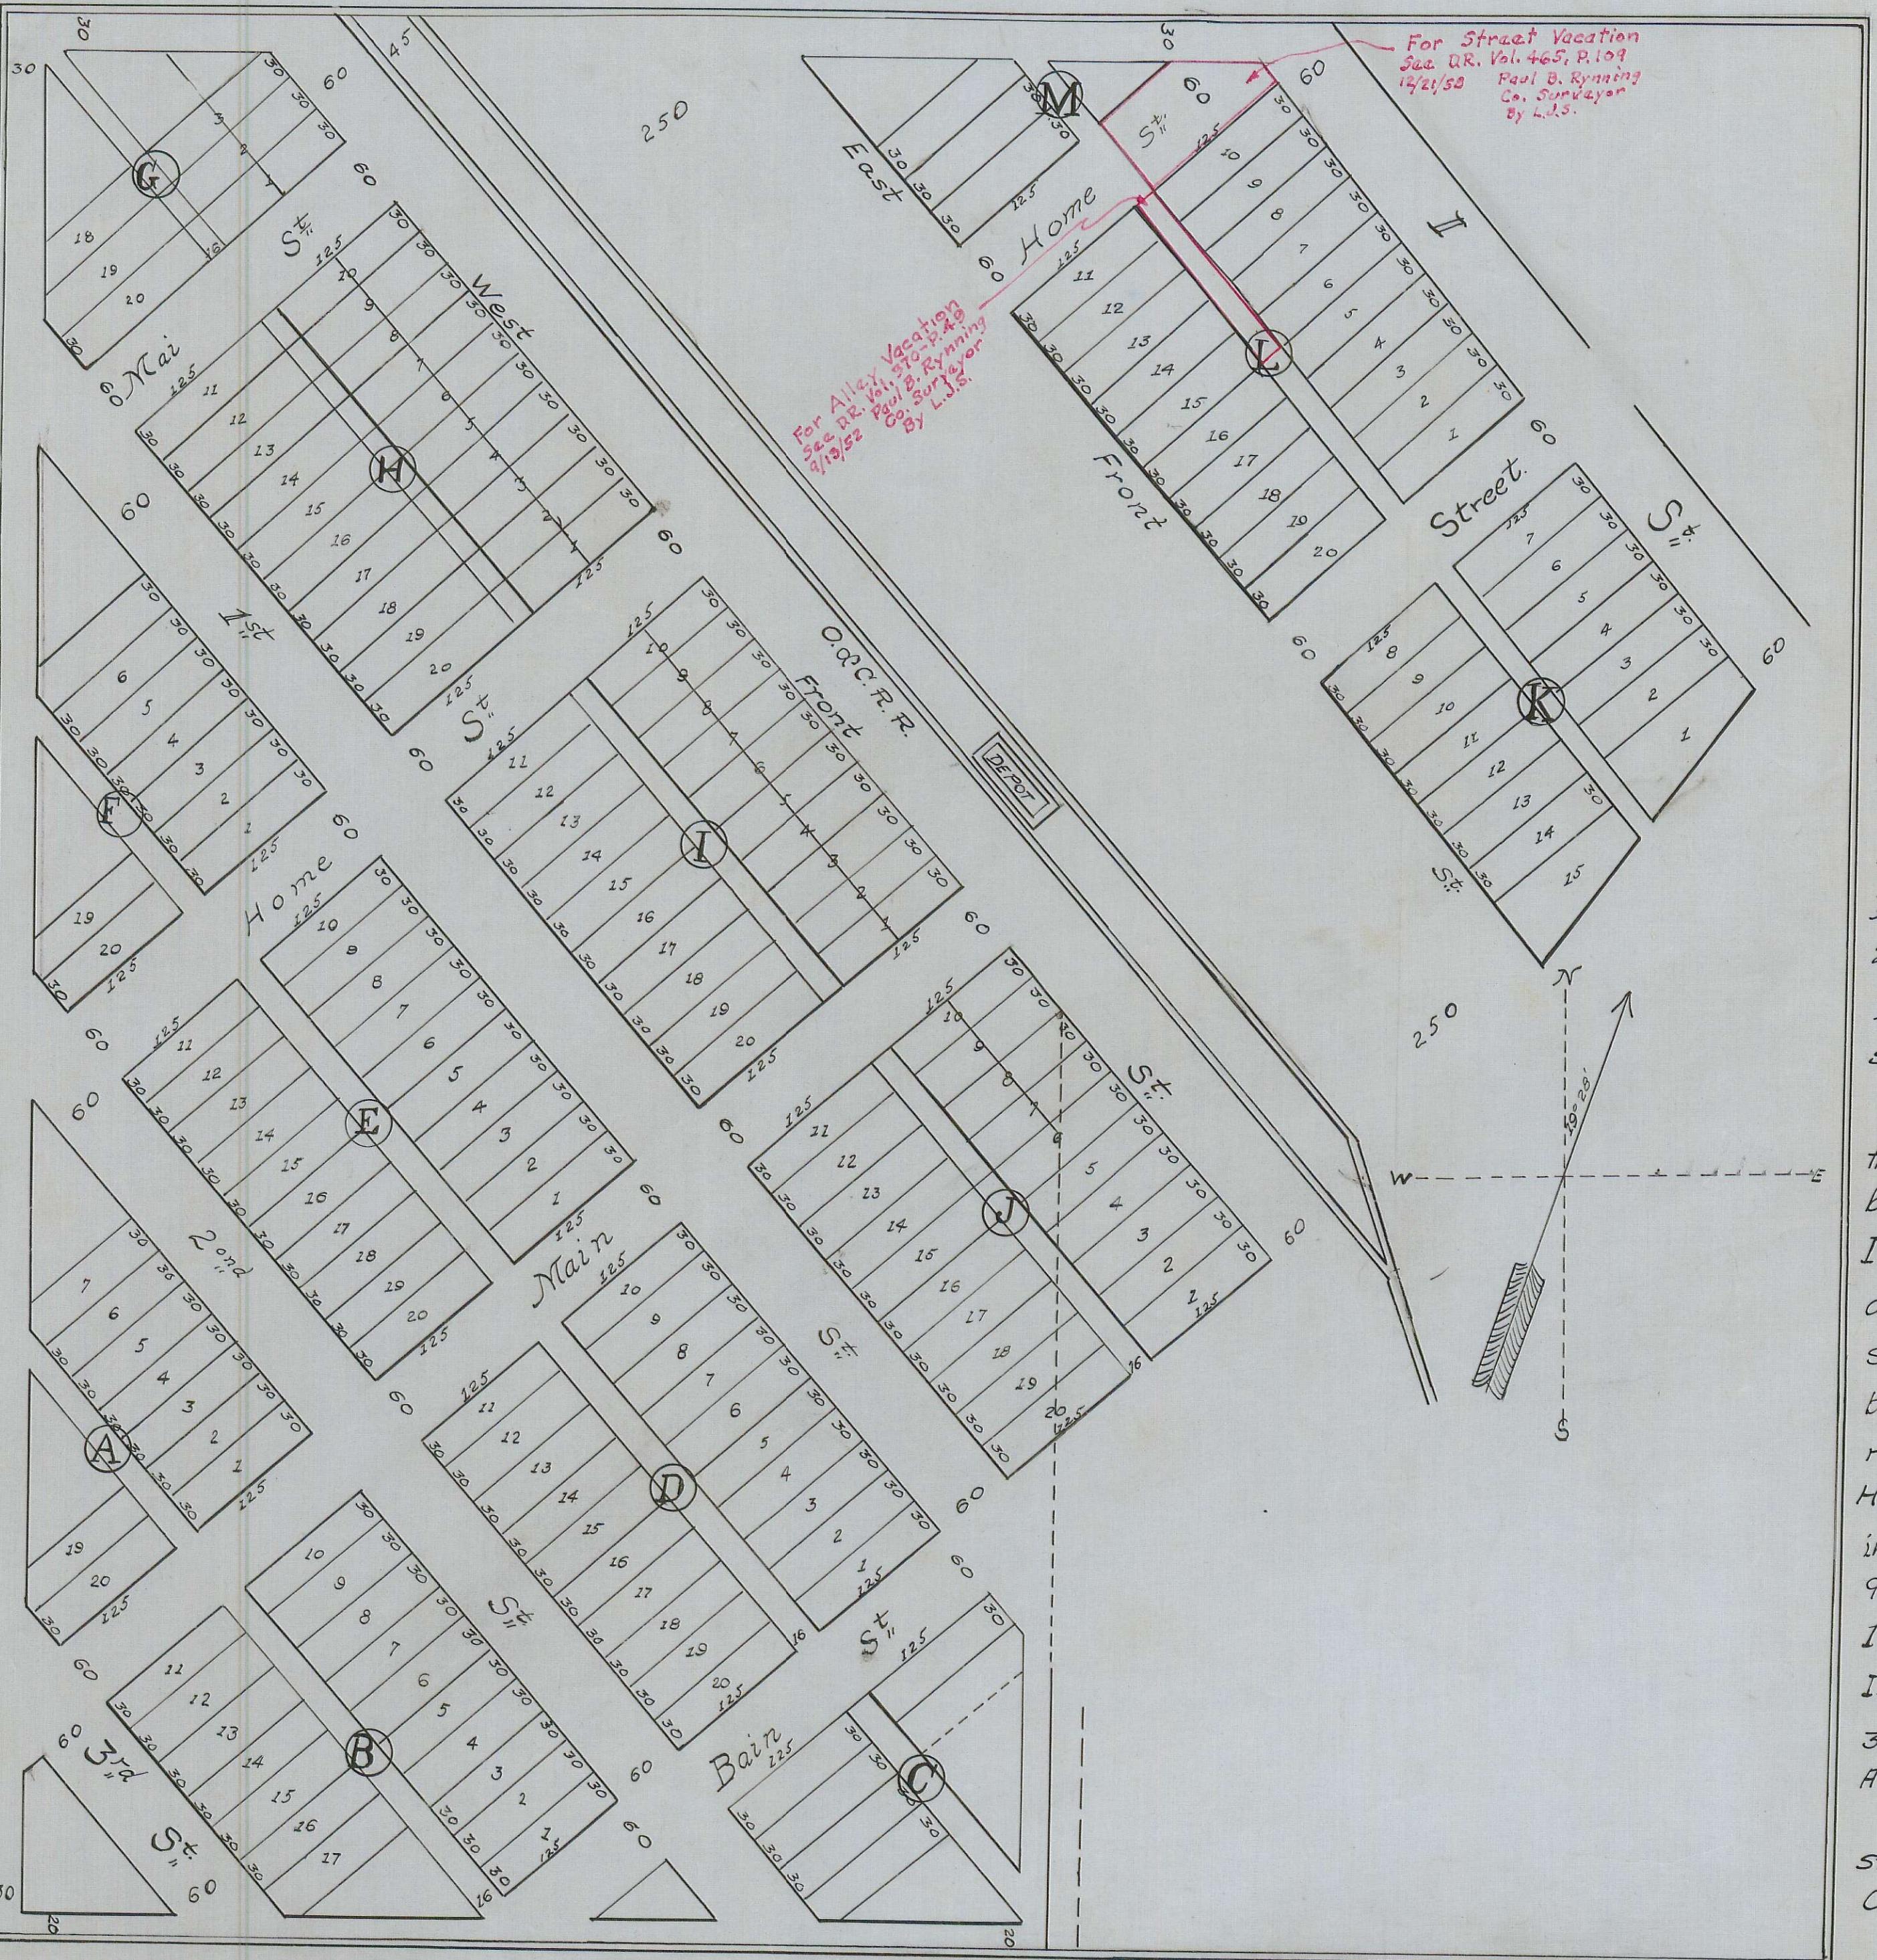

**THIS PLAT VACATED**  
BY COUNTY COMMISSIONER'S  
JOURNAL VOL 8 PAGE 103-123,  
DATED MARCH 7<sup>th</sup>, 1889—  
*Roger Roberts  
COUNTY SURVEYOR  
1/6/04*

State of Oregon } ss.  
County of Jackson } ss.  
I certify that the annexed Instrument  
was received and filed for record the 25<sup>th</sup> day of  
August 1888, at 10 o'clock A.M., and duly recorded  
the 29<sup>th</sup> day of August, 1888.

Max Muller  
County Clerk

Town of Tallent  
County of Jackson  
State of Oregon } ss.

To whom it may concern, These presents witnesseth that we the undersigned land owners and residents of the Town County and State aforesaid have dedicated to and donated for public uses as common Highways all the Streets and Alleys named and numbered on the accompanying plat hereto attached and made part of this dedicatory declaration, and that by these presents we do dedicate, donate and convey to the County of Jackson State of Oregon an unobstructed right of way through out the entire length and breadth of the Streets and Alleys above named.

In Witness Whereof we have here with affixed our names and seals the day and date first above written.

Witness Alice Sherman  
Geo. W. Wadsworth  
Chas. W. Sherman }

Effie Terrill  
Mrs. J. Patterson }

August 24<sup>th</sup> 1888.

Martha A. Talent  
A.P. Talent  
E.K. Anderson  
E.N. Anderson  
Laura V. Edwards  
Elizabeth Helms  
James Helms  
Geo. W. Edwards  
C.K. Klum  
Lucinda H. Klum  
Henry Amerman

(Seal)  
(Seal)

Copy from Deed Records  
Vol. 16 pages 328-329-330-331  
October 21, 1936. By F.M.P.  
Checked By C.I.B.

s. Sherman  
Notary Public

## Tallent

Description of Boundary line and statement of acreage occupied by Division No. 1 of Town Site.  
Beginning at the N.W. corner of Donation Claim No. 64 Twp. 38, S.R. 1 W.W.M. and running thence S. 21° 88' ohs to the Wagner Creek County Road, Thence East along said Wagner Creek County Road 11.94 ohs. to Lands of J.A. Packard. Thence N. along the West boundary of said J.A. Packard's lands 11.16 ohs. Thence N 42° 38' W. 14.54 ohs. to North boundary of Donation Claim No. 64 Twp. 38, S.R. 1 W.W.M. Thence West 212 chains to point of beginning containing 20.86 Acres. Divided into lots and Blocks by the following streets and Alleys shown on the accompanying Plat towit.

West Front Street 60 feet in width runs S. 42° 38' E. from the North boundary of the aforesaid Donation Claim to South boundary of Lot 8 in Block J a distance of 1020 feet 1<sup>st</sup> 2<sup>nd</sup> & 3<sup>rd</sup> S<sup>th</sup>, run in course parallel to West Front St. and are each 60 feet in width. Mai St. begins at a point bearing S. 42° 38' E. from the intersection of West Front St. with the North boundary of the aforesaid donation Claim distant 150 feet and runs S. 47° 22' W. 266 feet and is 60 feet in width.

Home, Main and Bain Streets are parallel to Mai St. each 60 feet in width and in length as follows towit Home St. 467 feet Main St. 918 feet Bain St. 467 feet 1<sup>st</sup> 2<sup>nd</sup> and 3<sup>rd</sup> St. are in lengths as follows 1<sup>st</sup> 1200 feet, 2<sup>nd</sup> St. 930 feet 3<sup>rd</sup> 330, all full Lots in Blocks G, H, I and J are 30 x 206 feet. All full Lots in Blocks C.D.E and F are 30 x 125 feet and are separated from each other on the rear by an Alley 16 feet in width.

State of Oregon } ss.  
County of Jackson } ss.

This certifies, That on this Twenty-fourth(24) day of August A.D. 1888, before me, the undersigned, a Notary Public in and for said County and State, personally appeared the within named A.P. Talent, Martha H. Talent, E.K. Anderson, E.N. Anderson, Laura V. Edwards, Elizabeth Helms, James Helms, Geo. W. Edwards, C.K. Klum Lucinda H. Klum Henry Amerman who are known to me to be the identical persons described in, and who executed the within instrument and acknowledged to me that they executed the same freely and voluntarily for the uses and purposes therein mentioned.

In Testimony Whereof I have here unto set my hand and seal the day and year last above written. This (24<sup>th</sup>) Twenty Fourth day of August A.D. 1888.

(L.S.)

210

Talent (1888)

D.R. 16-328-29-30-31

41210