


# MAP OF JACKSONVILLE

SCALE: 1"=200'

I, Paul B. Rynning, County Surveyor Jackson County, Oregon hereby certify that this map is a copy of the original filed in Jackson County Road Records Book 1, Page 197, and made in compliance with the Oregon Laws, Section 95-1307a. Jan. 27, 1950.  
 Drawn by - L.J. Shorey  
 Check by - M.E. Boyden

*Paul B. Rynning*  
 County Surveyor

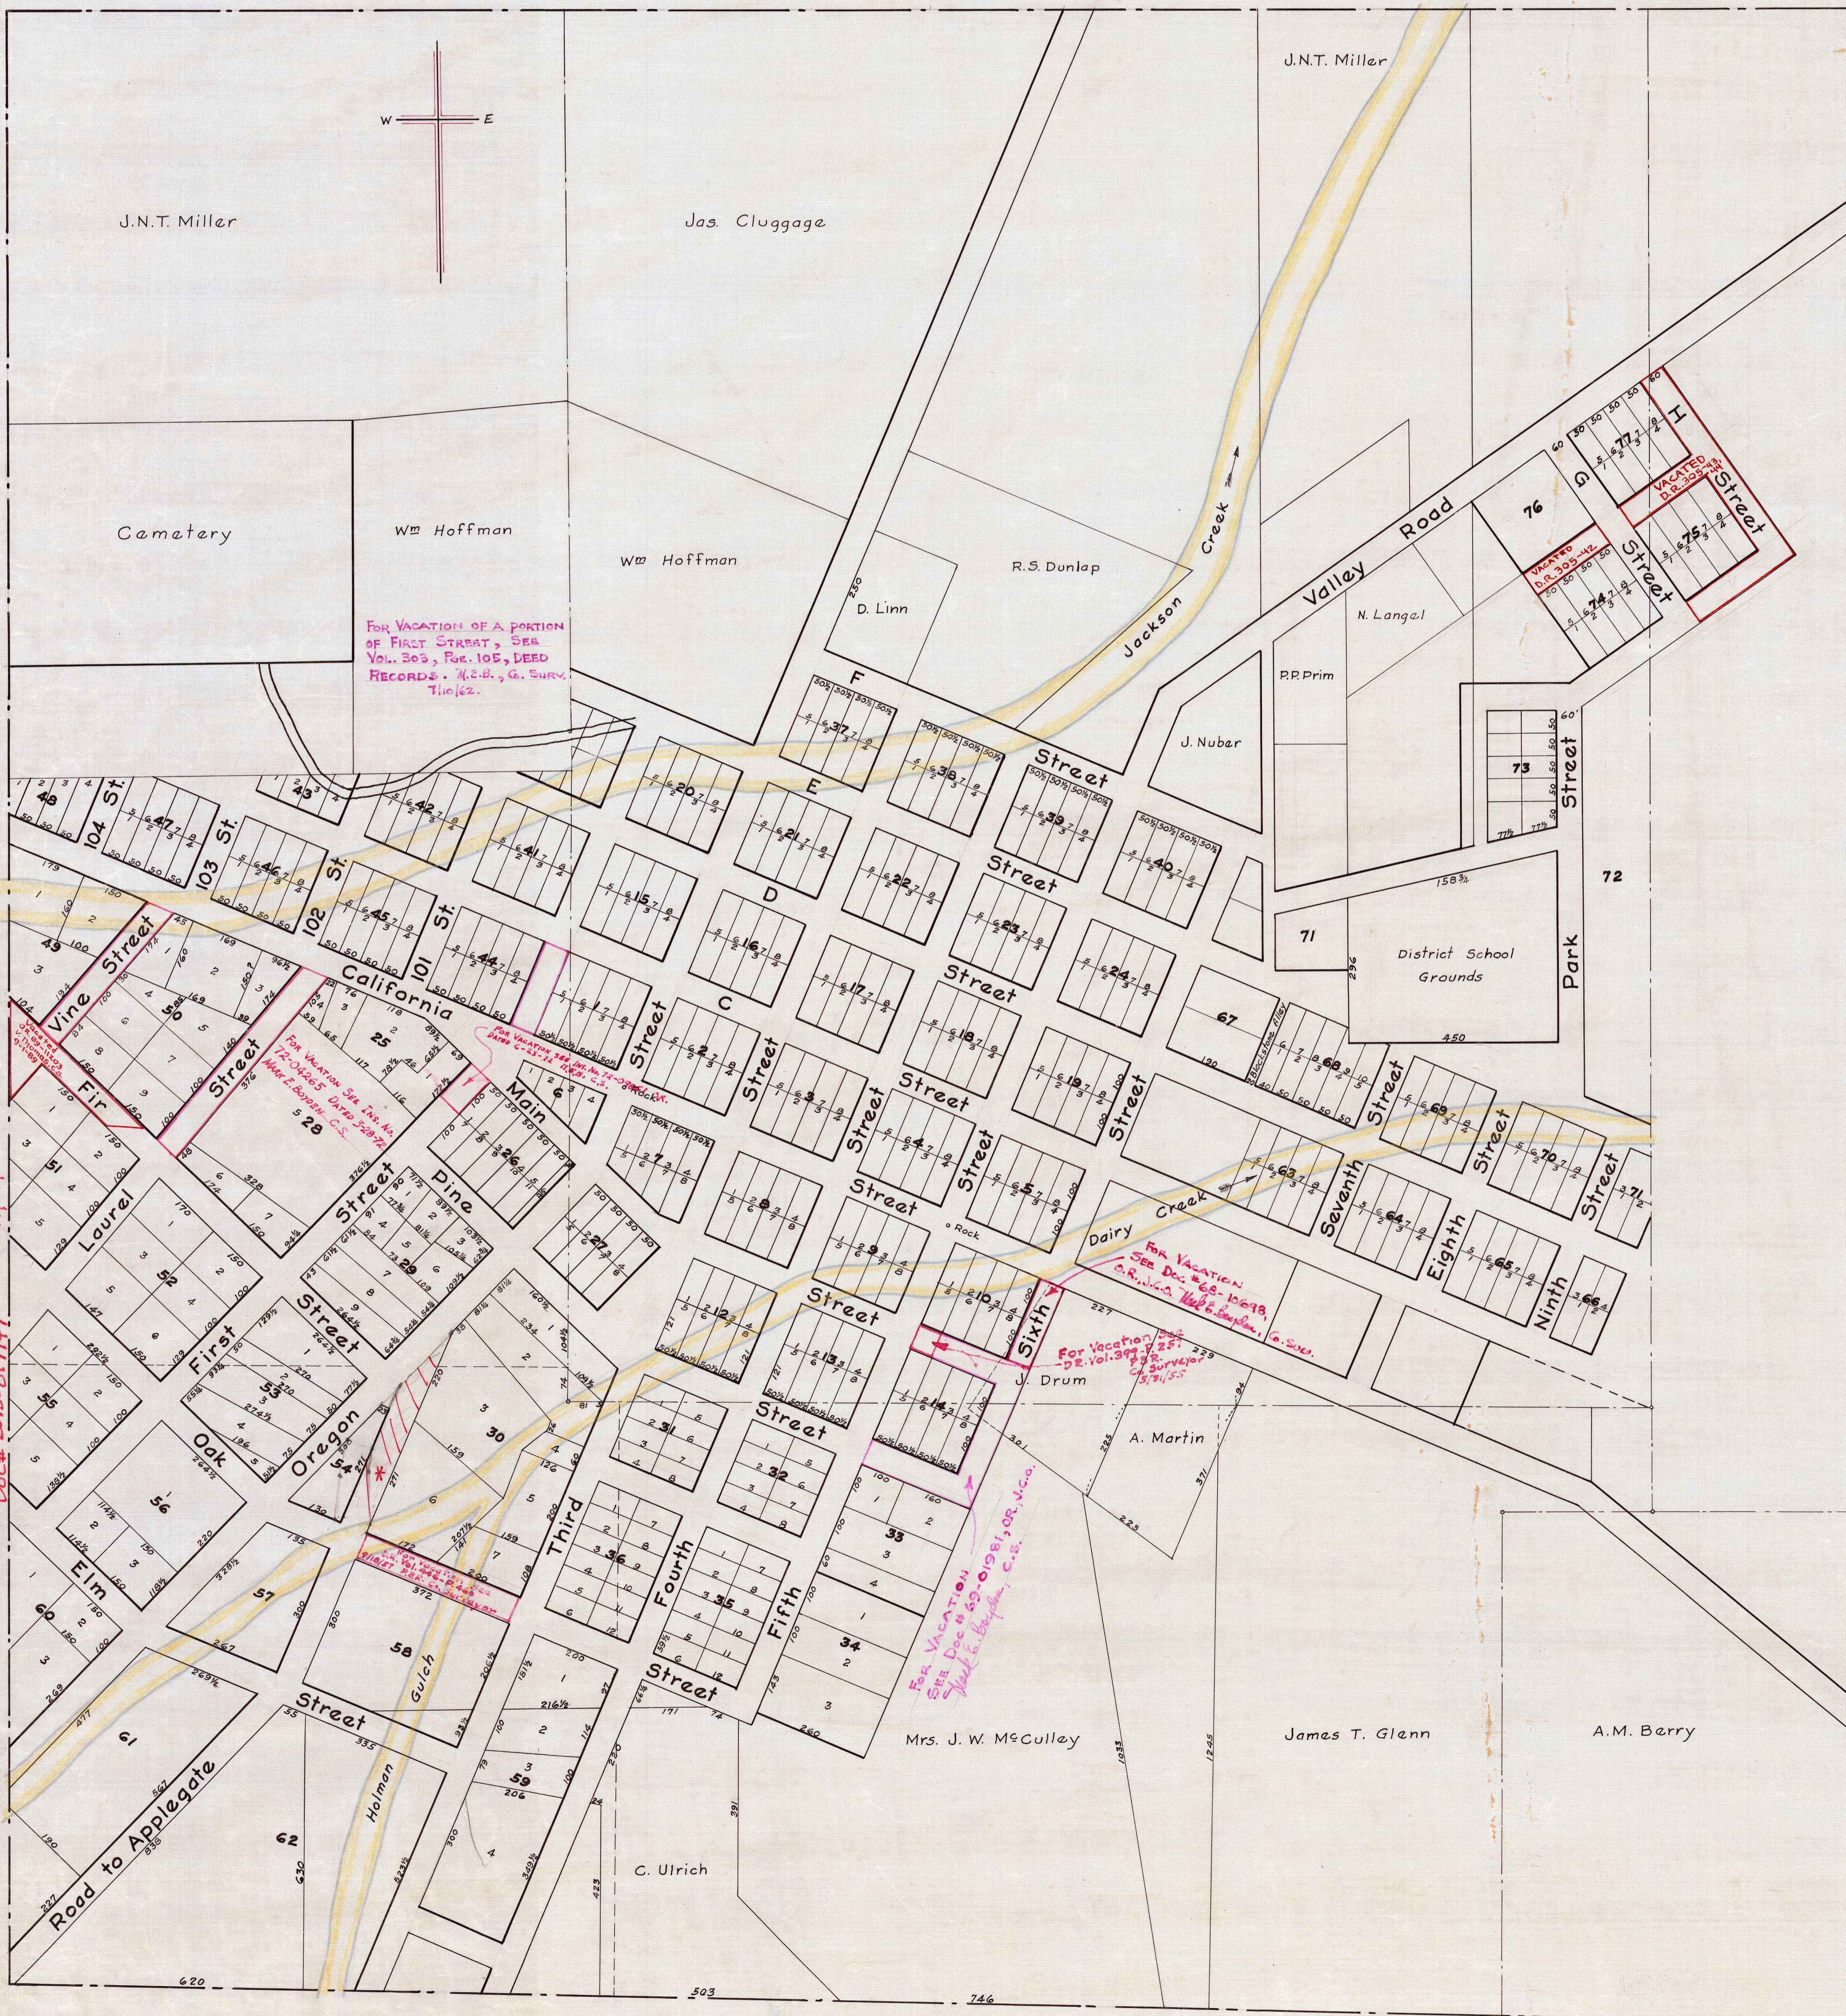

\* A Portion of Applegate Rd. # Also see, "Applegate Rd" Doc # 2017-002322 Vacated 06/18/2015 Doc # 2015-019147 01/23/2017

FOR VACATION OF A PORTION OF FIRST STREET, SEE Vol. 203, Pgs. 105, DEED RECORDS - M.E.B., G. SURV. TIMEZ.


1000