


# CONSOLIDATED ADDITION NO.3 TO THE CITY OF MEDFORD OREGON

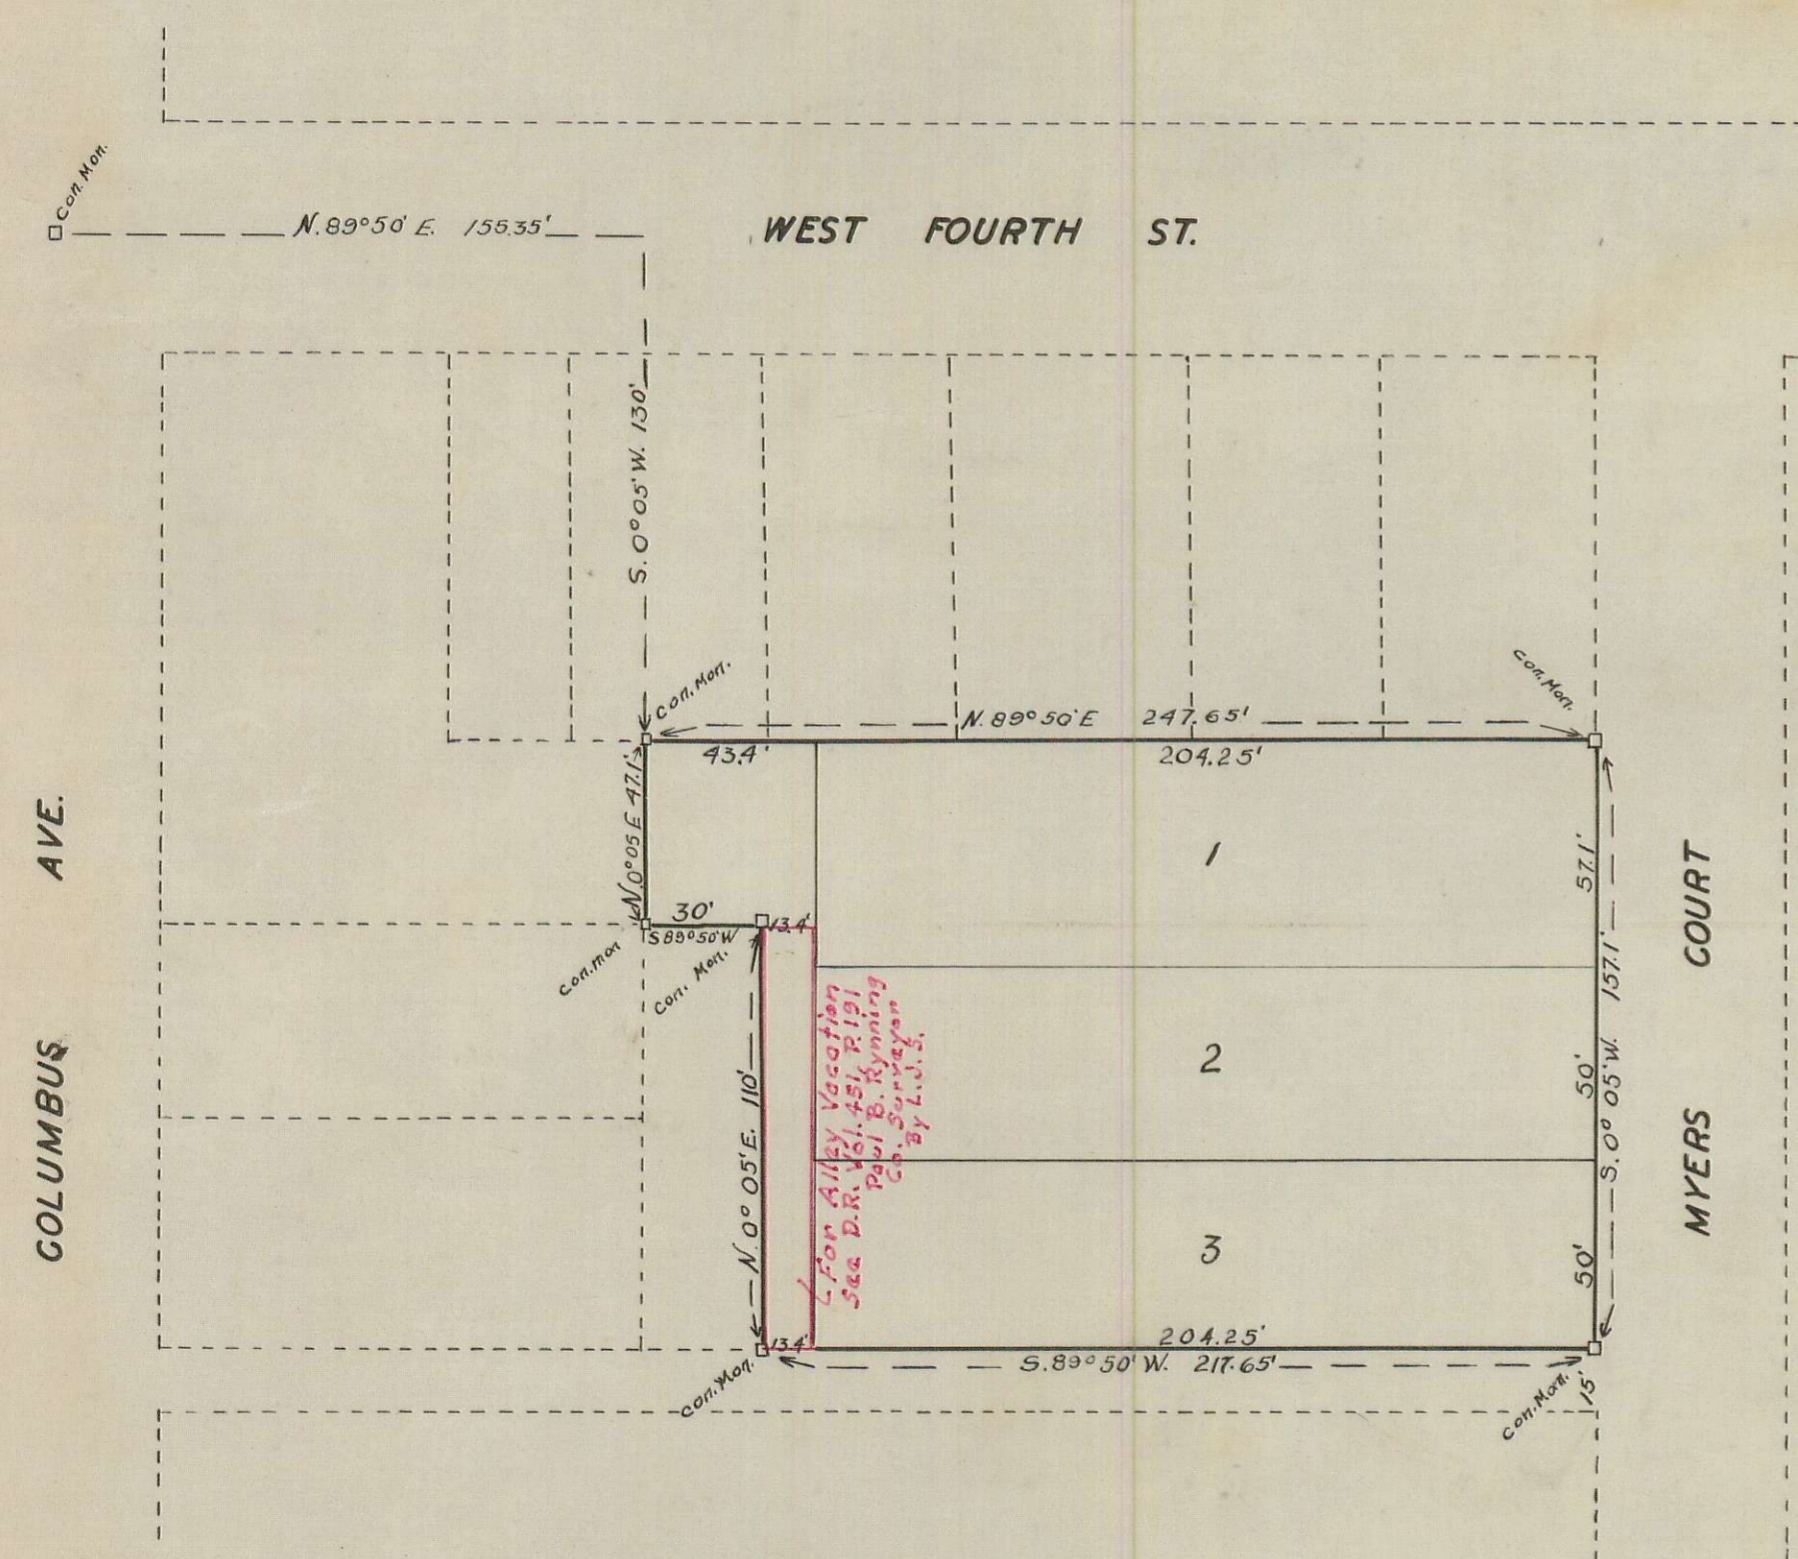

**DESCRIPTION.**

BEGINNING AT A GEMENT MONUMENT AT THE INTERSECTION OF THE CENTERLINE OF WEST FOURTH STREET AND THE CENTERLINE OF COLUMBUS AVENUE IN THE CITY OF MEDFORD, JACKSON COUNTY, STATE OF OREGON: RUNNING THENCE NORTH 89° 50' EAST 155.35 FEET: THENCE SO. 0° 05' WEST 130 FEET FOR A TRUE POINT OF BEGINING: THENCE NORTH 89° 50' EAST 247.65 FEET PARALLEL WITH WEST FOURTH STREET, TO THE WEST LINE OF MYERS COURT: THENCE SOUTH 0° 05' WEST ALONG THE WEST LINE OF MYERS COURT 157.1 FEET: THENCE SOUTH 89° 50' WEST AND PARALLEL WITH WEST FOURTH STREET 217.65 FEET: THENCE NORTH 0° 05' 110 FEET: THENCE SOUTH 89° 50' WEST 30' THENCE NORTH 0° 05' 47.1 FEET TO THE POINT OF BEGINNING. CONCRETE MONUMENTS WITH LEAD POINT CENTERS AT ALL CORNERS. 3/4" X 18" IRON PIPE AT ALL LOT CORNERS.

**DEDICATION.**

KNOW ALL MEN BY THESE PRESENTS, THAT THE CITY OF MEDFORD, A MUNIPAL CORPORATION DULY ORGANIZED AND EXISTING UNDER THE LAWS OF THE STATE OF OREGON, IS THE OWNER IN FEE SIMPLE OF THE ABOVE DESCRIBED LAND: THAT THE CITY OF MEDFORD HAS LAID OUT THE SAME INTO LOTS, BLOGKS, STREETS AND ALLEYS, AS SHOWN ON THE MAP HEREON, AND THAT THE SAID MAP IS A CORRECT REPRESENTATION OF SAID SURVEY AND SUBDIVISION AND WE DO HEREBY DEDICATE TO THE PUBLIC FOR PUBLIC HIGHWAYS ALL THE STREETS AND ALLEYS SHOWN ON SAID TRACT AND DO HEREBY DESIGNATE AND NAME THE SAID TRACT AS SHOWN HEREON AS CONSOLIDATED ADDITION NO.3 TO THE CITY OF MEDFORD, STATE OF OREGON.

IN WITNESS WHEREOF THE CITY OF MEDFORD HAS CAUSED THESE PRESENTS TO BE SIGNED BY THE MAYOR AND THE REGORDER OF SAID CITY AND ITS CORPORATE SEAL TO BE AFFIXED THIS 17 TH DAY JUNE A.D. 1938.

IN WITNESS WHEREOF  
*G. G. Furnas*  
 Mayor  
*M. L. Alford*  
 STATE OF OREGON } SS.  
 COUNTY OF JACKSON

BY *G. G. Furnas*  
 MAYOR  
 BY *M. L. Alford*  
 REGORDER

PERSONALLY APPEARED BEFORE ME, A NOTARY PUBLIC IN AND FOR SAID COUNTY AND STATE, THE WITHIN NAMED G. G. FURNAS AND M. L. ALFORD, MAYOR AND REGORDER RESPECTIVELY OF THE CITY OF MEDFORD OREGON, TO ME PERSONALLY KNOWN TO BE THE ABOVE NAMED AND WHO EXEGUTED THE ABOVE INSTRUMENT AND SEVERALLY AKKNOWLEDGED TO ME THAT THEY EXEGUTED THE SAME FREELY AND VOLUNTARILY FOR THE PURPOSE HEREIN MENTIONED.

*J. O. Grey*  
 NOTARY PUBLIC.

I, D.T. MGDONOUGH, HEREBY CERTIFY THAT THIS PLAT WAS MADE FROM NOTES TAKEN DURING AN ACTUAL SURVEY AND THAT THE PLAT HEREON IS A CORRECT REPRESENTATION OF SAID SURVEY AND SUBDIVISION.

*D. McDonough*  
 SURVEYOR.

SUBSCRIBED AND SWORN TO BEFORE ME THIS 18 DAY OF June 1938.

*J. O. Grey*  
 NOTARY PUBLIC.

EXAMINED AND APPROVED BY ME 18TH DAY OF JUNE 1938.

*D. McDonough*  
 CITY ENGINEER.

EXAMINED AND APPROVED BY THE MEDFORD CITY PLANNING COMMISSION IN REGULAR SESSION THIS 18TH OF MAY 1938.

*J. W. Roberts*  
 SECRETARY  
*W. Bernard Roberts*  
 PRESIDENT.

EXAMINED AND APPROVED BY ME THIS 19 DAY OF July 1938.

*J. B. Coleman*  
 COUNTY ASSESSOR.

ALL TAXES PAID IN FULL TO THIS DATE 19 DAY OF July 1938.

*Sydney Brown*  
 COUNTY SHERIFF

FOR ORDER OF COUNTY COMMISSIONERS APPROVING THIS PLAT SEE PAGE \_\_\_\_\_ VOL. \_\_\_\_\_ OF THE COMMISSIONERS JOURNAL OF PROCEEDINGS.

155351  
 FILED FOR RECORD THIS 22 DAY OF July 1938 AND RECORDED ON  
 PAGE 3 VOL. 6 OF PLATS.

*J. W. Roberts*  
 CLERK OF JACKSON COUNTY

*J. W. Roberts*  
 COUNTY RECORDER.

D. McDonough