

HIGHTS
SUBDIVISION
 OF PART OF LOT 5 BLOCK 2
MINGUS SUBDIVISION
 CITY OF MEDFORD
 JACKSON COUNTY OREGON

Scale 1" = 50 feet
 Surveyed April 1925
 by C. Z. Boyden
 Dept. Co. Surveyor

DESCRIPTION. Beginning at a point marked by a Sandstone 8"x8"x14" with cross and copper slug in top, set 1/2 foot below the surface of the ground from which the S E corner of Lot 5 BLK 2 MINGUS SUBDIVISION to the City of Medford, Oregon, bears 50°22' E 30.0 feet. Thence N0°22' W to a sandstone 7"x8"x12" with cross on top set 1/2 foot below the surface of the ground to mark the North corner of lot No 16 of this subdivision. Thence continue N0°22' W to the center of M^{rs} ANDREW ST a total distance of 1009.47 feet. Thence S41°46' W along the center line of said Street 373.83 feet. Thence 50°22' E 732.70 feet. Thence N89°32' E 250.80 feet to the point of beginning.

State of Oregon } ss. I, C. Z. Boyden, being first duly sworn do hereby certify that I have
 County of Jackson } duly surveyed, and marked with proper monuments the above described tract of land,
 as shown by the plat hereon, and that said plat is a correct representation of said survey
 as made by me on the ground in April 1925.

Subscribed and sworn to before me this 7th day of April 1925
 My commission expires 7th day of January 1929
 Notary Public for Oregon.

All taxes paid to date: Ralph G. Jennings
 Sheriff.

DEDICATION. Know all Men by these Presents that we J. D. HIGHT and ANTHA J. HIGHT husband and wife of Jackson County, State of Oregon, are the owners of the above described Subdivision, that we have laid out the same into Lots and Streets, as shown hereon, and that said plat is a correct representation of the survey and Subdivision, and that we do hereby dedicate to the Public for Public use all Streets as shown upon said plat, and that we do hereby designate and name the said Subdivision as HIGHTS SUBDIVISION.

In witness whereof we have hereunto set our hands and seals
 this 7th day of April 1925.
 Done in the presence of
 Jefferson C. Carlson Witness
 Fred N. Cummings Witness
 J. D. Hight
 Antha J. Hight

State of Oregon } ss. On this 7th day of April 1925 personally appeared before me a Notary Public in
 County of Jackson } and for said County and State, the above named J. D. HIGHT and ANTHA J. HIGHT husband and wife of
 Jackson County, State of Oregon, to me personally known to be the above named, who executed the
 above instrument and who severally acknowledged to me that they executed the same freely and
 voluntarily for the purposes herein mentioned.
 Subscribed and sworn to before me the day and date above written
 My commission expires January 7 1929
 Notary Public for Oregon.


Examined and approved by City Planning Commission in regular Session 13th day of April 1925.
 Attest: Robert H. Baul Secretary
 O. C. Boyden President

Examined and approved by City Council in regular Session 14th day of April 1925.
 Attest: Recorder
 Mayor

Examined and approved this 6 day of May 1925
 County Assessor

Filed for record this 13 day of May 1925 and duly recorded in Volume 5 Page 23 Book of Plats
 50928
 County Clerk.

Examined and recommended for approval of County.
 J. Griffith Lowgill
 County Surveyor.

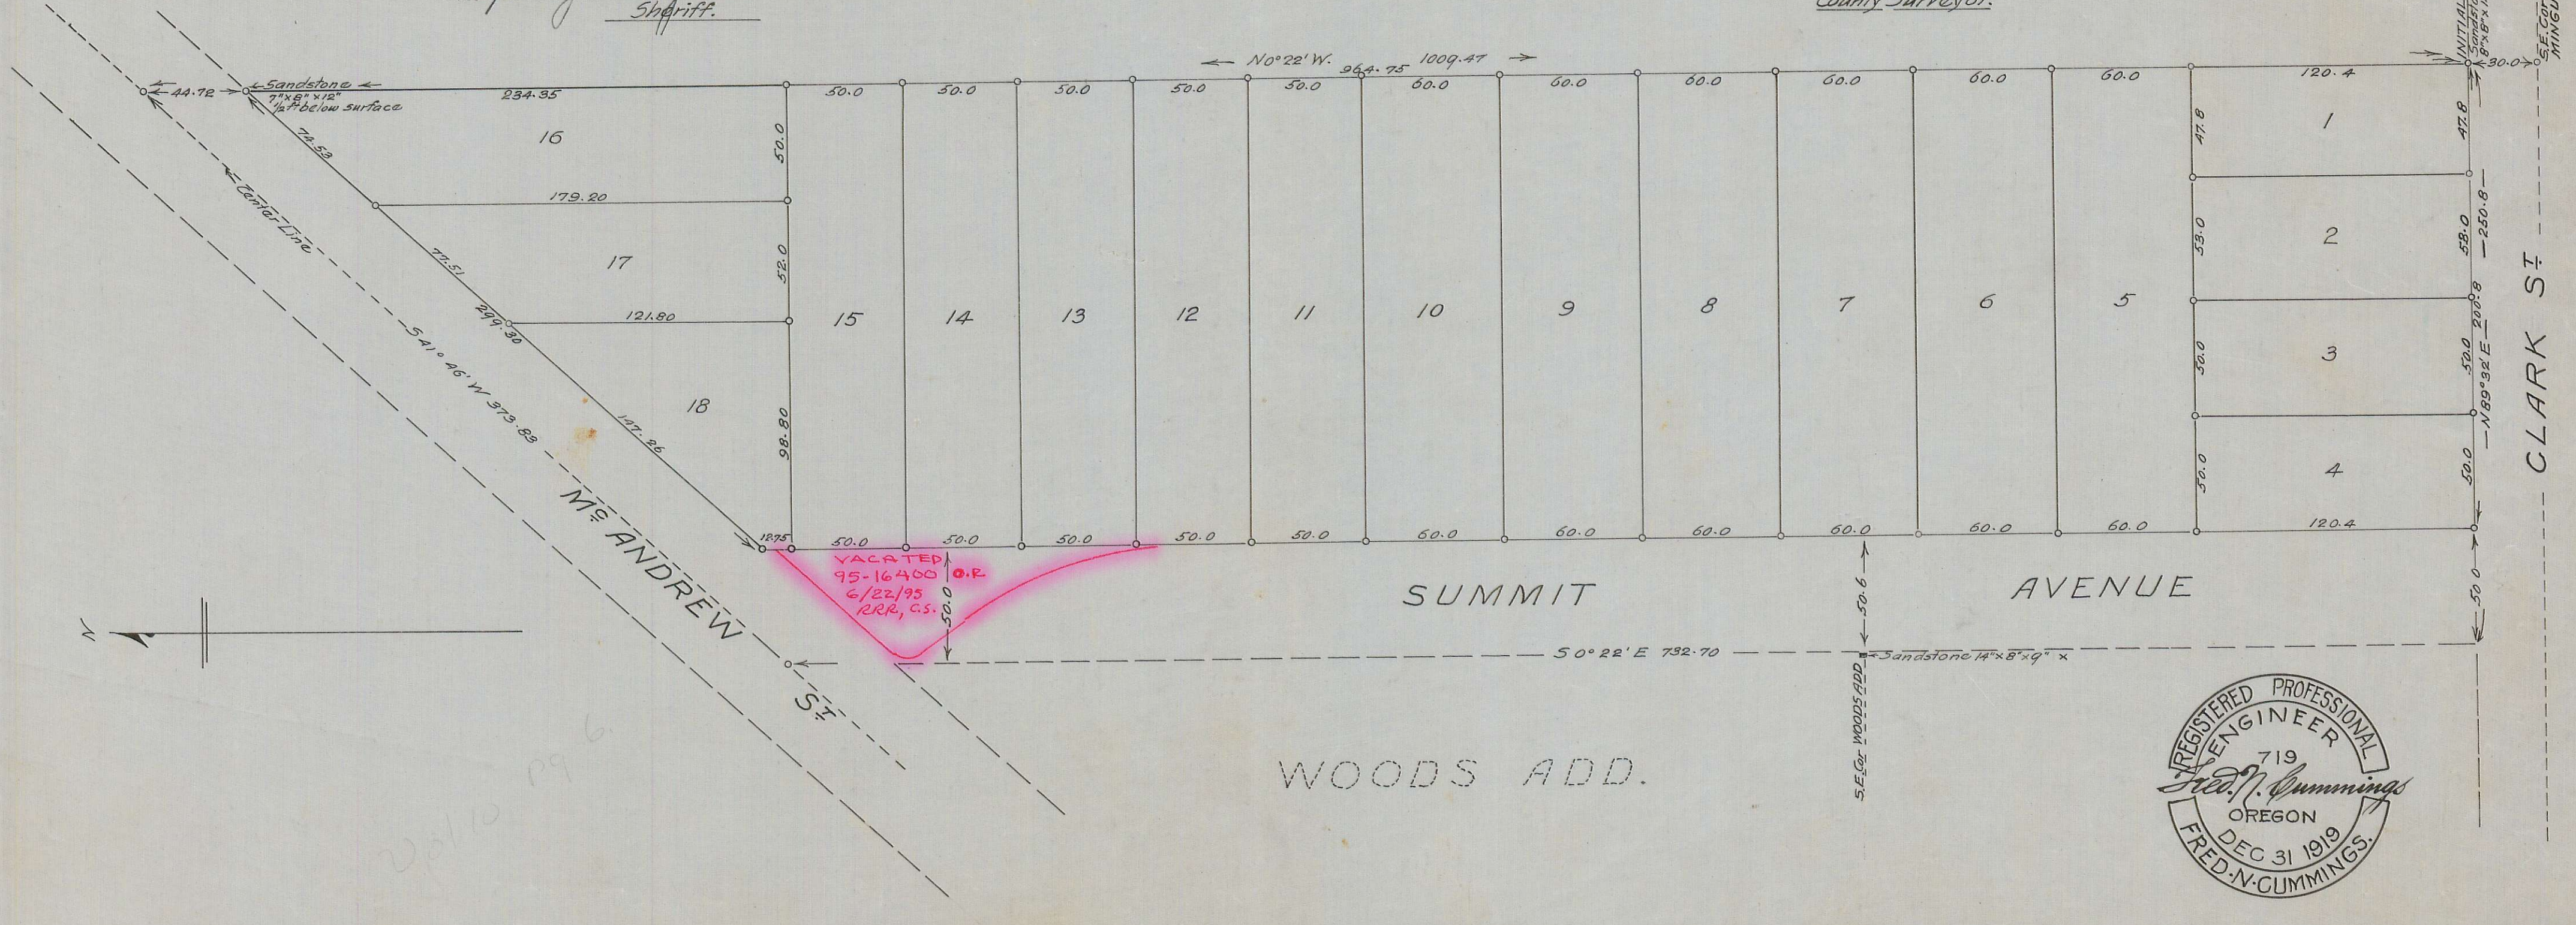

Plotted