CENTRAL PARK SUBDIVISION

JACKSON COUNTY, OREGON. POWELL AND WOOD ENG'RS.

SCALE: 50 FEET TO 1 INCH. NOVEMBER - 1928.

Note: 1½ inch pipe set at all lot and block corners.

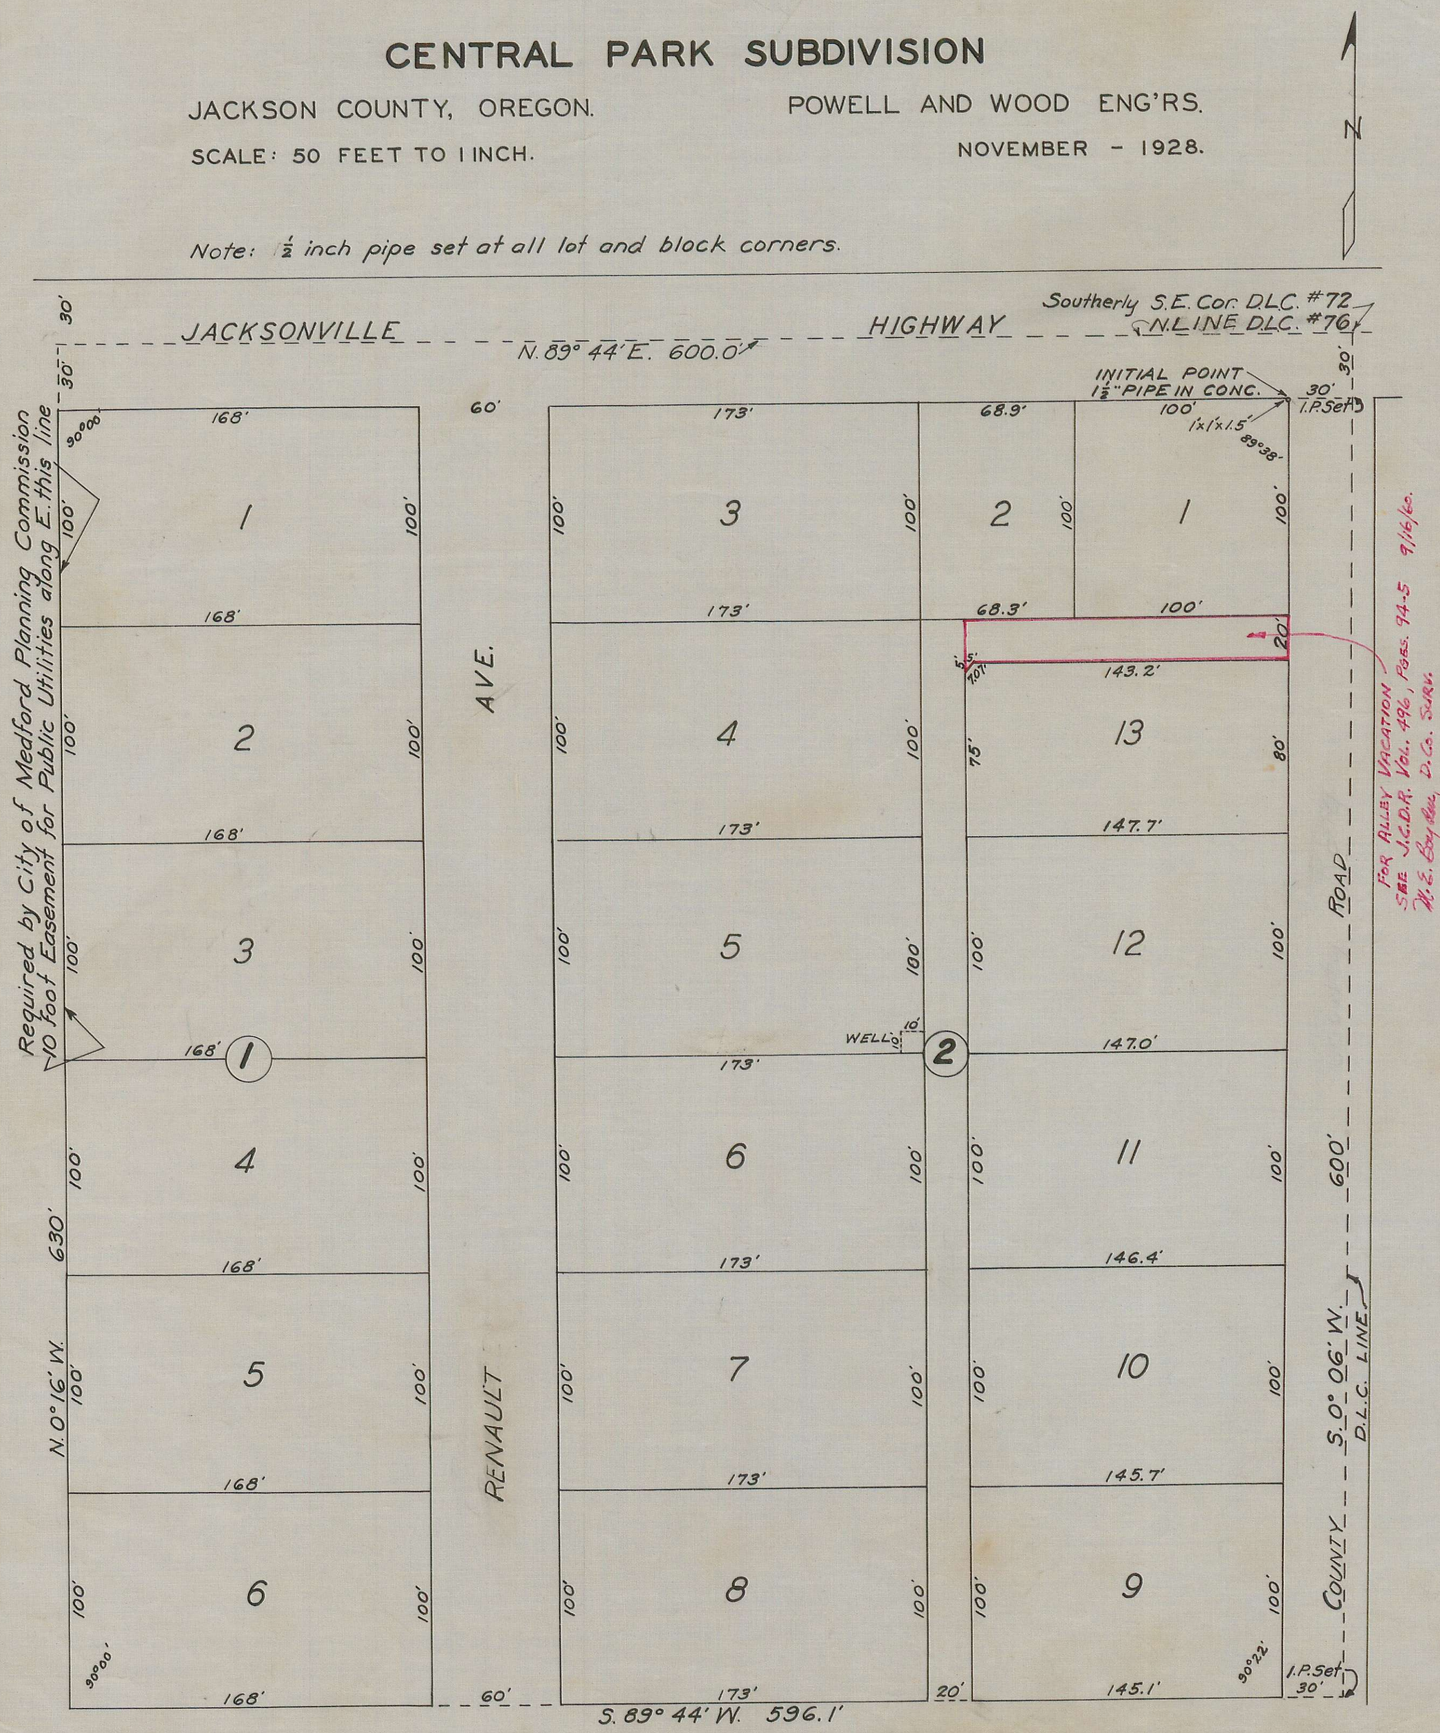

DESCRIPTION

Beginning at a point which is South 0°06' West 30.0 feet, and South 89°44' West 30.0 feet from the Southerly South East Corner of Donation Land Claim No. 72 in Township 37 South, Range 2 West of the Willamette Meridian and from said point running thence North 89°44' East 30.0 feet, thence South 0.06' West 600.0 feet; thence South 89°44' West 596.1 feet; thence North 0°16' West 630.0 feet; thence North 89°44' East 600.0 feet; thence South 0°06' West 30.0 feet; thence South 89°44' West 30.0 feet to the place of beginning.

DEDICATION

KNOW ALL MEN BY THESE PRESENTS, that I, Dora Harbaugh am the owner in fee simple of the tract as described hereon, and that I have subdivided the same into lots, blocks, streets, and alleys as shown hereon; that the number and size of the lots and the length of all lines are plainly set forth and this plat is a correct representation of said subdivision, that I do hereby dedicate to the use of the Public the streets and alleys as shown hereon and that I do hereby designate said subdivision as Central Park Subdivision.

In witness whereof I have hereunto set my hand and seal, this 28th day of December 1928.

J. B. Renault
Viola M. Templeton
Witnesses.

Signed Dora Harbaugh (SEAL)

STATE OF OREGON
COUNTY OF JACKSON S.S.

Personally came before me a Notary Public in, and for said County and State the above named Dora Harbaugh of said State and County to me personally known to be the above named and executed the above instrument and who acknowledged to me that she did the same freely and voluntarily.

Done this 28" day of December 1928

A. K. Hanna
Notary Public

My Commission expires January 7th 1929.

SURVEYOR'S CERTIFICATE

I, H.D. Powell, hereby certify that this map was made from notes taken during an actual survey in the field, and that this map is a correct representation of said survey, and that I have set the corners as hereon designated.

H. D. Powell
Surveyor.

Subscribed and sworn to before me this 12th day of January, 1929.

J. W. Satchfield
Notary Public.

My Commission expires Dec. 6th 1931

Examined and approved by the City of Medford Planning Commission in regular session this 10th day of December, 1928.

Secretary

Larry Schade
President.

Examined and recommended for approval of County Court.

Paul B. Running by C.Z.B. Beverly
County Surveyor

All taxes paid in full to date 19th Jan 1929

Ralph G. Grumings
County Sheriff

Examined and approved this 18" day of Jan. 1929

J. B. Coleman
County Assessor

For order of County Commissioners approving this plat, see Volume 21 page 267 of Commissioners Journal of Proceedings.

74963

Delia Stevens Meyer
County Clerk.

Filed for record this 24" day of Jan. 1929, at 9:30 o'clock A.M., and recorded in 5 Volume of Plats, Page 46 of Records of Jackson County, Oregon.

Delia Stevens Meyer
County Recorder.